


NOTE:
THIS LAYOUT IS PRODUCED ON THE BASIS OF
AN INTERNAL DIMENSION CHECK SURVEY.
ALL DIMENSIONS MUST BE CHECKED AND
VERIFIED ON SITE BY THE MAIN CONTRACTOR
PRIOR TO COMMENCEMENT OF ANY WORK OR
SHOP DRAWINGS.

REVISIONS

Rev.	Details.	Date.
Rev A	WR11521 - Meeting Rooms	22.03.17
Rev B	QA - SR11762	15.05.17
Rev C	QA - SR12424	21.09.17
Rev D	QA - SR13371	13.02.18
Rev E	QA - SR13447 - Code/Polylines	16.02.18
Rev F	QA - SR13540 - Code Updates	22.02.18

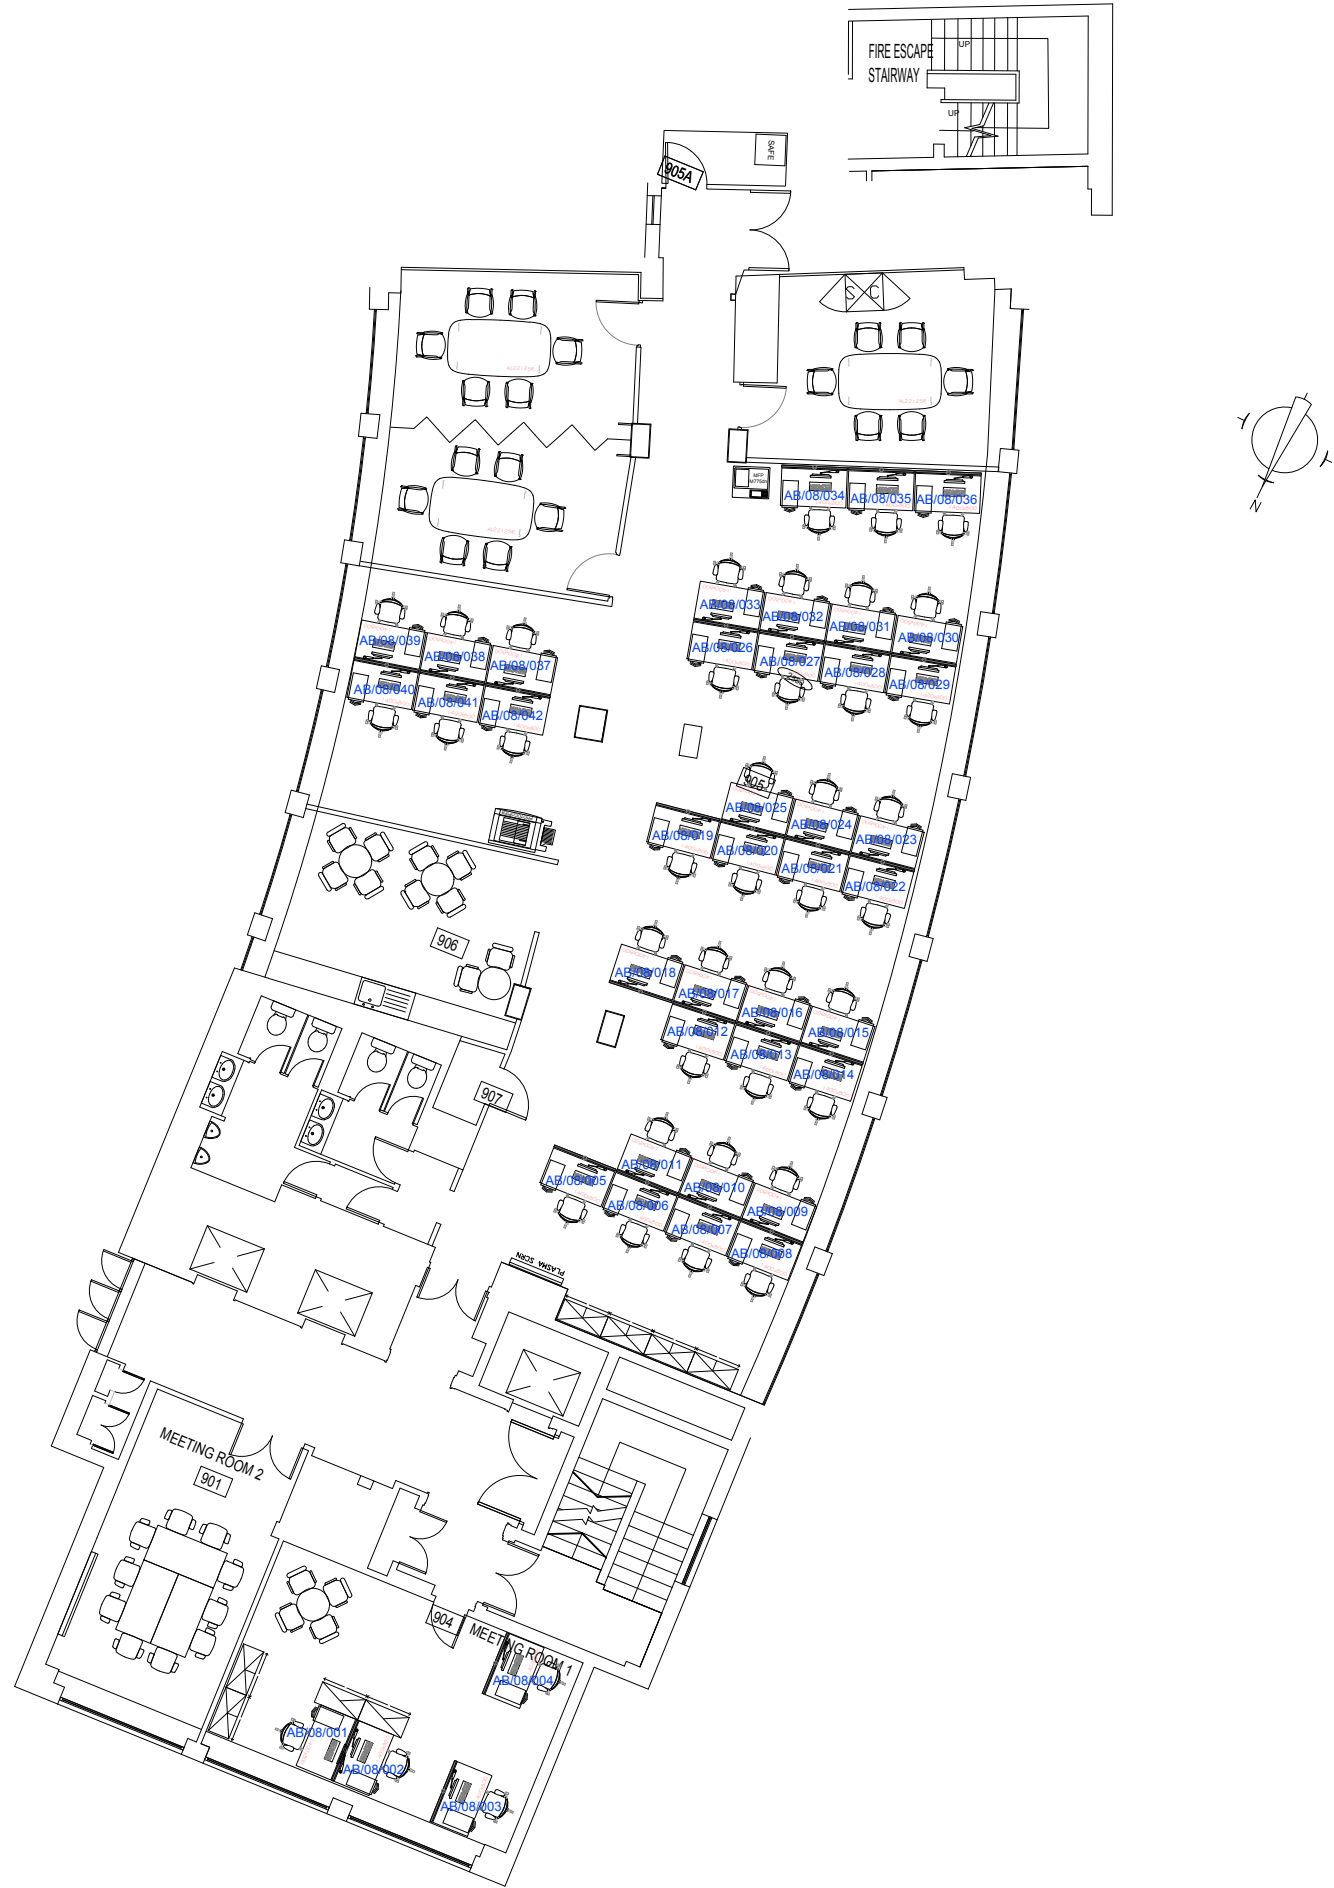

Transport for London

COMMERCIAL DEVELOPMENT
PROJECTS & ACCOMMODATION
PALESTRA
197 BLACKFRIARS ROAD LONDON SE1 8NJ

Drawing Title:
ALBANY HOUSE

Layout:
**EIGHTH FLOOR
AS BUILT LAYOUT**

Survey Date:	Surveyed By:	Date of Occu Survey:
Drawn By: --	Date: --	Scale: NTS
Checked By:	Date:	
Approved By:	Date:	

Drg. No. AB_08 TRIRIGA	Rev. 0
----------------------------------	------------------

