


- General Notes:
1. All dimensions to be verified on site prior to commencement of any working drawings or commencing work on site
 2. All drawings to be read in conjunction with structural engineer + M&E engineer's drawings and specifications
 3. Refer to acousticians report for partition DN requirements
 4. Refer to fire strategy report for fire strategy requirements
 5. Refer to RCP plans & lighting consultant package
 6. Refer to finishes plans for floor types
 7. Refer to wall finish & wall type plans for wall finishes & partitions
 8. Contractor to provide spacelab with materials for approval & sign off prior to construction
 9. For contravention to atrium see elevations
 10. Read in conjunction finishes, lighting & door schedules, & NBS specification

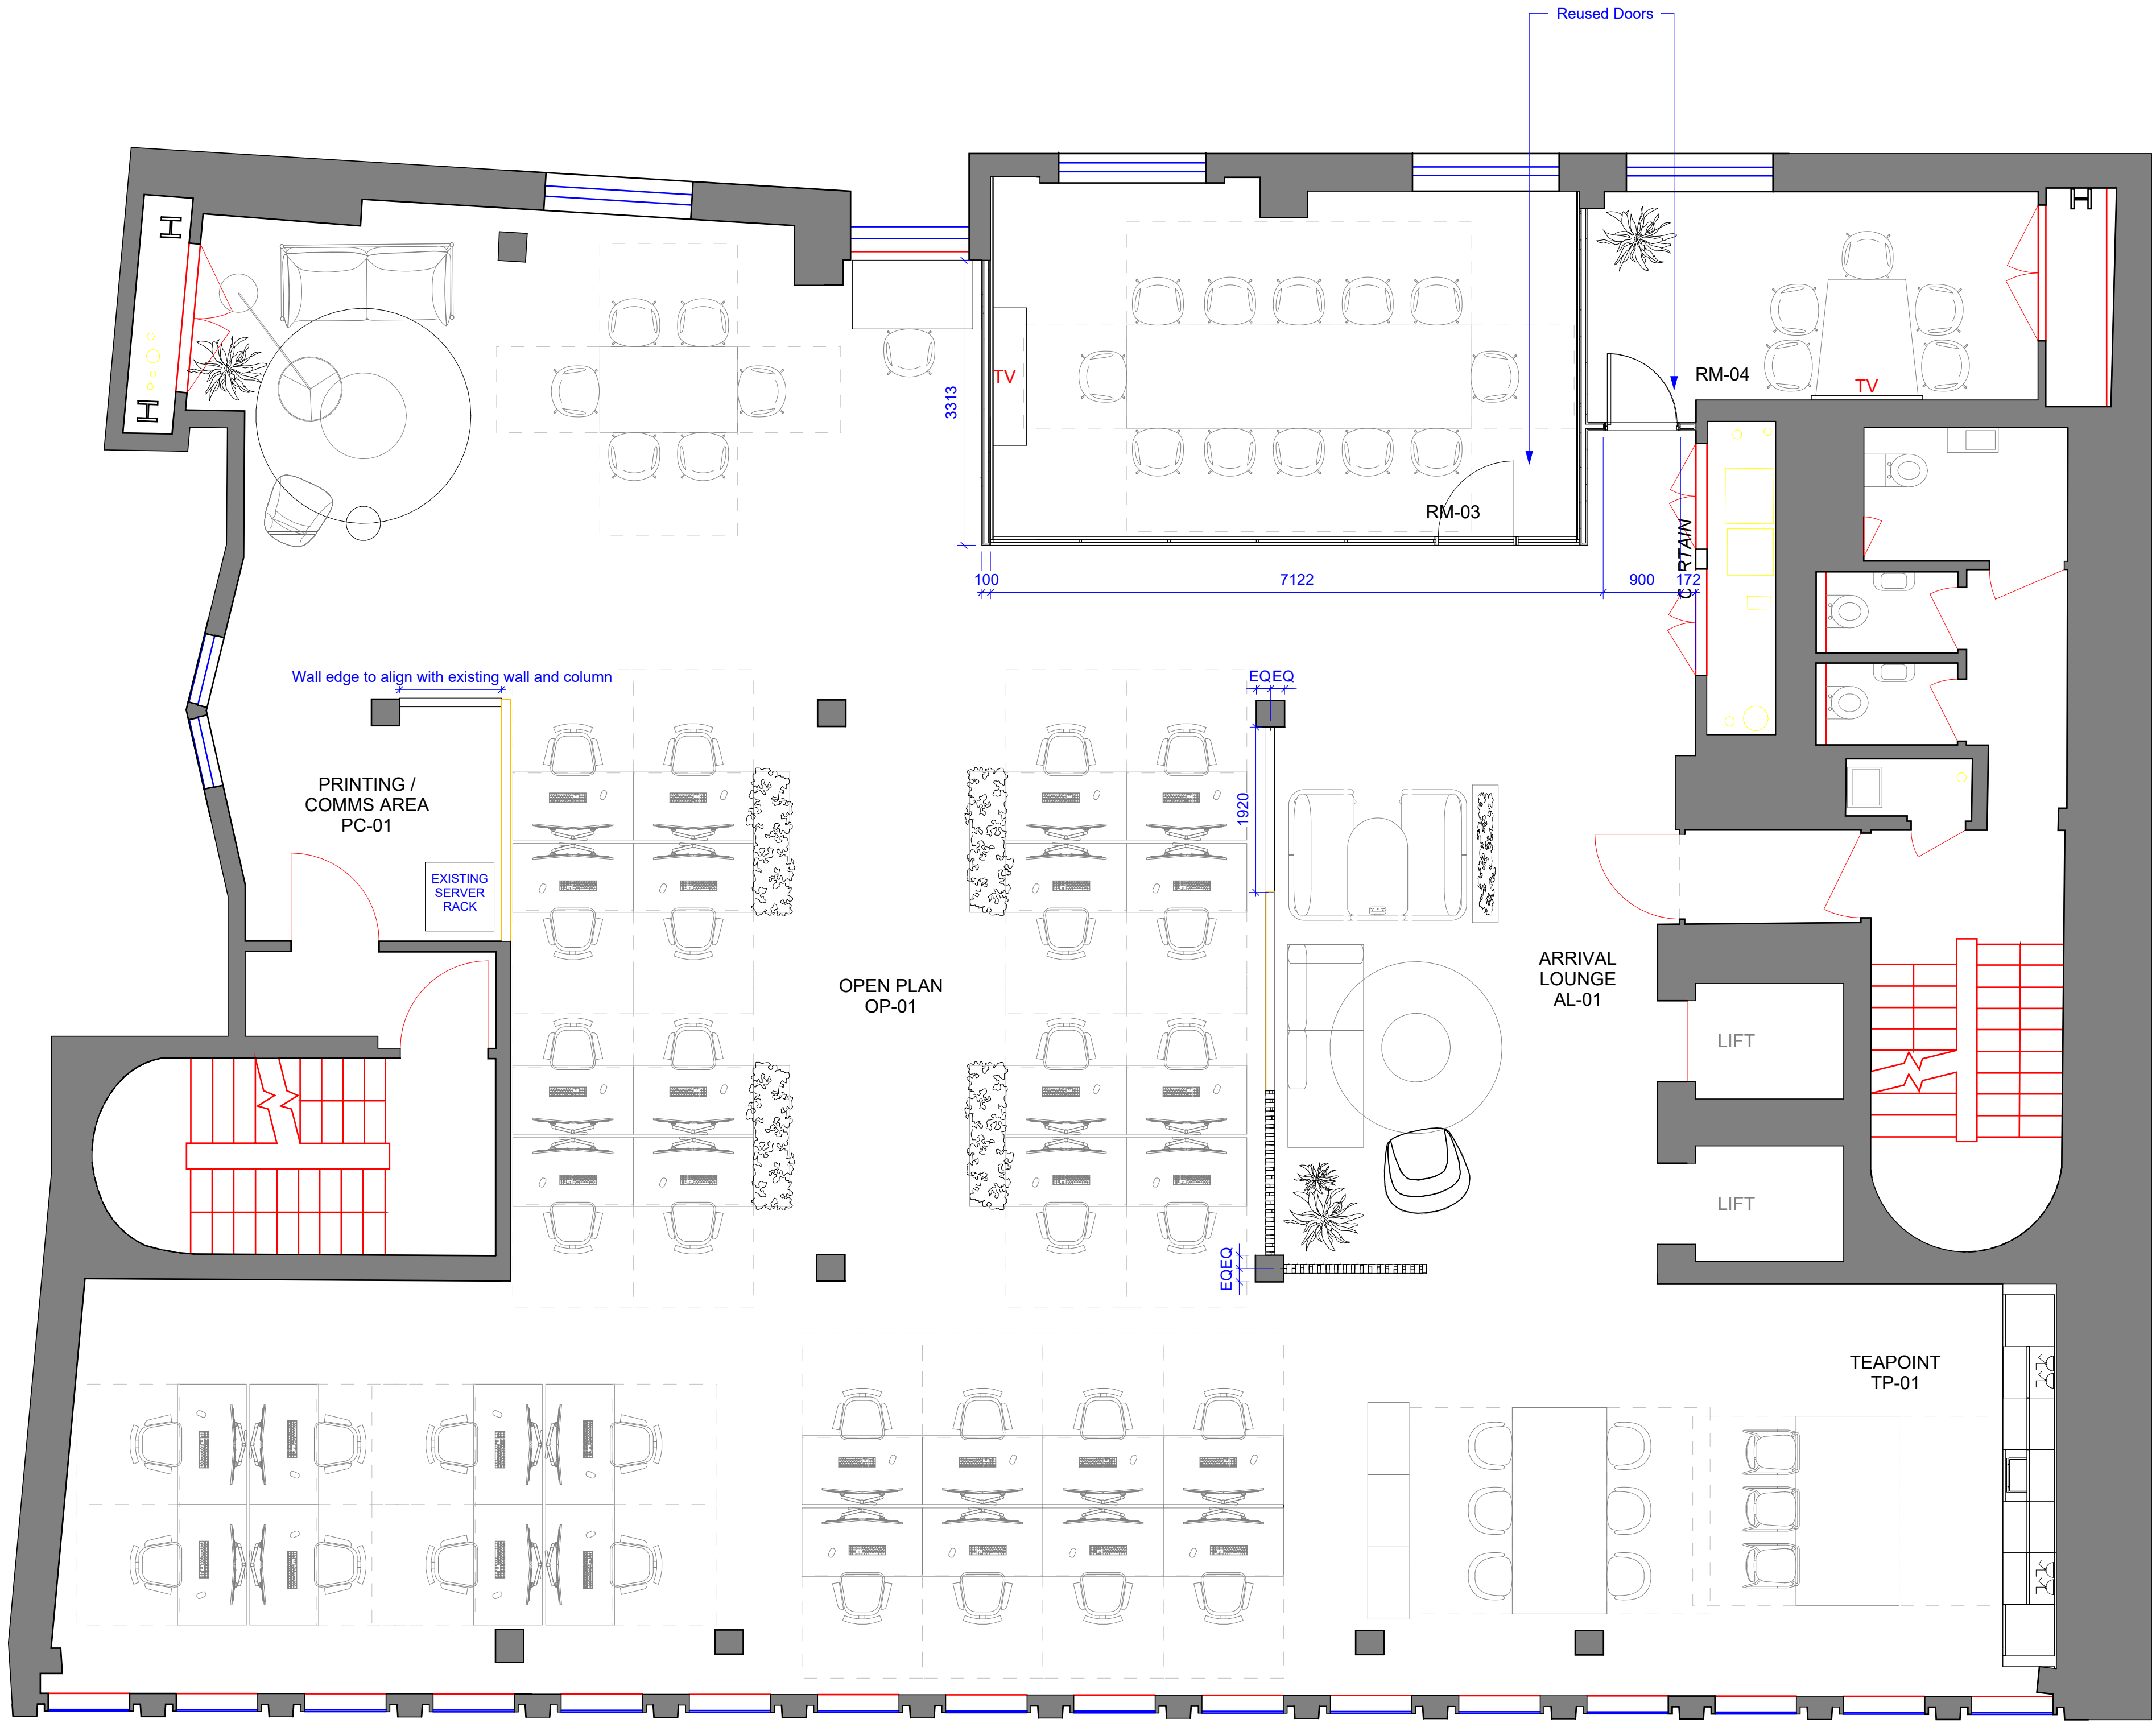

B	08.01.26	As-built	JB
A	31.10.25	Post Client Presentation	JB
Rev.	Date	Details	By

Client
Owner

Project Name
5 Norwich Street

Drawing Title
Proposed Plan GA

Status
AS-BUILT

Scale	Drawn by
As indicated@ A1	JB
Date	Checked by
29.10.25	RL
Drawing Number	Revision
2518 - GA - 1010	B

This drawing is copyright. Do not scale off dimensions.
All dimensions are to be checked on site by contractor.
Contractor to report any dimensional discrepancies, errors
or omissions prior to commencing in site.

