




This document should not be relied on or used in circumstances other than those for which it was prepared and for which Westridge was commissioned. Westridge accepts no responsibility for this document to any other party other than the person by whom it was commissioned. All setting out dimensions on drawings are to be confirmed on site, if there are any discrepancies then please notify Westridge for clarification.

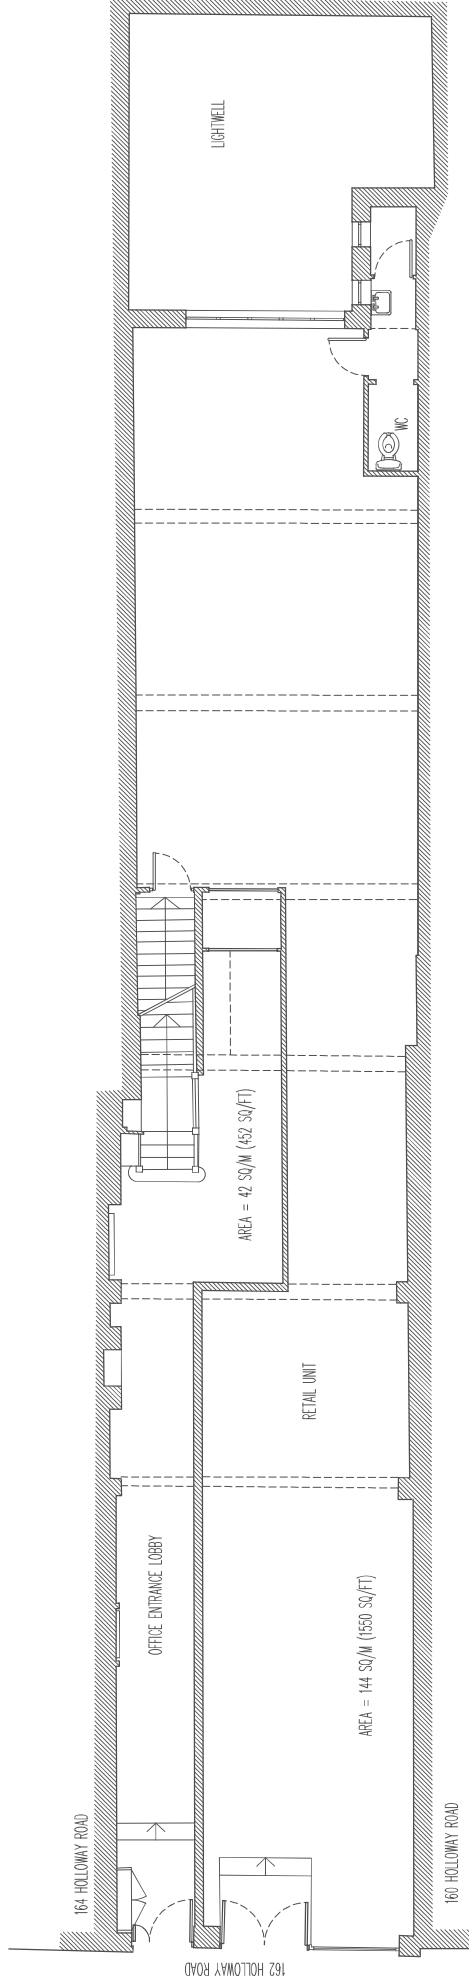

GROUND FLOOR

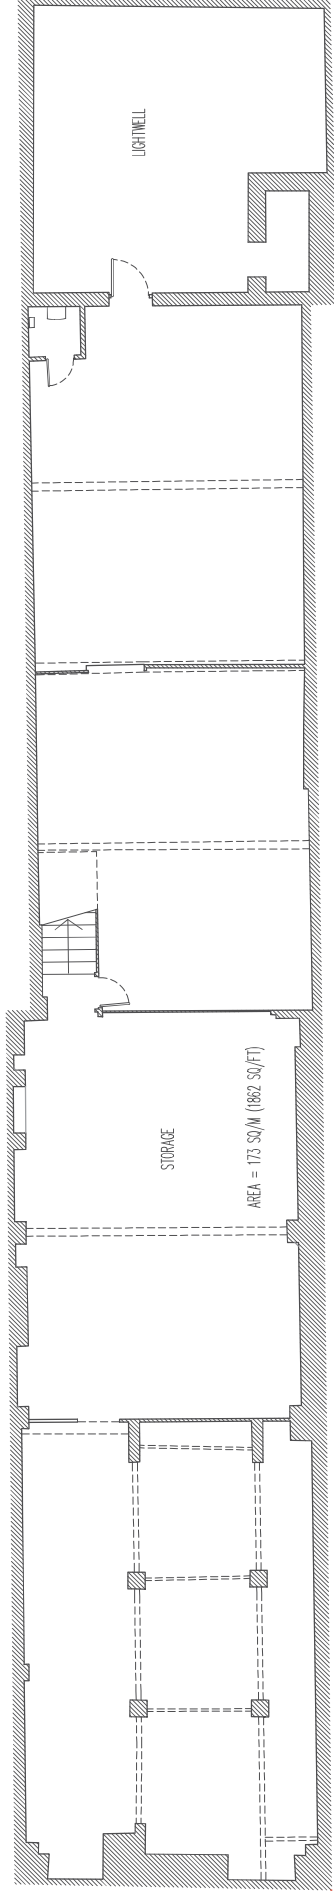

BASEMENT

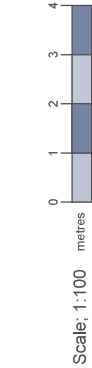

WESTRIDGE
Property Consultants Ltd
Design - Development - Project Management

Mill House, Mill Court
Great Shelford
Cambridge CB22 8LD
Tel: 01223 233 600
www.westridgeconsultants.co.uk

CLIENT: MAJESTY DEVELOPMENTS
PROJECT: 162 HOLLOWAY ROAD - LONDON

DRAWING: EXISTING BASEMENT & GROUND FLOORS	Job No: WPCJ.0546	Dwg No: CA-01	Rev: 0
Scale: @ A3 1 : 100	Date: October 2024		
AS-BUILT			

General Arrangement
DO NOT SCALE OFF THIS DRAWING