


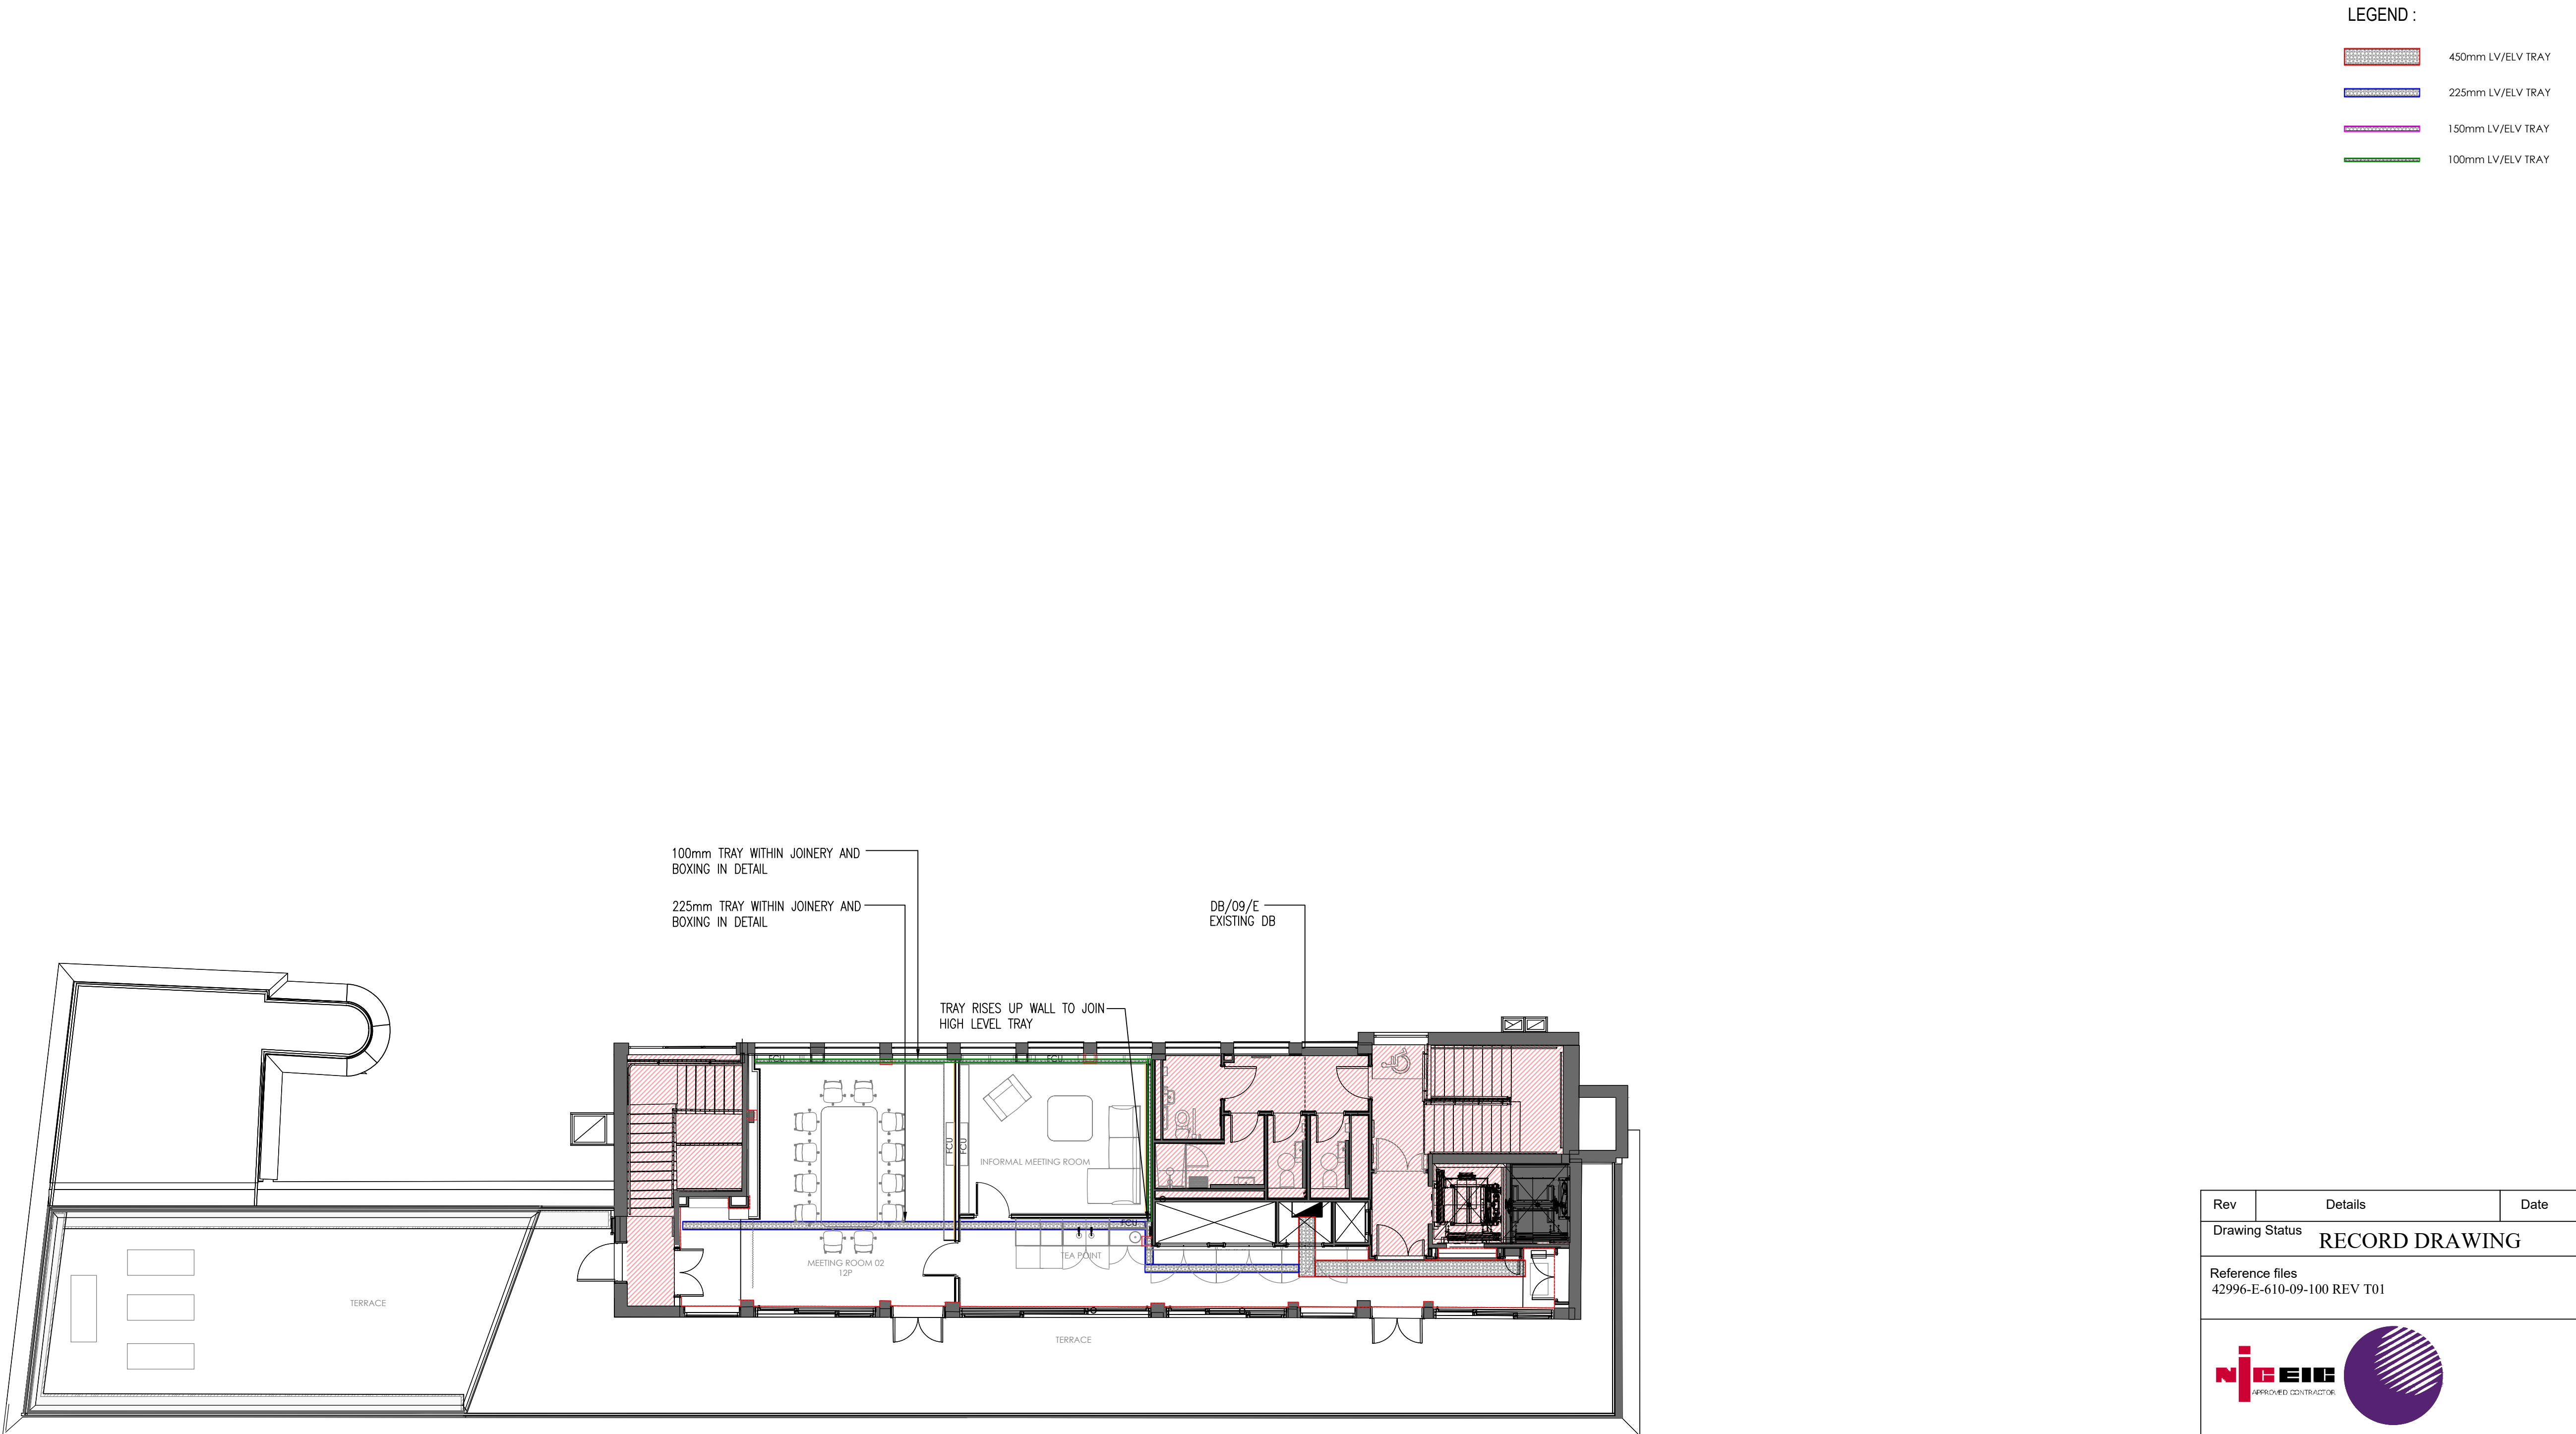

Rev	Details	Date
Drawing Status RECORD DRAWING		
Reference files 42996-E-610-09-100 REV T01		
Elite Electrical Contracting Limited Bank 30 Upper Mulgrave Road Sutton, Surrey SM2 7BD www.eliteelectrical.co.uk Tel: 020 8644 3200 Fax: 020 8644 3300		
Client QOB		
Project WINGATE HOUSE SHAFTESBURY AVENUE LONDON W1D 5BU		
Drawing 9TH FLOOR CONTAINMENT LAYOUT		
Scale 1:100@A1	Job No. J900	Date updated 01.08.2023
Drawn D.B	Checked S.P	
Drg No J900-CONT-09		Rev RD