


Denotes area out with scope of works

0 1 2 3 4 5m
Scale Bar @ 1:100

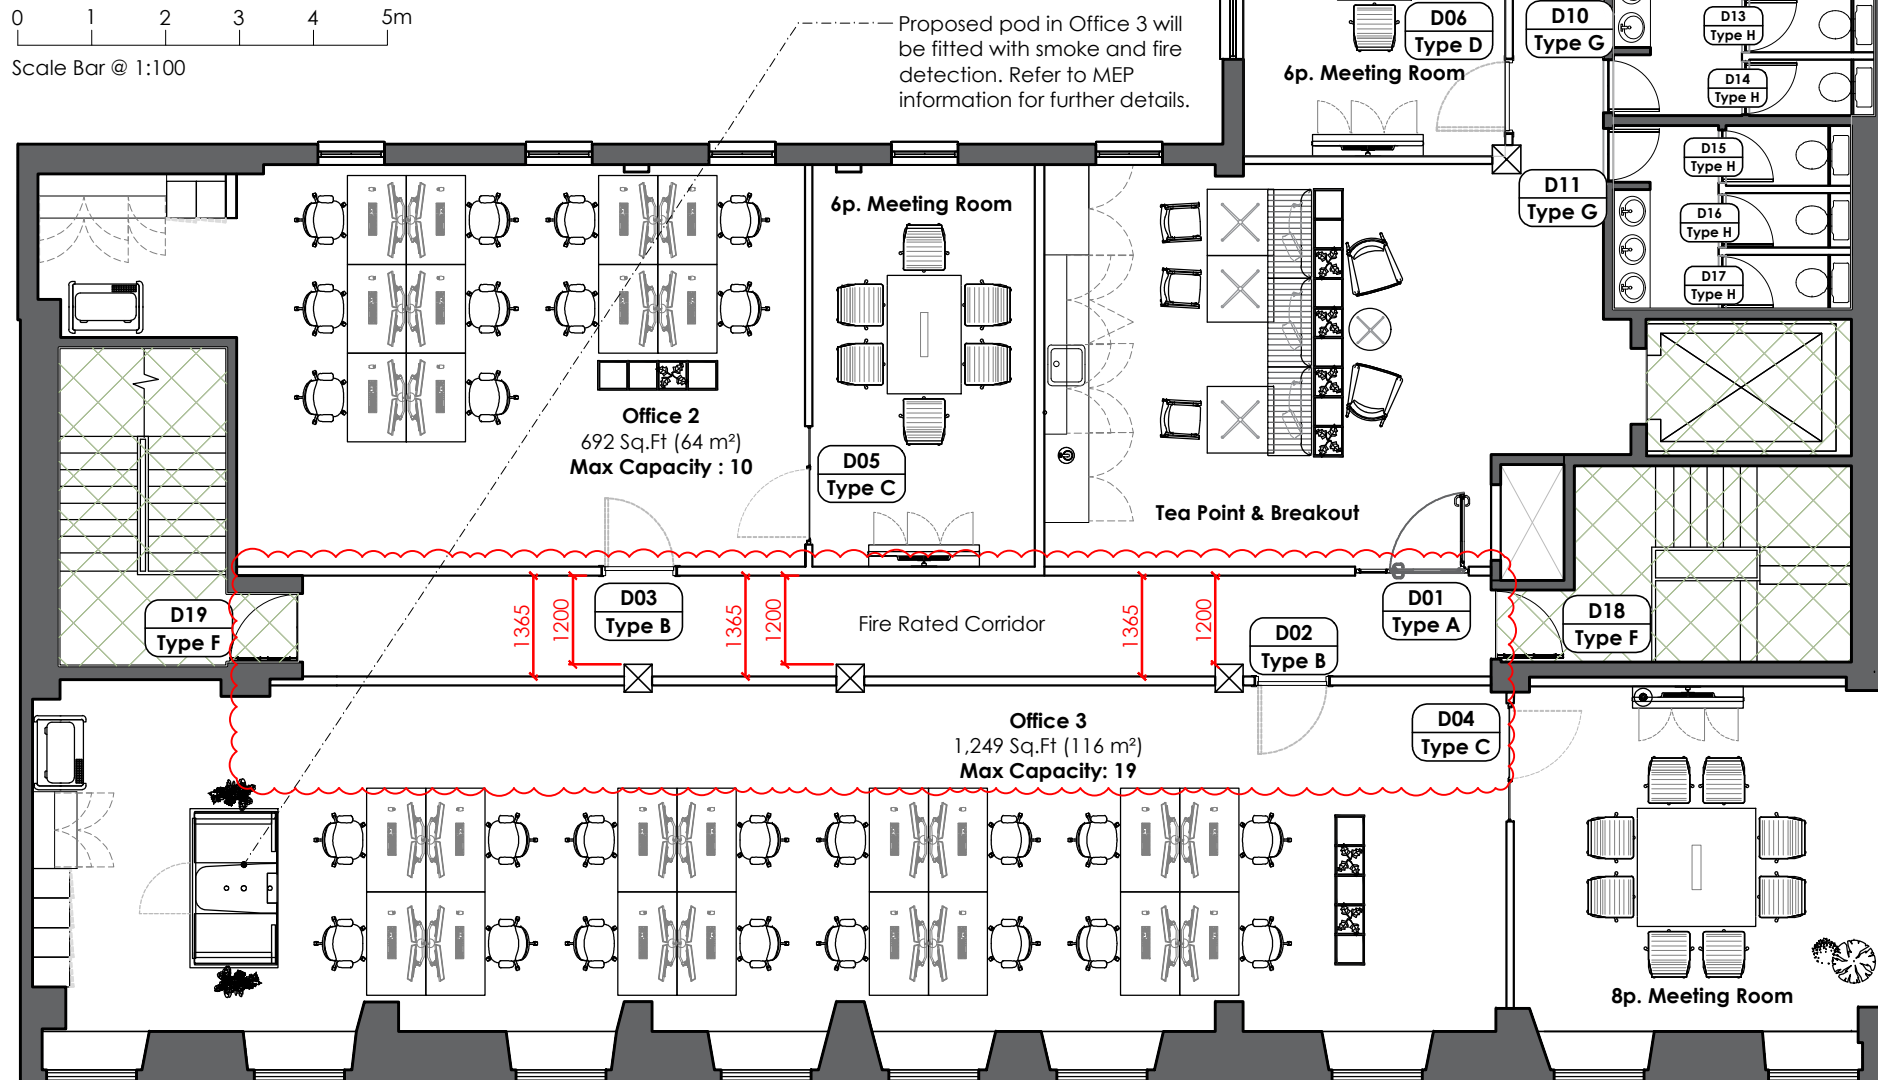

PROPOSED SECOND FLOOR GENERAL ARRANGEMENT PLAN @ 1:100

This drawing is the property of Form Design Consultants and should not be replicated without their permission. The Principal Contractor is responsible for the coordination of the construction on site. Contractors must verify all dimensions before commencing and seek clarification or notify Form Design Consultants if site discrepancies are noted. Contractors must not scale from this drawing.

Drawing Status

Information
Approval
Warrant
Planning
Tender
Contract
Construction
Record Drawing

Notes

Revision 4 08.06.26 By KM Ckd

Fire Corridor partitions adjusted to align with discussions with Interact.
Partition between Office 3 and corridor pushed towards centre of columns to create suitable fixing point at head.
Dimensions added to illustrate new dimensions in line with regulations.
Office 3 overall sizes increased with move of corridor.

Revision 3 19.05.26 By KM Ckd AS

Layout updated. Shower has been omitted from scope and AWC adjusted to required sizes. Office partitions adjusted to align with entrance.
Office 1 overall SQFT. and SQM. increased.

Revision 2 08.05.26 By KM Ckd --

Construction Issue.

Revision 1 15.01.26 By KM Ckd --

Layout amended as per VE discussions. All meeting room glazing updated. Fire Rated door and screen updated.

Revision 0 19.11.25 By KM Ckd --

Tender Issue.

Client

Ryden,
215 Bothwell Street,
Glasgow, G2 7EZ

Project

Second Floor Refurbishment
250 West George Street,
Glasgow, G2 4QY

Title

Second Floor General
Arrangement Plan

Scale	Date
1:100 @ A3	12.11.25
Drawn by	Checked by
KM	--
Drawing No.	Revision
13690.00.02	4

FORM Workplace Design Consultants

27/2 George Street
Edinburgh EH2 2PA
+44 (0) 131 602 7003
www.formdc.com