


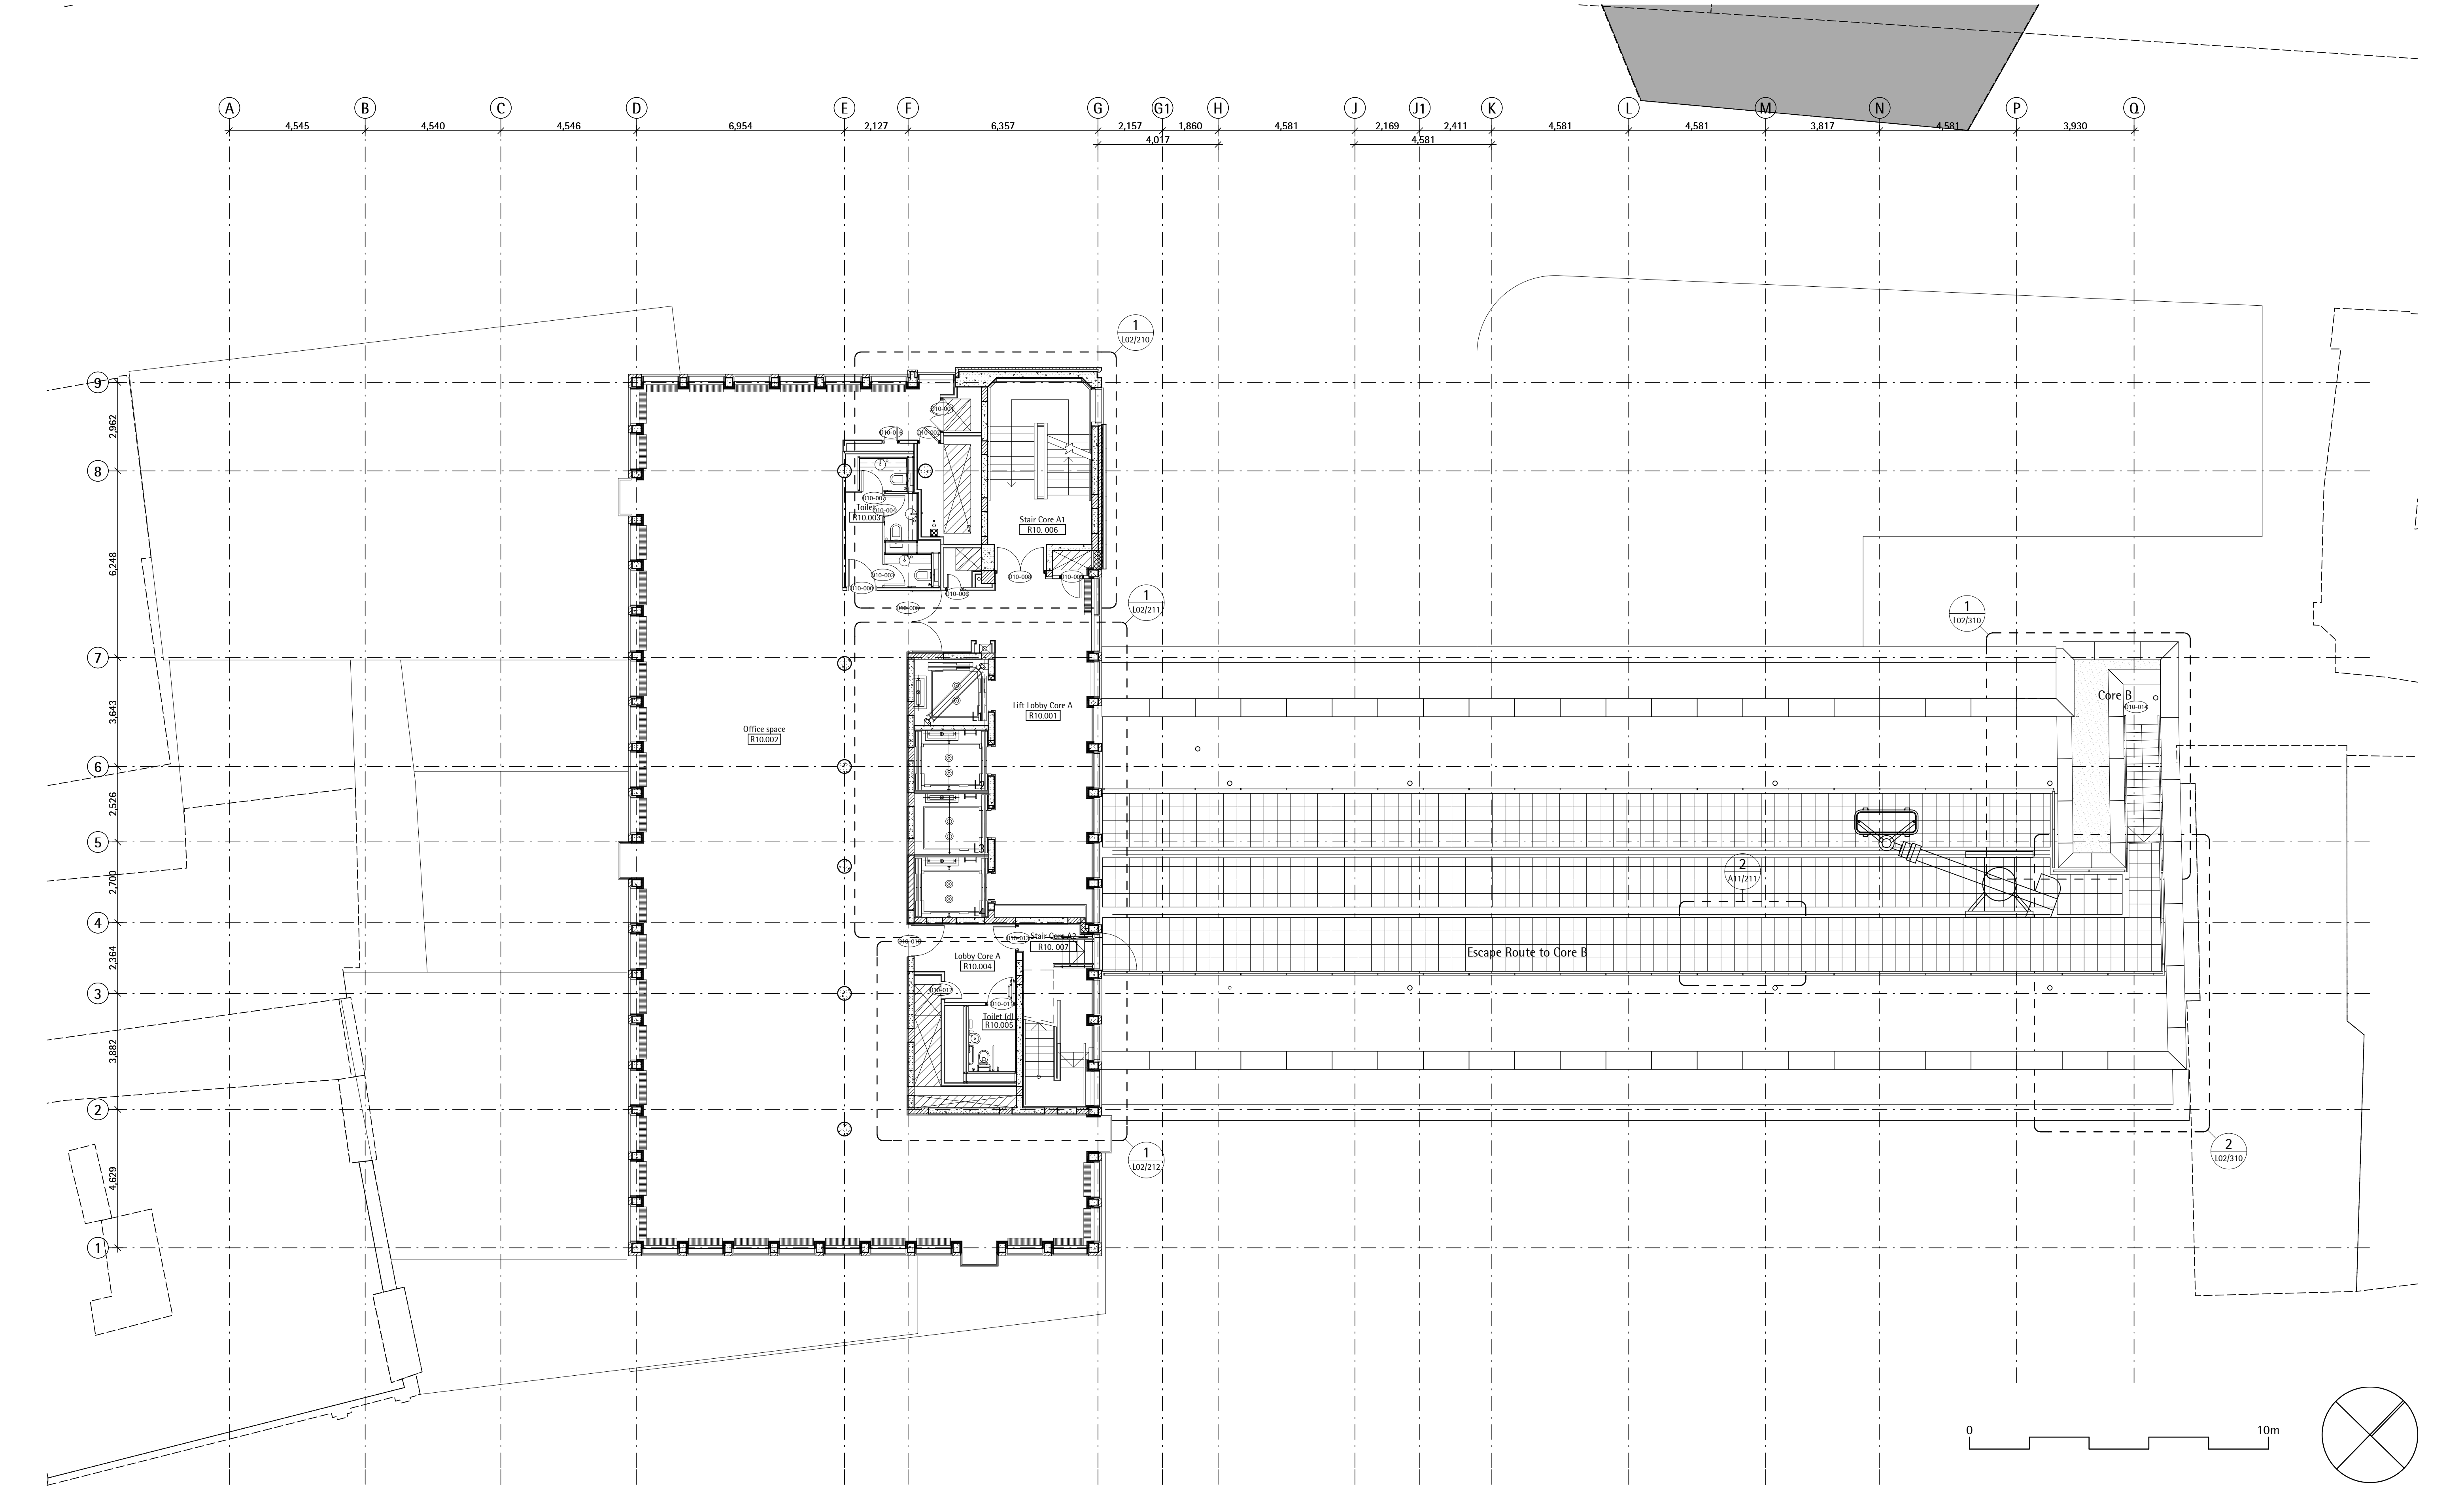

Notes:

Do not Scale from this drawing Use figured dimensions only

| Rev. | Date     | Dwn    | Description                                                                                                                   |
|------|----------|--------|-------------------------------------------------------------------------------------------------------------------------------|
| P1   | 26/01/07 | cm     | For Information                                                                                                               |
| P2   | 06/02/07 | rb     | Stage D Issue                                                                                                                 |
| P3   | 31/05/07 | cm     | General Update: Changes to Core A toilet layout, Parker St extension layout & structural update to reflect survey information |
| P4   | 29/06/07 | ik     | Structural Grids and West Wing cladding updated to survey                                                                     |
| P5   | 17/07/07 | kc     | Issued for Tender                                                                                                             |
| P6   | 15/08/07 | cm     | Door and Room Numbers Added. Cores A & B Partitions Updated.                                                                  |
| P7   | 26/09/07 | ts, ik | Issued for Tender - Metalwork Package. Balustrades & Copings revised. Mansafe s system added to Podium roof                   |

| Rev. | Date     | Dwn | Description                                                                                                                                                             |
|------|----------|-----|-------------------------------------------------------------------------------------------------------------------------------------------------------------------------|
| P8   | 06/11/07 | mw  | Issued for Tender - Amend toilet Layout                                                                                                                                 |
| C1   | 11/01/08 | mw  | Issued for Construction                                                                                                                                                 |
| C2   | 14/05/08 | mw  | General Update- Revised Roof finishes & Balustrades location, Core A&B updated                                                                                          |
| C3   | 05/08/08 | mw  | General Update- Balustrade updated in accordance with EAI 010, Core A dry riser l location, door label and toilet layout amended and Core B layout and coping u updated |
| C4   | 16/09/08 | sd  | Unisex Toilet updated. Accessible Toilet handed. Coping layout to top of Core B r revised. Detail Marker 2/L02/310 added.                                               |
| C5   | 08/09/09 | pk  | Updated to as built                                                                                                                                                     |

Henderson Global Investors

4 Broadgate  
London EC2M 2DA  
Tel: 020 7818 1818  
Fax: 020 7818 5670

AS BUILT

John Robertson Architects

111 Southwark Street, London. SE1 0JF  
Telephone 020 7633 5100. Facsimile 020 7620 0091

Holbrook House Great Queen Street London, WC2

Tenth Floor Plan

Drawing Status: Record Drawing

| Scale(s):   | Date:       | Drawn:    | Checked: |
|-------------|-------------|-----------|----------|
| 1:100@A1    | 21/04/2006  | arp       |          |
| Project No: | Drawing No: | Revision: |          |
| 1590        | L01/110     | C5        |          |