



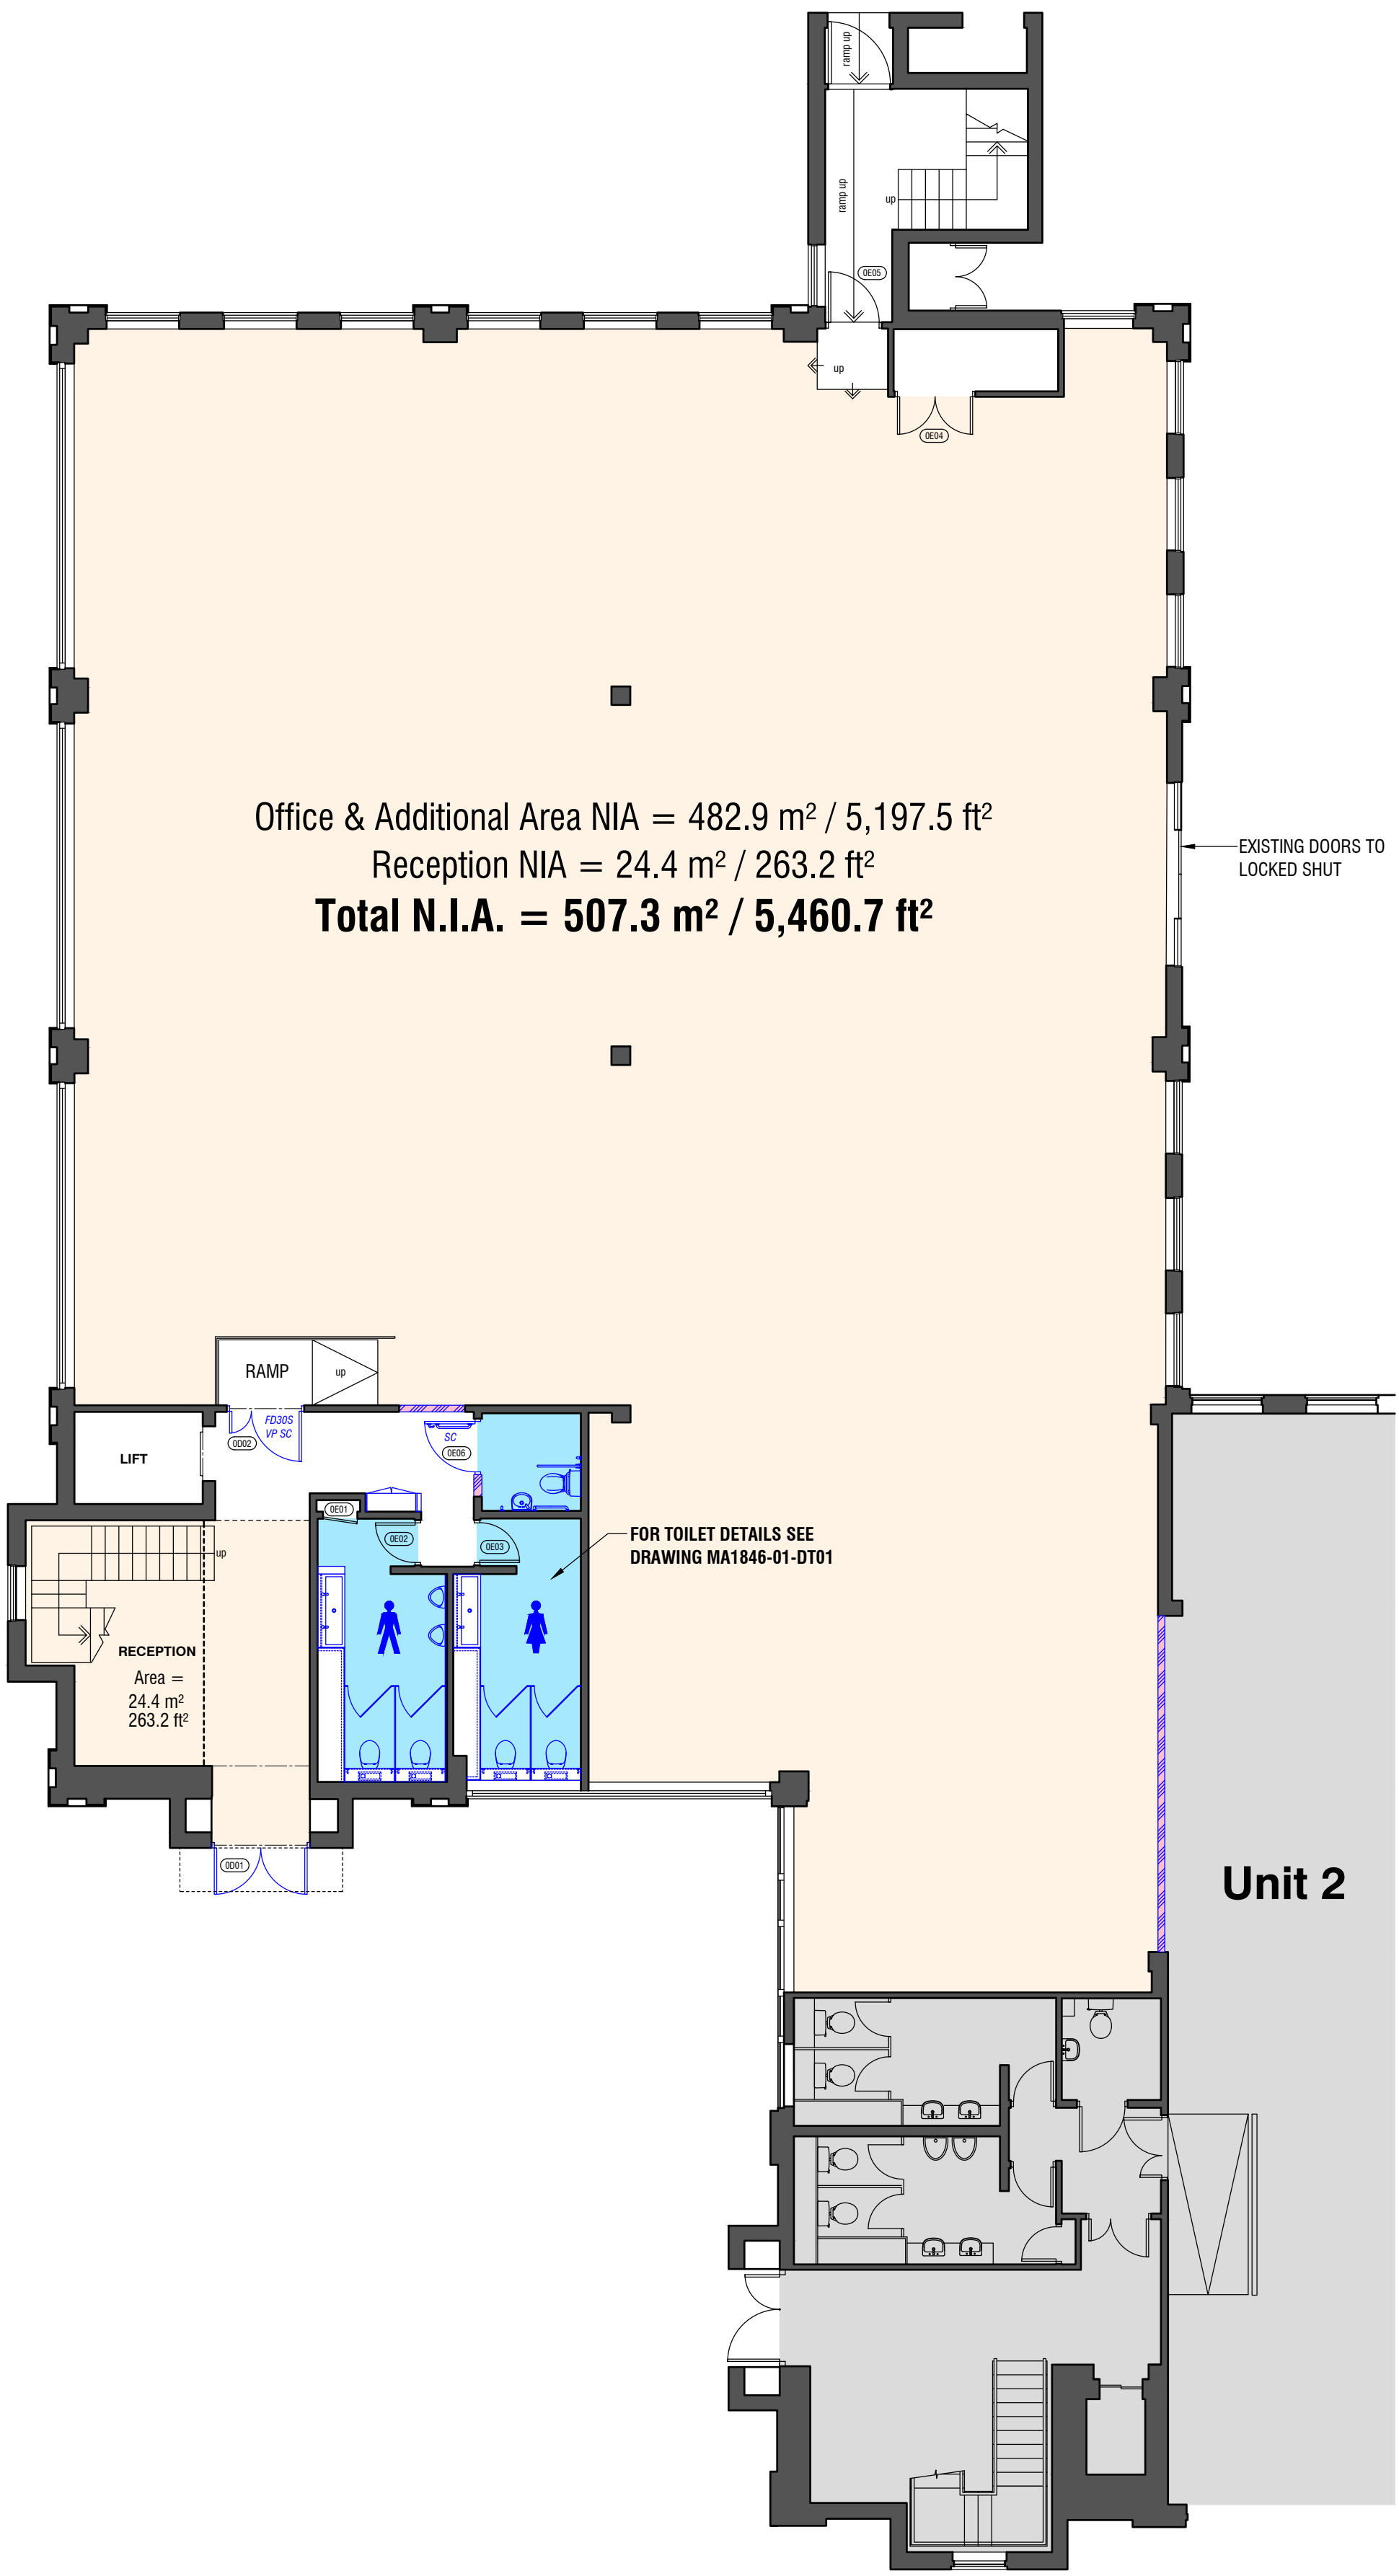

Ground Floor

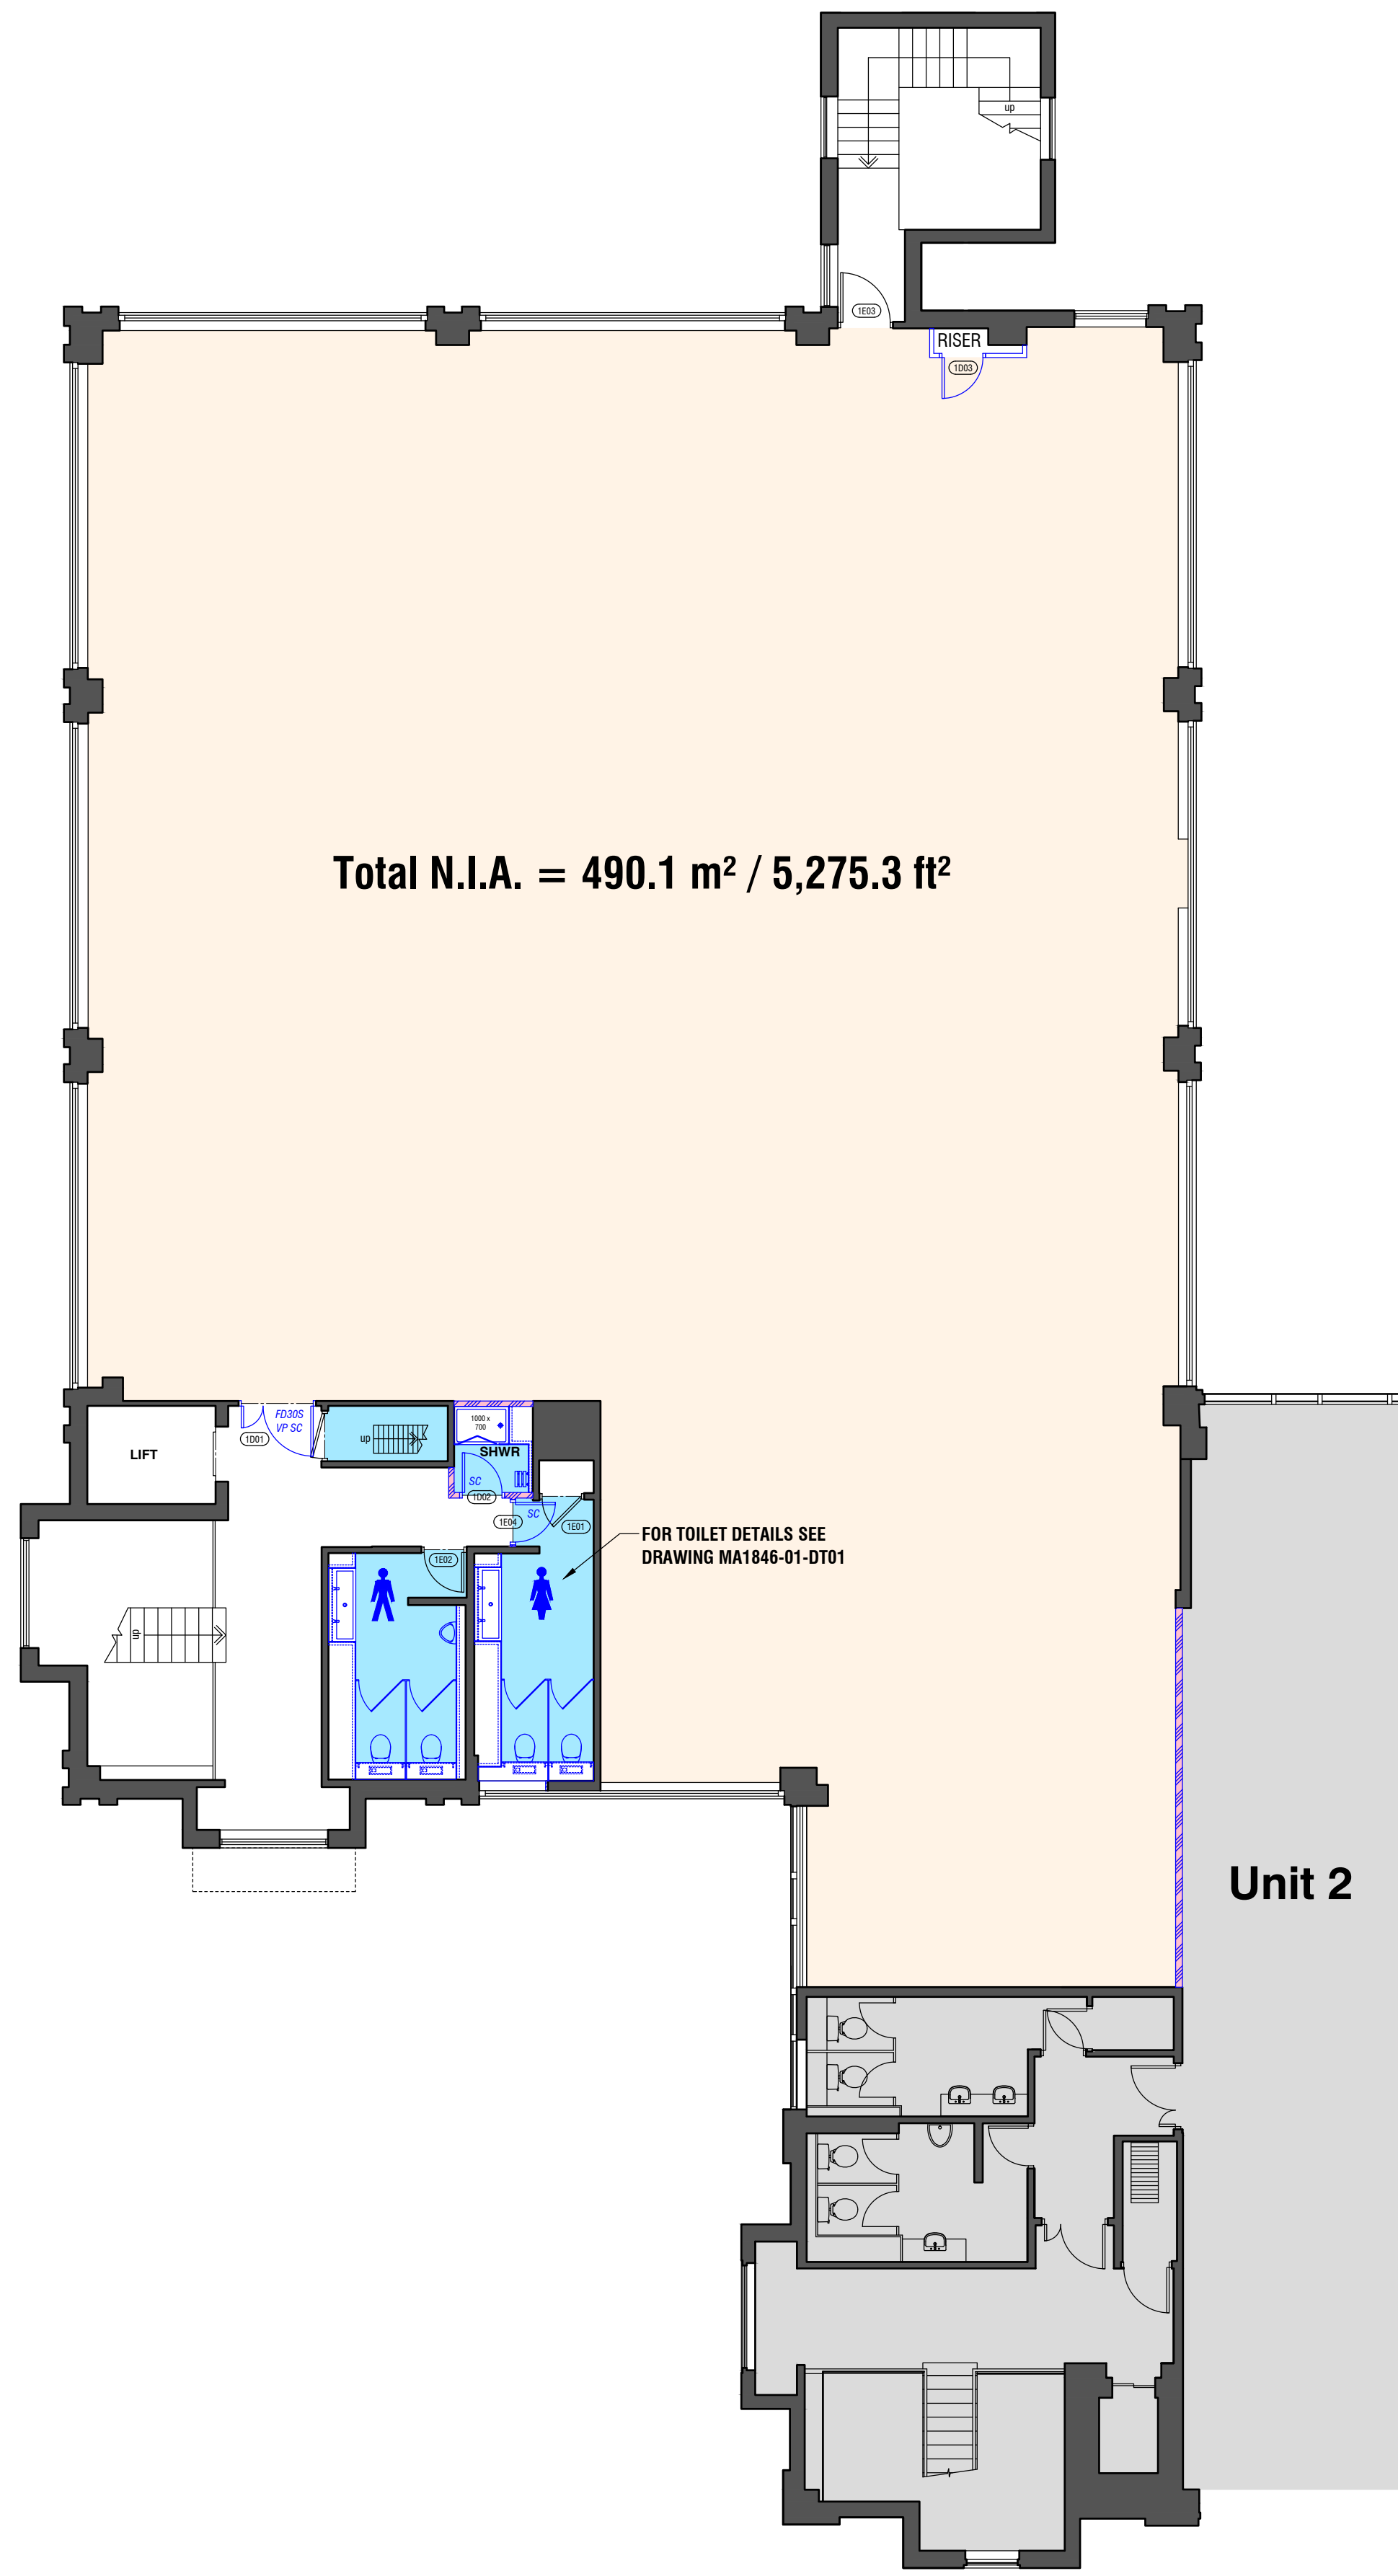

First Floor

This drawing is protected under Copyright and at no time must any portion of this drawing be reproduced or copied in anyway without the permission of Morgan Lovell.

All dimensions must be checked on site and NOT scaled from this drawing.

G	RECORD DRAWING.	SB	12.10.15
F	INFORMATION FROM SK02 INCORPORATED INTO MAIN DRAWING. CONFIRMATION OF DEMISE LOCATION.	SB	21.09.15
E	FURNITURE OMITTED FROM RECEPTION. FIRE ALARM PANEL LOCATION INDICATED.	SB	31.07.15
D	NEW RISER ADDED TO 1st FLOOR.	SB	21.07.15
C	CONSTRUCTION ISSUE.	PC	10.07.15
B	TOILETS UPDATED TO REVISED DETAIL.	SB	23.06.15
A	CLIENTS COMMENTS INCORPORATED FROM MEETING HELD ON 10.06.15. EXISTING EXTERNAL DOORS TO BE LOCKED SHUT. SHOWER ROOM RELOCATED. TOILETS REVISED - SEE DETAIL DRAWINGS.	SB	10.06.15
Rev	Revision	By	Date

RECORD DRAWING

Morgan Lovell

MAXIS 1 Western Road Bracknell Berkshire RG12 1RT
T: 0134 435 3800 E: contact@morganlovell.com
W: http://www.morganlovell.com

Client
AEW

Project
**UNIT 1
ELSTREE GATE
ELSTREE WAY
BOREHAMWOOD**

Title
**GROUND & FIRST FLOORS
GENERAL LAYOUT**

Scale	Date	Designer/Drawn By	Checked By / Date
1:100@A1	26/05/2015	SMKB	

Drawing Number			
Project No.	Floor	Drawing No.	Rev
MA1846	01	100	G