


EXISTING STEP DOWN
DETAIL DOES NOT
ALLOW ACCESS

DOOR TO BE LOCKED
OFF, DEADBOLT &
PADLOCK

WINDOW TO BE
BOARDED OVER

NO ACCESS

PHASE 03

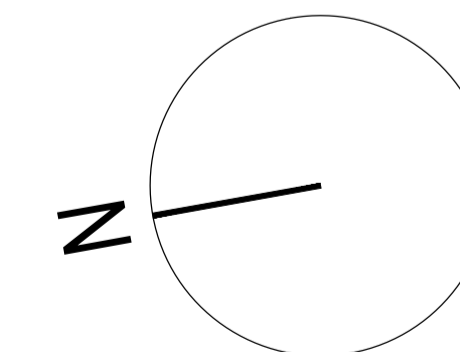

GENERAL NOTES

1. RISER DOORS: TO BE REDECORATED ONLY
2. RAISED ACCESS FLOOR: TILE REPLACEMENT TO OCCUR WHERE NECESSARY IN LINE WITH COST PROPOSAL
3. EXISTING SKIRTING: TO BE REDECORATED ONLY AND MISSING SECTIONS REPLACED WHERE WALLS ARE REMOVED
4. ACCESS CONTROL & INTRUDER ALARM: TO REMAIN AS PER EXISTING BASEBUILD. NO WORKS ALLOWED
5. CEILING GRID: REMOVE DAMAGED TILES AND REPLACE WHERE NECESSARY ONLY

NOTES: DO NOT SCALE FROM THIS DRAWING.

- THIS DRAWING REQUIRES:
- CLIENT APPROVAL
 - LANDLORD APPROVAL
 - BUILDING CONTROL APPROVAL
 - FIRE OFFICER APPROVAL

© COPYRIGHT WORKPLACE FUTURES GROUP 2021

REV	BY	DATE	DESCRIPTION
A	AM	04.08.21	FIRST ISSUE
B	AM	11.08.21	FURN AND FLOORING ADDED
C	TS	17.08.21	CONTRACT ISSUE
D	TS	08.09.21	DESK DIMENSIONS ADDED
E	TS	02.12.21	AS BUILT

MODUS:

Gordon House
Greencoat Place
London SW1P 1PH

T: +44 20 7828 9009
info@modusgroup.com
www.modusgroup.com

CLIENT:
LONDON & ORIENTAL

SITE ADDRESS:
107 LEADENHALL

PROJECT No. **6042W** FLOOR **05** REV. **E**
SCALE: **1:50@A1** DRAWN BY: **TOM SHAW** DATE: **08.09.2021**

AS - BUILT
DRAWING TITLE FIFTH FLOOR SPACE PLAN
SHEET NUMBER A-101-SP-05