


IMPORTANT NOTES :
 All dimensions shown are assumed and must be checked and verified on site by (sub) contractor(s) prior to design, procurement, fabrication and installation of any and all items. All information shown is indicative of design intent and should not be used for setting out purposes.
DO NOT SCALE OFF THIS DRAWING
 All information herein is subject to building control approval.
 All information on this drawing must be read in conjunction with all other project documentation, including but not limited to, suppliers orders, bills of quantities, CGI visuals and specifications.
 All drawing information to be checked and approved by Building Regulations Approved Inspector prior to procurement, fabrication and installation/construction.
 All visuals presented on this drawing are purely indicative.

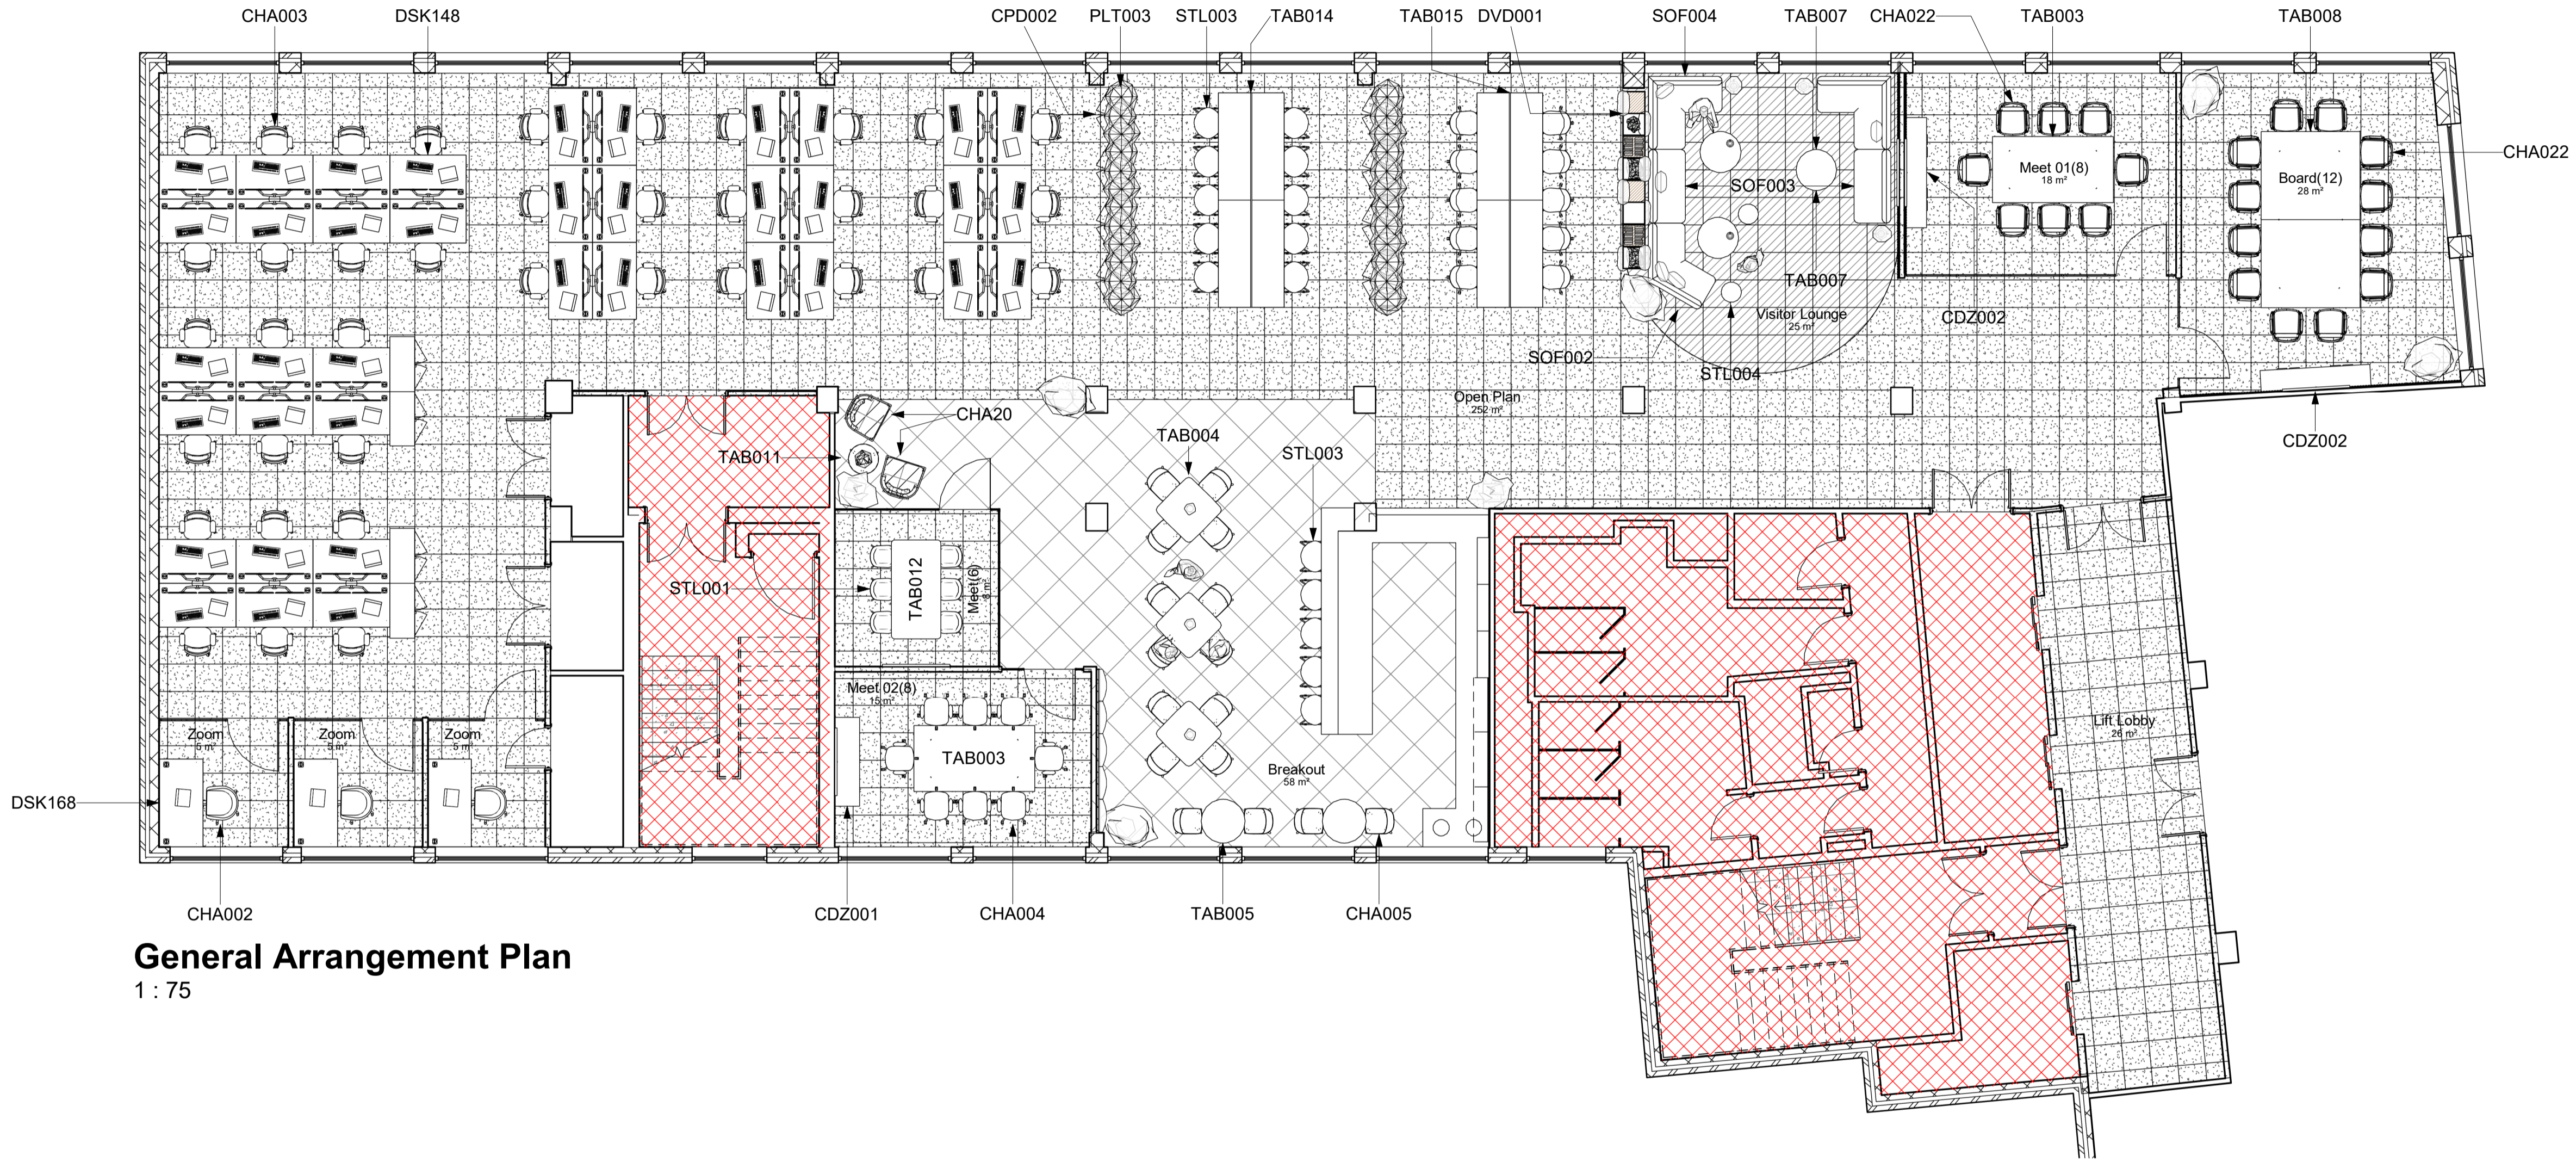

General Arrangement Plan
 1 : 75

L901 Desk Schedule			
Level	Type Mark	Description	Count
Level 9	DSK148	Rectangular Desk 14/8 Static	38
Level 9	DSK168	Rectangular Desk 16/8 Static	3
			41

IMPORTANT NOTE :
 Internal planting indicated on drawings/visualisations is representational. Planting design, specification, supply and installation are excluded from Inside Ltd's scope and pricing.

Rev.	Description	Date	By
Issue:	AS BUILT		
Client:	belshaw.		
Site Address:	Edmund House, 10-12 Newhall St, Birmingham B3 3EF		
Title:	General Arrangement Plan (9th Floor)		
Date:	16.09.25	Scale:	1 : 75
Job No:	P0332	Floor No:	L9
Dwg No:	L901	Revision:	(AB)