





KEY plan

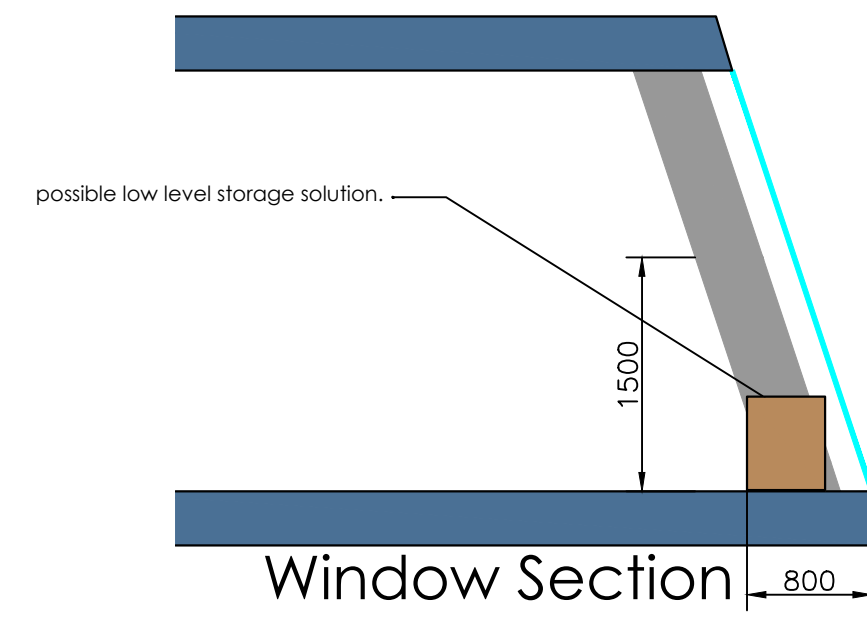


FLOOR AREAS

Total floor area = 343 sqm = 3692 sqf

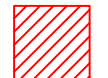 Floor Area = 180 sqm = 1938 sqf

 Floor Area = 26.2 sqm = 282 sqf

Remaining area = 136.8 sqm = 1472 sqf

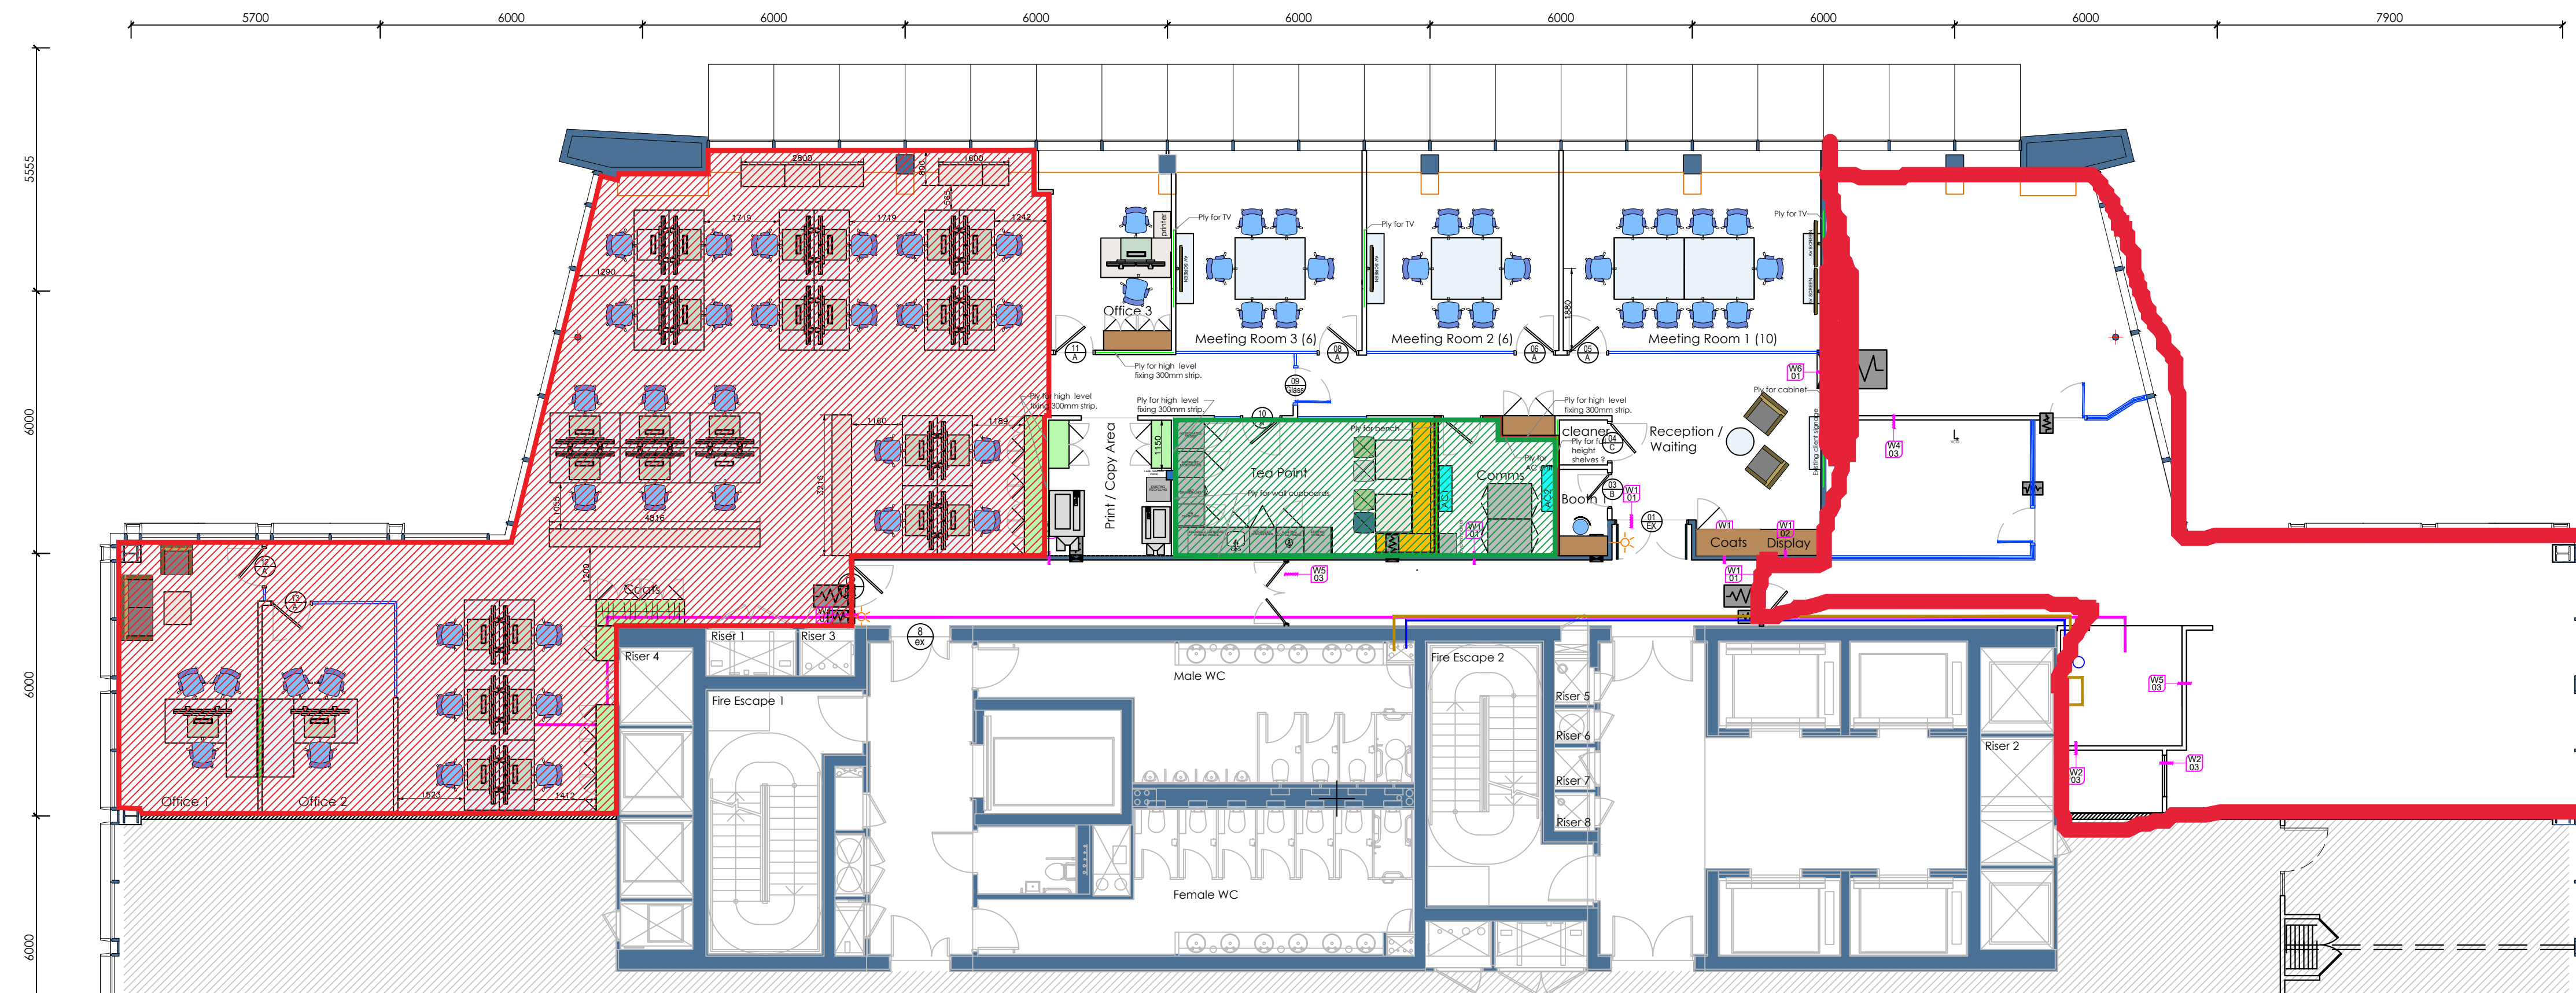

THIS DRAWING REMAINS THE PROPERTY OF BASE INTERIORS LTD. IT MAY NOT BE COPIED OR REPRODUCED WITHOUT EXPRESS WRITTEN CONSENT. FIGURED DIMENSIONS SHOULD BE USED WHERE GIVEN. DO NOT SCALE.



CLIENT
6th Floor
10 Portman Square
Mayfair, London
W1H 6AZ

SITE ADDRESS
As Built 6th Floor

DRAWING TITLE	
KRS 503 PROJECT NO.	6 001 DRAWING NO.
1:200 A3 1:100 A1 SCALE	General DESCRIPTION
AV DRAWN	23-01-20 DATE
T. 020 7487 3222 F. 020 7487 3555 BASEINTERIORS	

BASE
15 BERKELEY MEWS LONDON W1H 7AX

LAYOUT SUBJECT TO
LOCAL AUTHORITY APPROVALS

KAİROS - AS BUILT 6TH FLOOR
GENERAL LAYOUT