
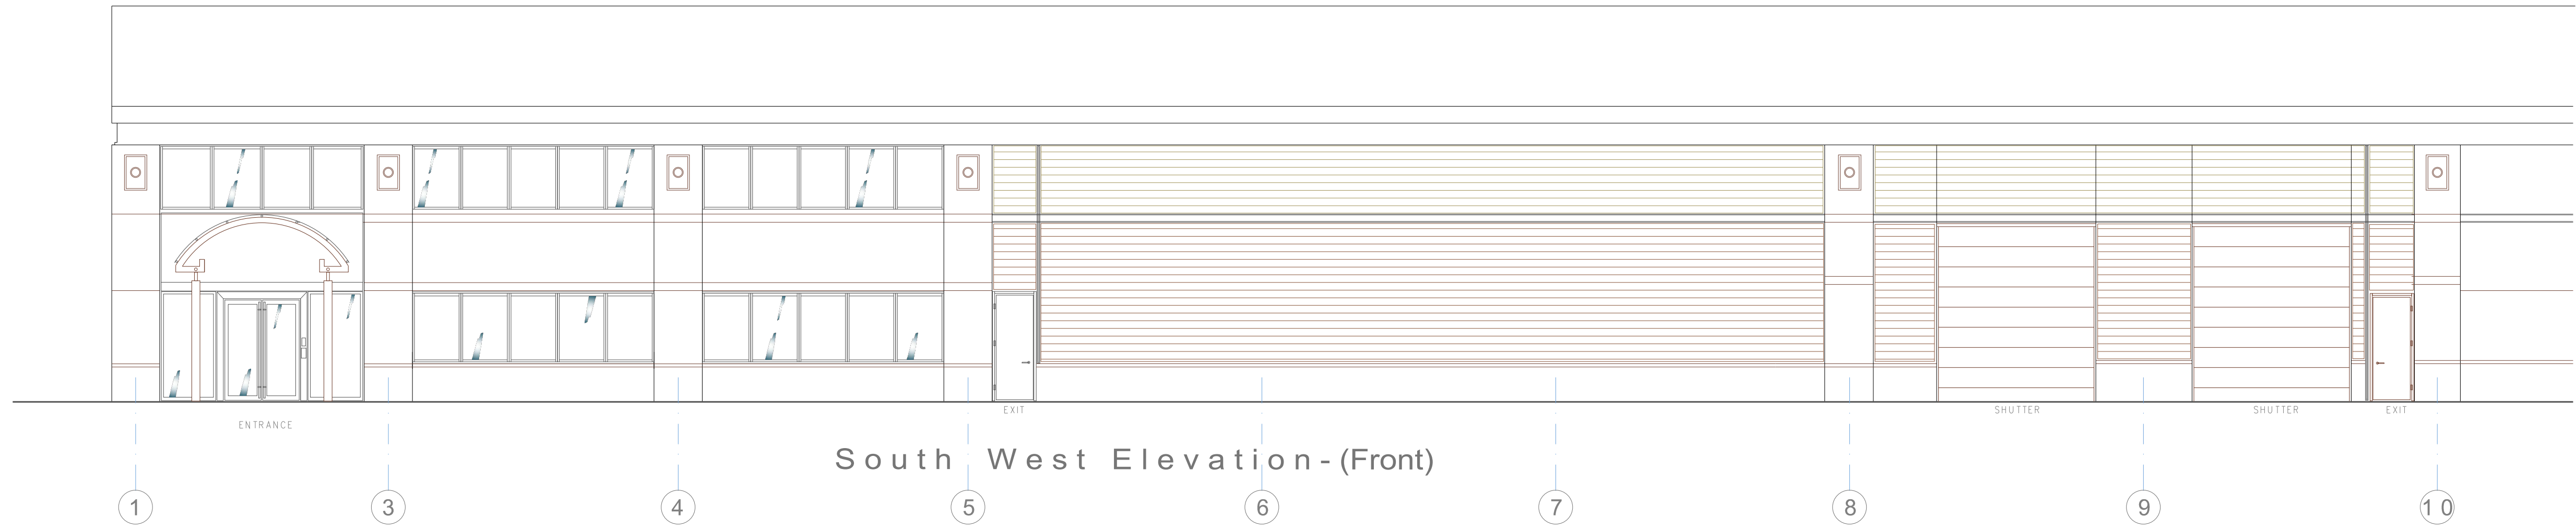


AS BUILT

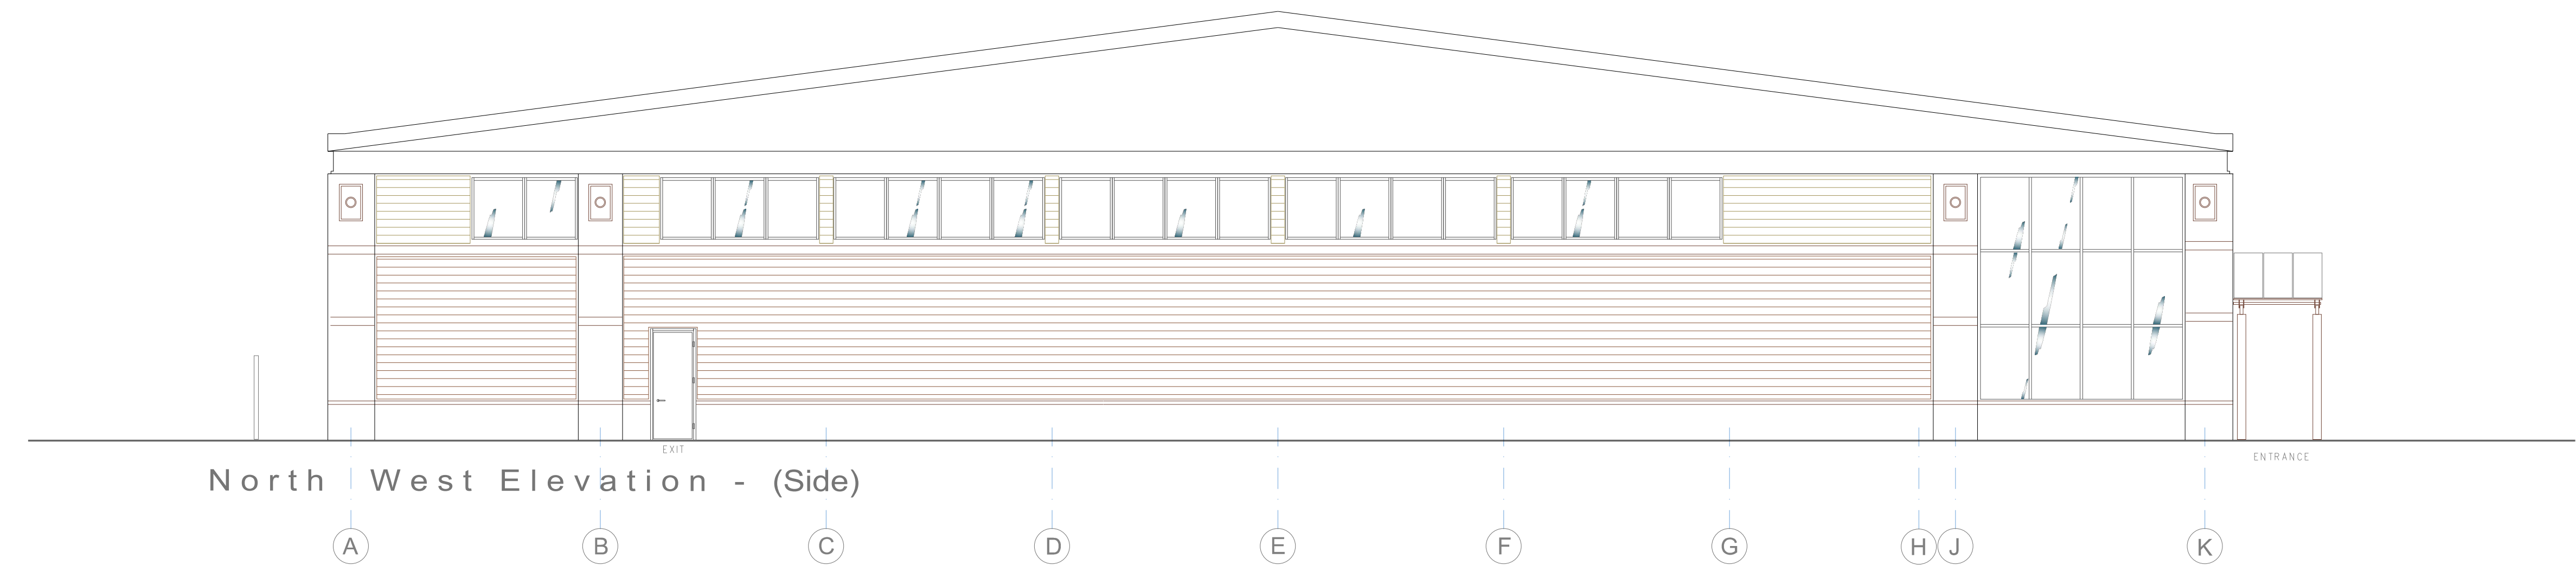

UNIT B1,
Parkway Trading Estate
Heston, TW5 9QA

Rev	Description	Date	By	Chk'd
 JLL				
<i>Real value in a changing world</i>				
4 Longwalk Stockley Park Uxbridge Middlesex UB11 1FE T +44 (0)20 8759 4141 F +44 (0)20 8897 4731 www.joneslanglasalle.com				
Client		Scale 1:100 @ α1		
Project		Date 07 JULY 26		
UNIT B1 PARKWAY TRADING ESTATE HESTON TW5 9QA		By PJ	Checked	
Description		Job		
AS BUILT ELEVATION		UNIT B1, PARKWAY WEST		
		Drg B1.ELE.AB.11	rev	

DO NOT SCALE THIS DRAWING. CHECK ALL DIMENSIONS ON SITE

DO NOT SCALE THIS DRAWING. CHECK ALL DIMENSIONS ON SITE