


UNIVAR SOLUTIONS

BRADFORD - 1st FLOOR - AS BUILT

NOTE

This drawing is produced for use in this project only and may not be used for any other purpose. Richard James accepts no liability for the use of this drawing other than the purpose for which it was intended in connection with this project.

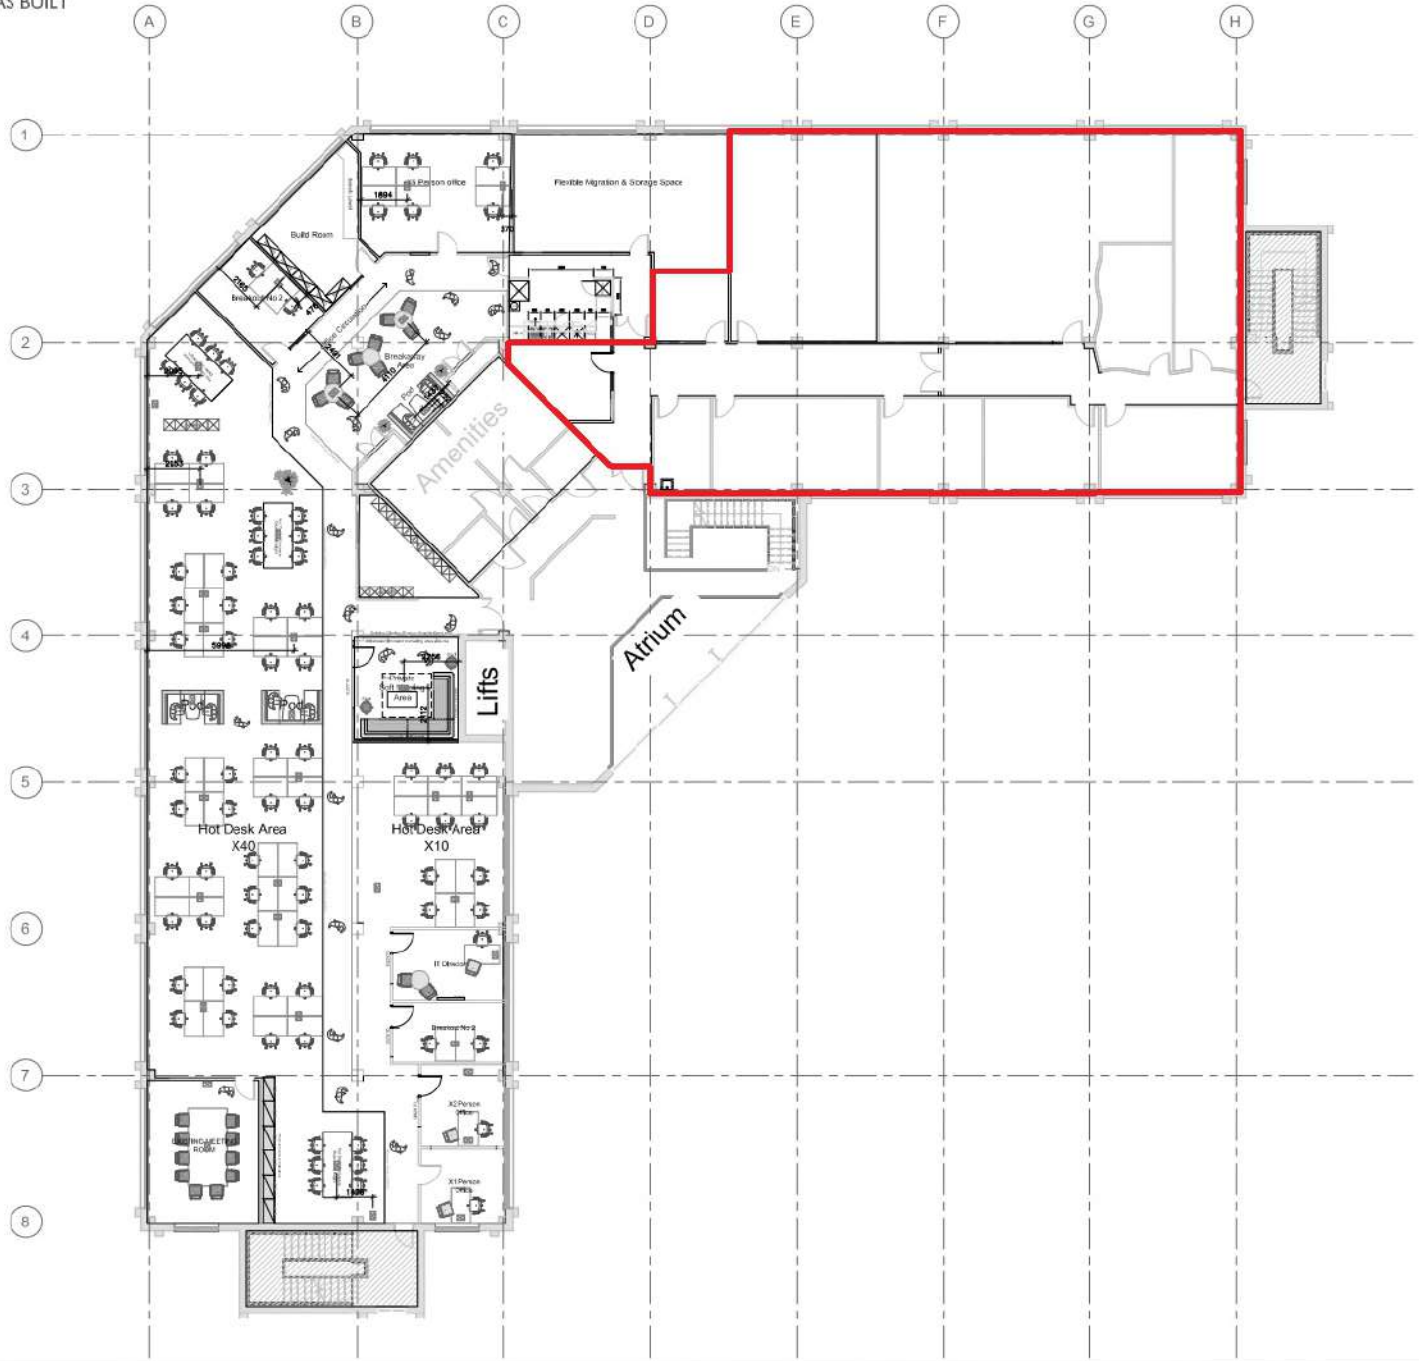

RICHARD JAMES

CLIENT

UNIVAR SOLUTIONS
BRADFORD

DRAWING TITLE

1st Floor
AS BUILT

DRAWN

RS

CHECKED

JW

DATE

20/09/23

SCALE

1/100

SIZE

A1

PRELIMINARY TENDER CONSTRUCTION

DRAWING NO.

AB/001

REV.

A