




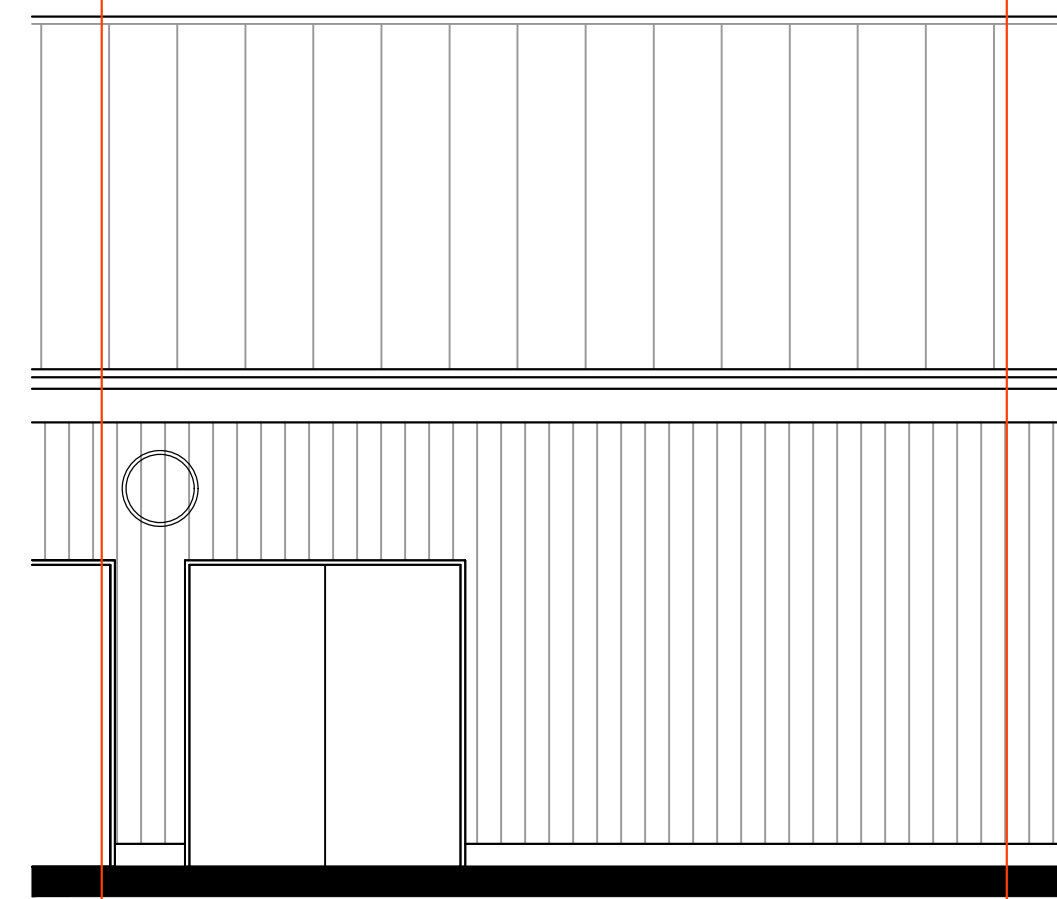


Unit 2 West Elevation

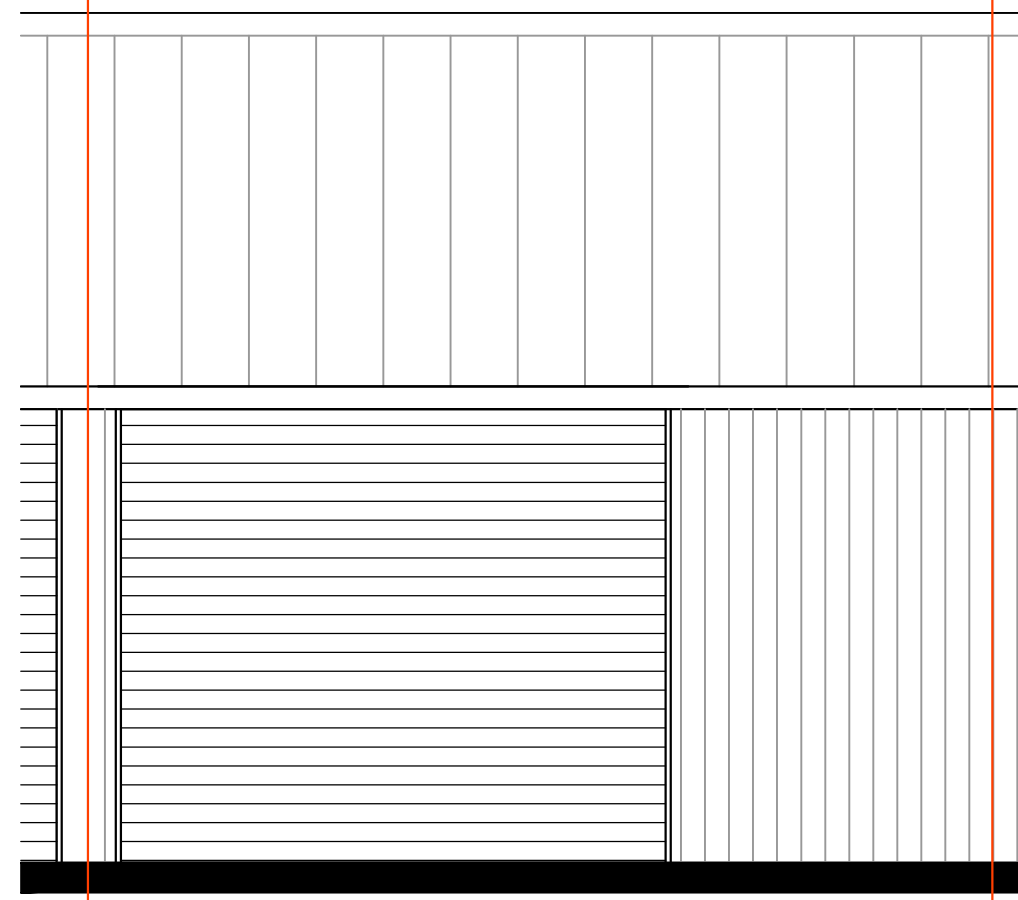

Roller
shutter

Unit 2 East Elevation

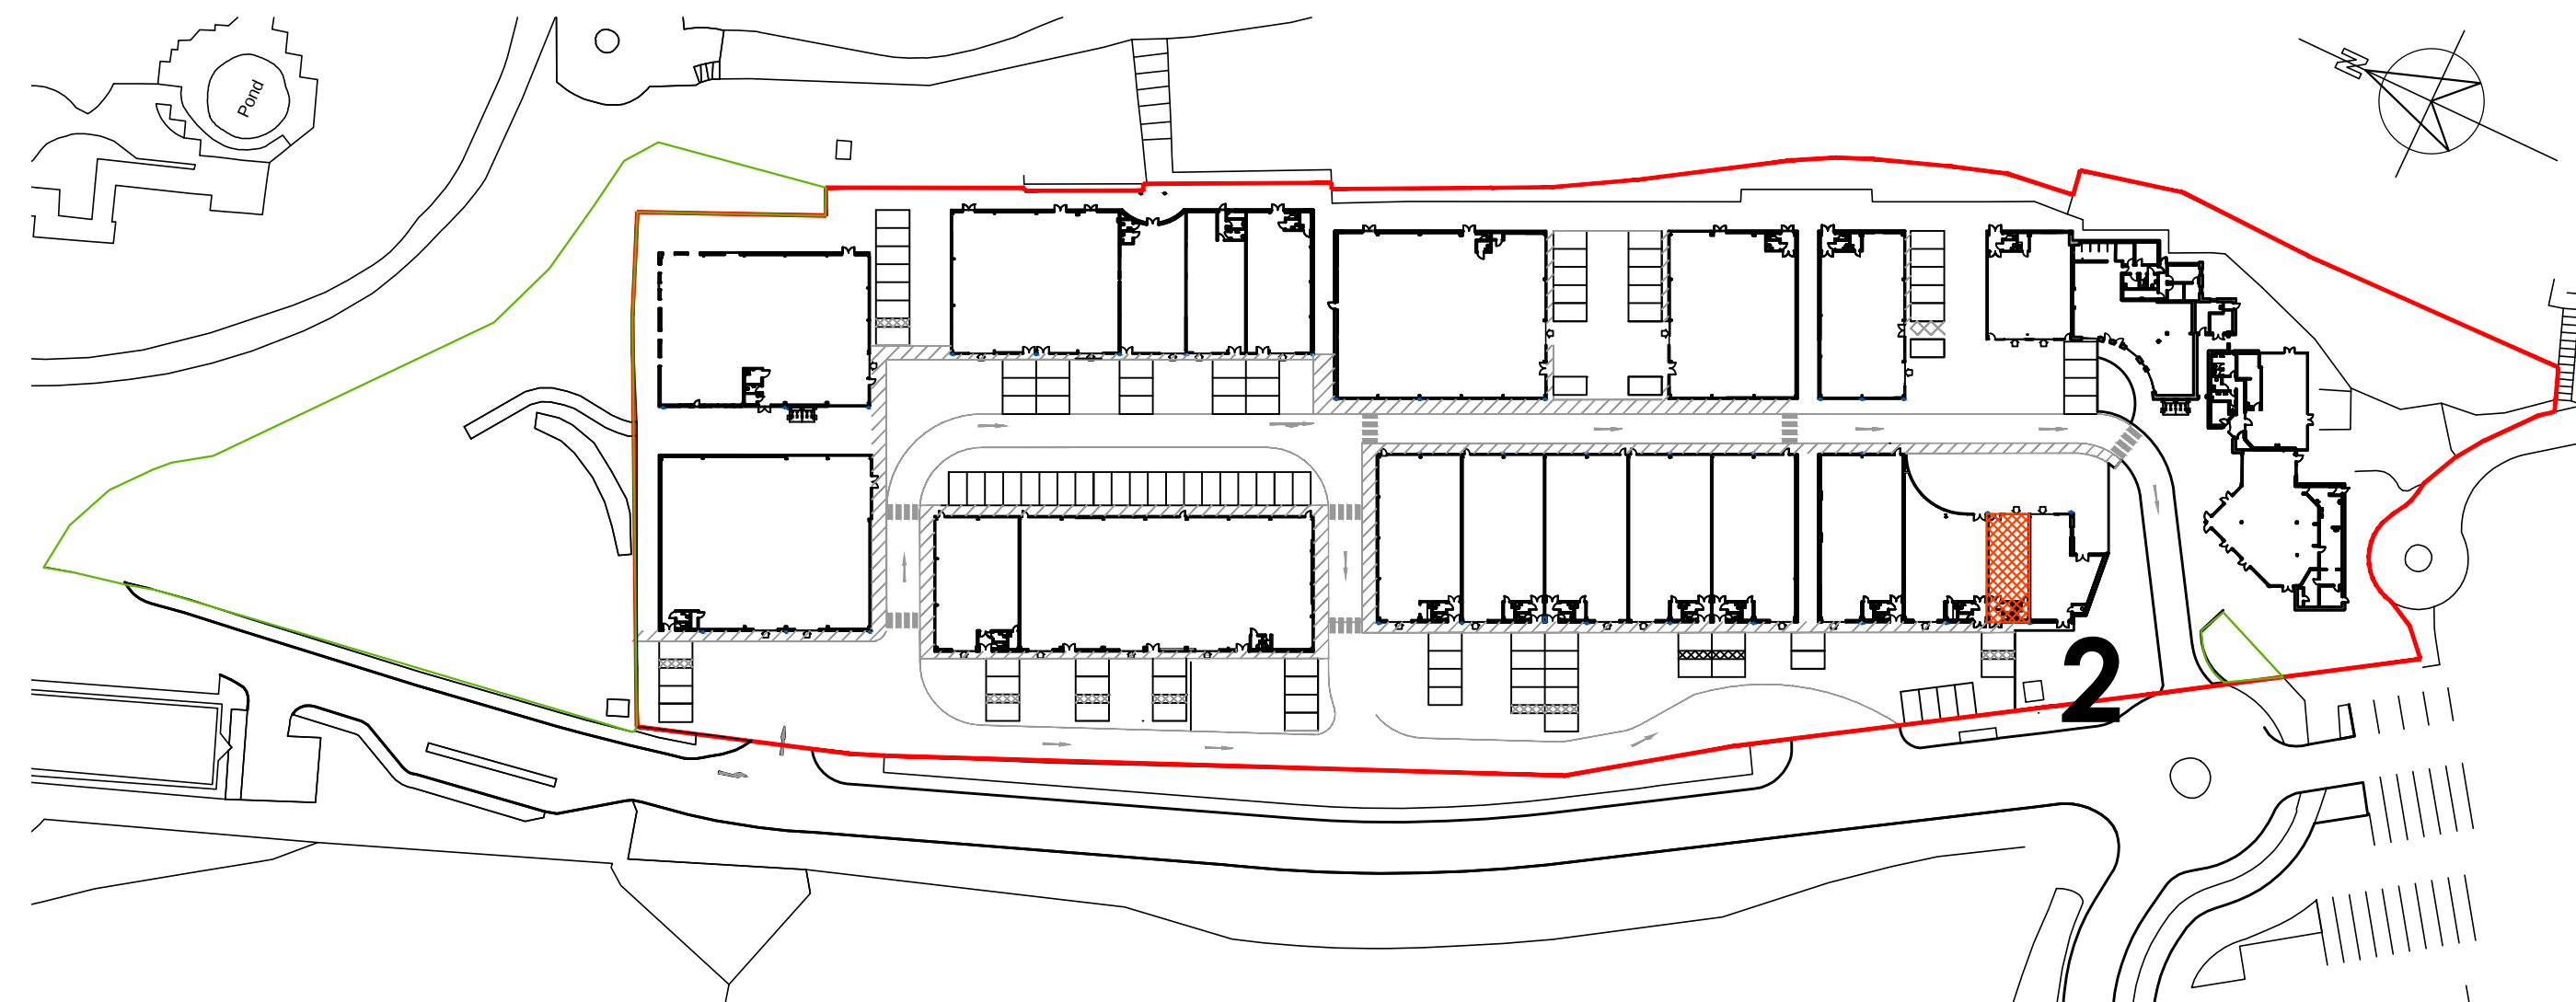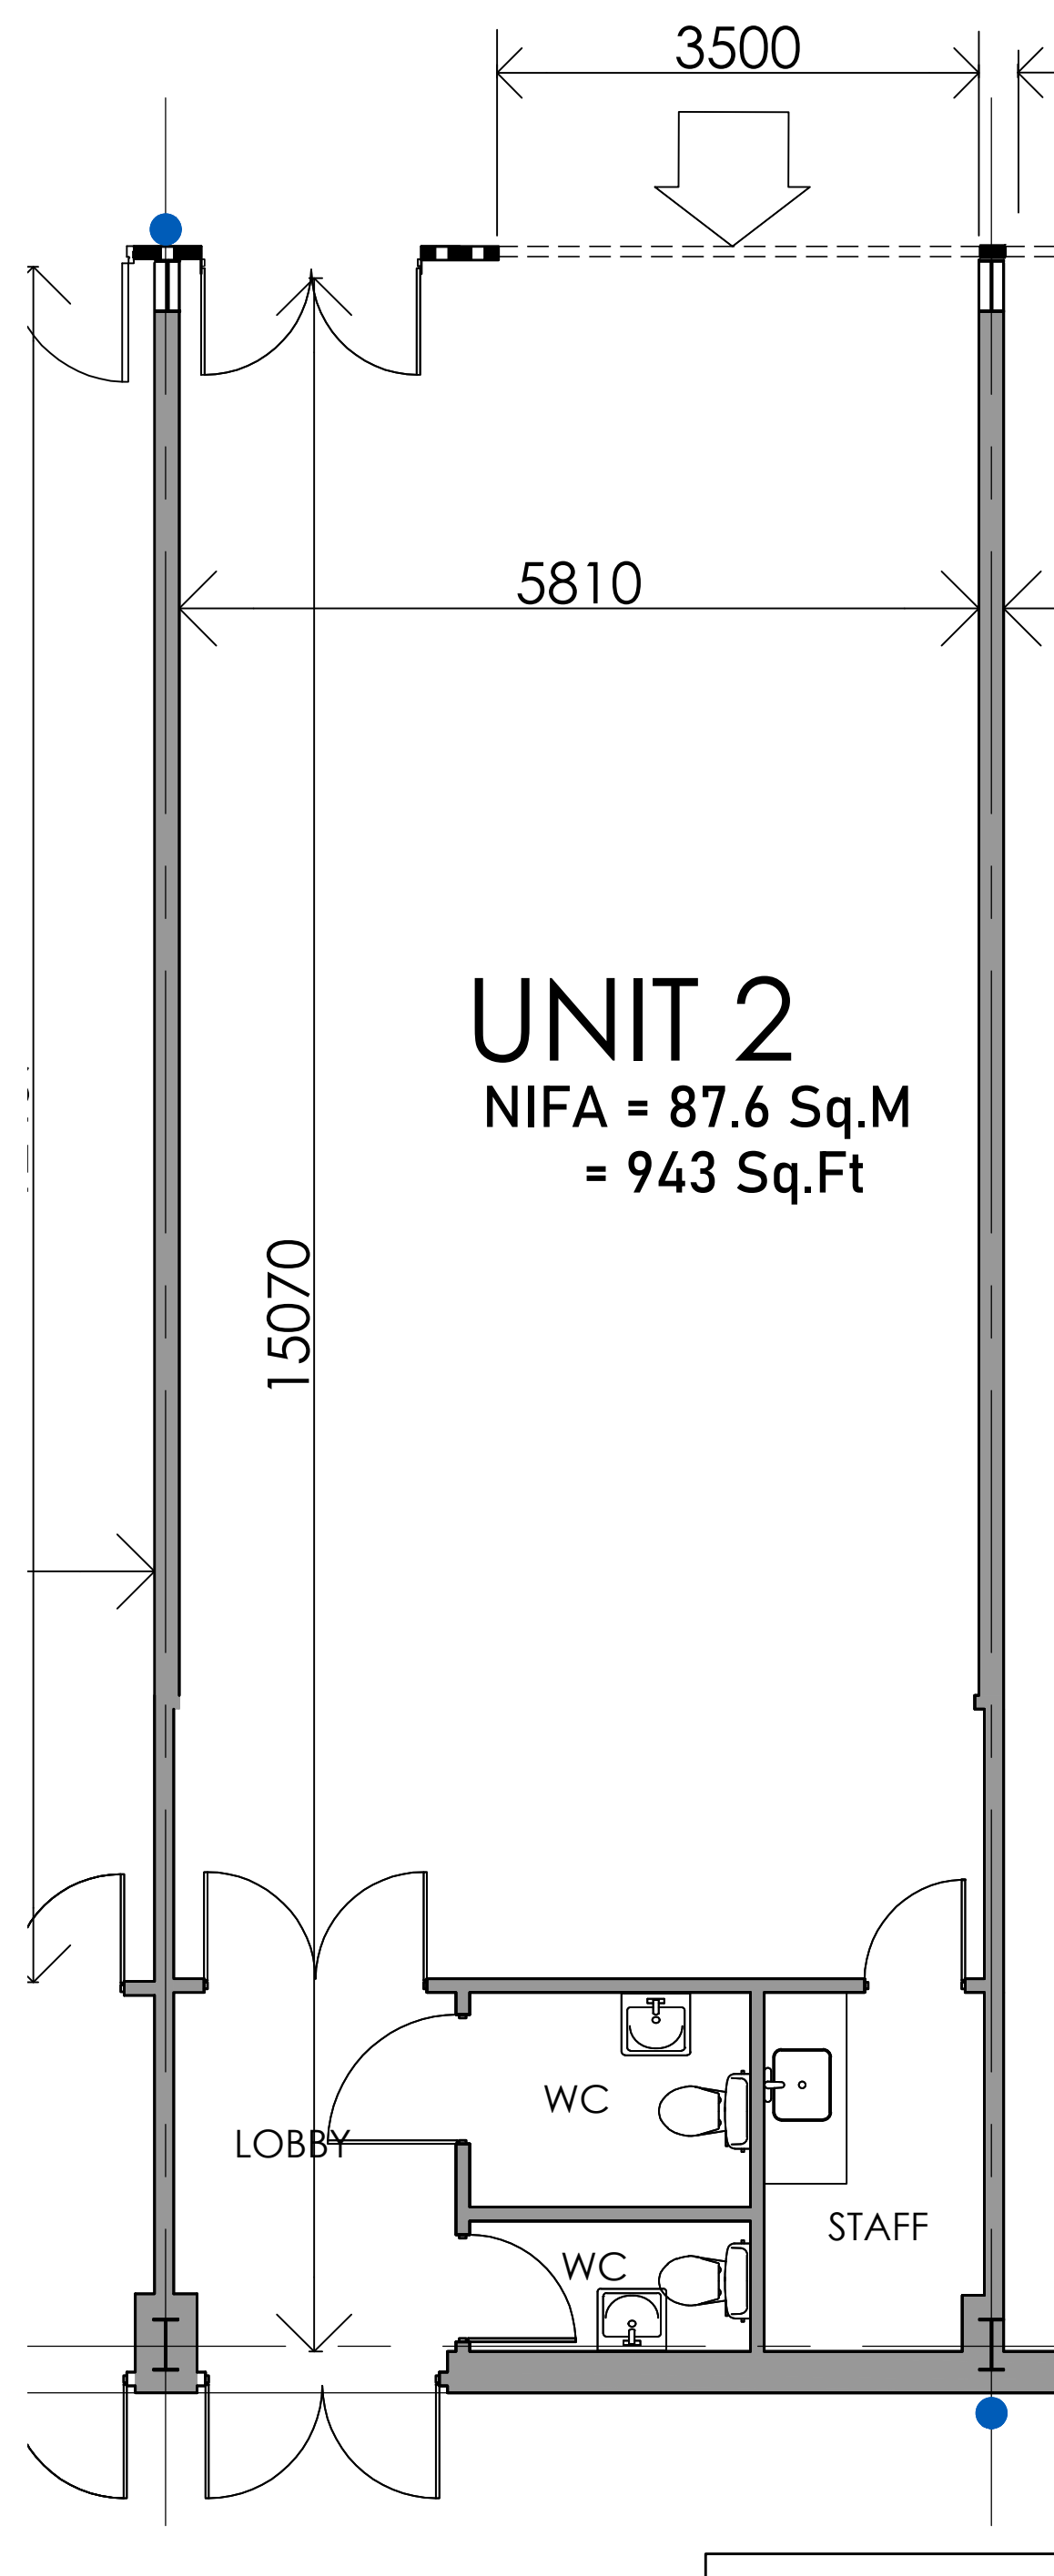

SITE PLAN 1:1000

UNIT:
UNIT 2
NET INTERNAL FLOOR AREA = 87.6 Sq.M
= 943 Sq.Ft

 **Creation Design**
Creation Design - Wales
Tel: 01495 616277 / 07508890294
www.creationdesign-wales.com
E-mail: info@creationdesign-wales.com

PROPOSED REDEVELOPMENT
FORMER FESTIVAL PARK SITE
QUEEN STREET
VICTORIA, EBBW VALE
NP23 6UN

UNIT 2. PLAN & ELEVATIONS

DATE: June 2024	DRAWN BY: P.P.
SCALE(S): 1:50 @ A1	DRAWING NO: 24-073/AB/2
	REV: