


6th Floor

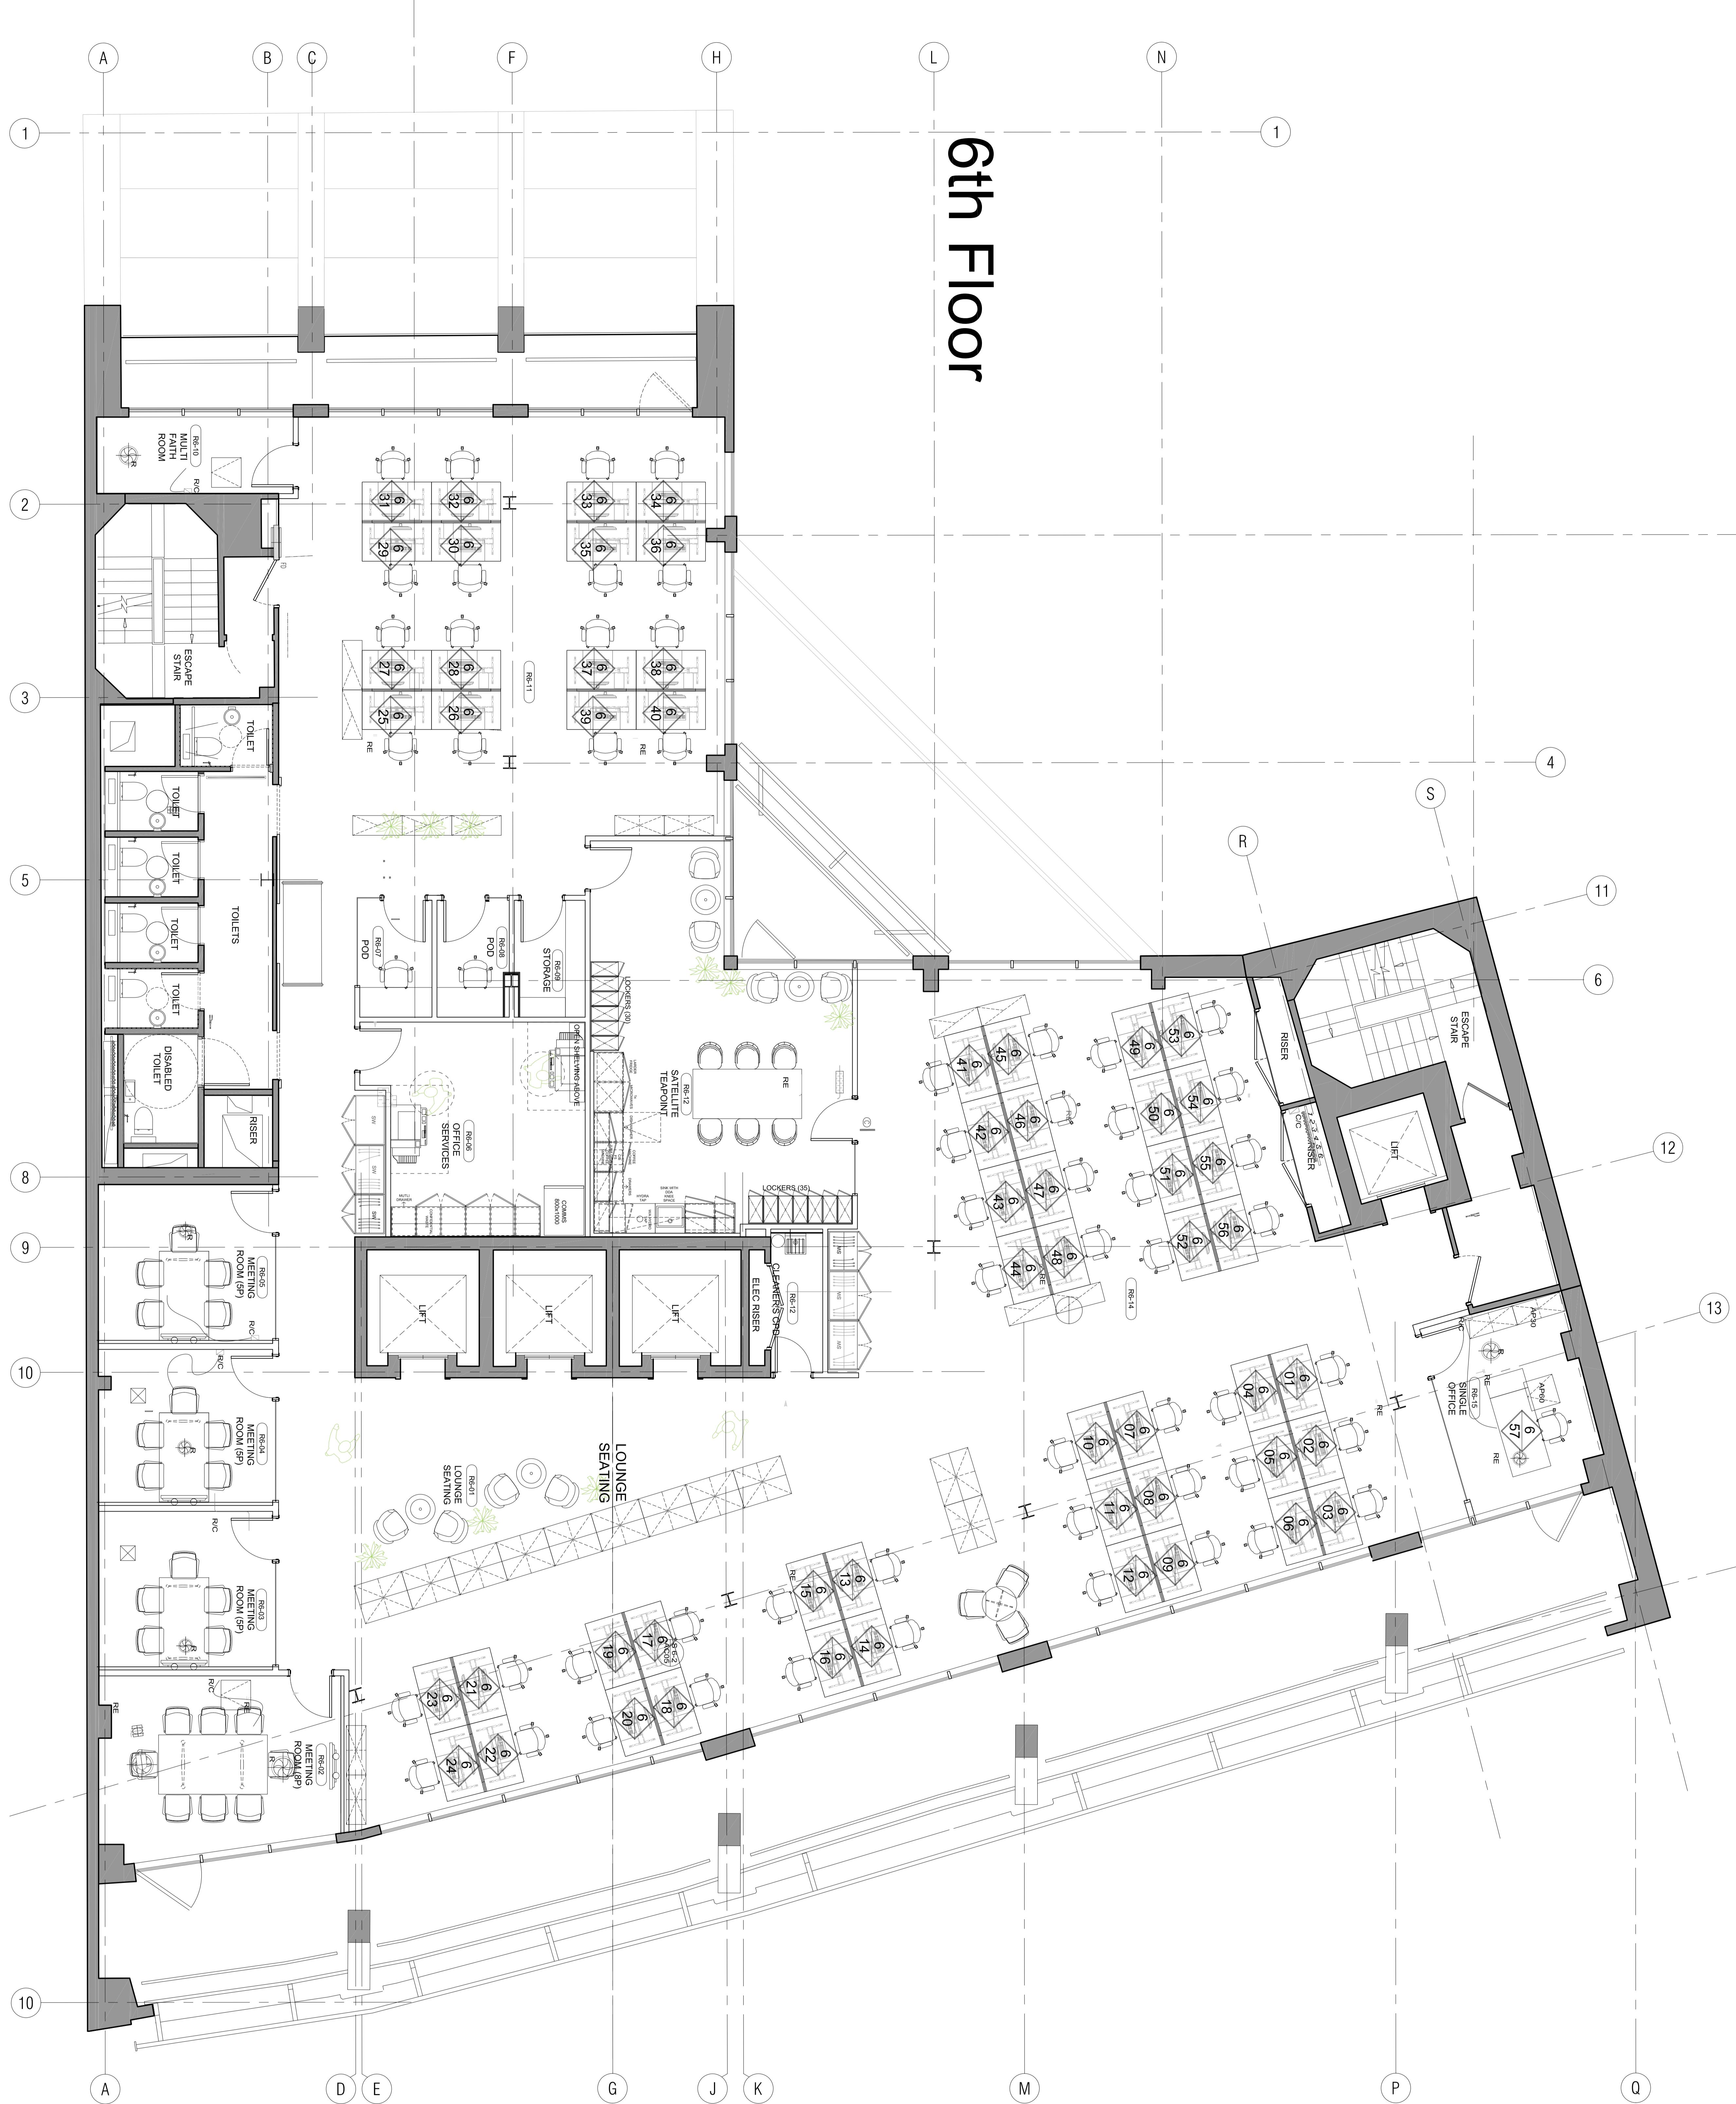

Leigh Day

PROJECT
PANAGRAM BUILDING
27 GOSWELL ROAD
LONDON EC1M 7GT
TITLE
SIXTH FLOOR
GENERAL ARRANGEMENT
PLAN

Creating a
Work/Live
Balance

Peldon Rose

Peldon Rose Limited
Stirling House, 42 Wimpole Road
London SW1 4QQ
Telephone 020 8971 7777
www.pelondonrose.com

This drawing is the property of Peldon Rose Limited and is to be used only for the purpose for which it was supplied. It is not to be reproduced in part or in full without the written permission of Peldon Rose Limited.

© Peldon Rose Limited

EN2708 FLOOR TYPE NUMBER REVISION

06 01 RD

DATE SHEET SIZE DRAWN BY SW CHECKED BY

15.03.21 A0 SW -

SCALE

1:50 @ A0

RECORD DRAWING		REVISIONS
RD 150127-1	Record Drawing	SW -
O 120520-1	Office Service Centre layout and layout	SW -
P 120520-2	GA amended to allow additional break and coffee facilities	SW -
M 270421	Desk numbers added	SW -
L 150321	Updated as a construction drawing	SW -
REV. DATE	DESCRIPTION	BY
		CJ

NOTE
This drawing is not to be scaled.
Approved contractors are responsible to notify Peldon Rose Limited of any
alterations made to the drawing during the course of construction.
All information is subject to statutory approval and site survey.
The general contractor is to carry out a check site survey to confirm that
in whole or in part the drawing is correct and that it is appropriate to the environment
in which it is to be used.
The general contractor is to notify Peldon Rose Limited if any
preliminary works that are required to be carried out prior to their works.