

Written dimensions on these drawings shall take precedence over scaled dimensions. Contractors shall verify and be responsible for all dimensions and conditions on the project and this office must be notified of any variations from the dimensions and conditions shown by these drawings prior to commencement of any work. All contractors are deemed to have made themselves aware of site conditions prior to entering into any contract. Shopfitting details must be submitted to this office for approval before proceeding with fabrication. This drawing is the property of rpa. Copyright is reserved by them and the drawing is issued on condition that it is not copied, reproduced, retained or disclosed to any unauthorised person, either wholly or in part without the consent in writing of rpa.

J	11.05.22	AS BUILT ISSUE	AD	CS
H	12/10/2021	KITCHEN UPDATED TO SUIT NEW ADVANCE DRAWING RECEIVED 12.10.21	AD	CS
G	04.08.2021	Digital schedule added	JC	CS
F	02.08.2021	updated to latest feedback,	JC	CS
E	23.07.2021	updated to latest feedback, additional outside seating added, digital screen added chair spec updated	JC	CS
D	14.07.2021		JC	CS
C	01.07.2021	barriers updated	JC	CS
B	01.07.2021	updated to feedback received on 31.06.2021	JC	CS
A	28.06.2021	Shopfront alterations updated.	JC	CS
-	23.06.2021	Enlarged Ambulant toilet with lobby added	JC	CS

LEON Borough Market
18-20 Southwark St
London SE1 1TU
02070897070

address
CAMDEN
190 Camden High street,
Camden
London
NW1 8QP

client job no.
-

drawing title
General Arrangement
As proposed

drawn by JC	date 23.06.2021	checked CS
job no. 2007120	drawing no. A100	revision J

RISK ASSESSMENT SUMMARY (RAS)			
Date	By	Element of Design	Residual Risk
28.06.2021	JC	Electrical	CONTRACTOR TO CHECK FOR RISKS SERVICES WITH CAT DETECTOR
28.06.2021	JC	OVER HEAD WORKING TO CEILING	FALL AND OBJECTS FALLING. CONTRACTOR TO CHECK FOR RISKS SERVICES WITH CAT DETECTOR PRIOR TO INSTALLATION OF ANY CABINETS AND TO USE SUITABLE EQUIPMENT AND TRAINED STAFF
28.06.2021	JC	INSTALLATION OF SIGNAGE	FALL AND OBJECTS FALLING. CONTRACTOR TO USE SUITABLE ACCESS PLATFORM EQUIPMENT AND COMPLETE METHOD STATEMENT FOR WORKS
28.06.2021	JC	INSTALLATION OF SAFE	INJURY DUE TO MANUAL HANDLING AND HEAVY OBJECTS. CONTRACTOR TO CARRY OUT WORK IN A SAFE AND CORDON OFF AREA. PROVIDE METHOD STATEMENT FOR SUPPORTS AND REMOVAL OF HAZARDOUS MATERIALS.
28.06.2021	JC	DEMOLITION / STRIP OUT WORKS	

PPE TO BE WORN AT ALL TIMES ON SITE.

Key		
A	Grease Trap	By Others
A	Grease Trap	By Others
B	Tundish	
1.01	Nylon Coated Wire Shelving System	
1.02	Dishes Trolley	
1.03	Slim Jim waste container 60 litres	By Others
1.04	Pre rinse, deck mounted	
1.05	Double tier shelf, wall mounted	
1.06	Undercounter Dishwasher	
1.06A	Water Softener - Utensil Washer	
1.07	Nylon Coated Wire Shelving System	
1.08	Nylon Coated Wire Shelving System (x4)	
1.09	Nylon Coated Wire Shelving System	
1.10	COSHH Double Door Chemical Cabinet 36ltr	
1.11	Hand Wash station knee operated	
2.01	Remode Cooler Carbonator	By Others
2.02	Ice Machine half dead cube (air cooled)	By Others
2.02A	Ice Bin (24kg storage)	By Others
2.03	Nylon Coated Wire Shelving System	
2.04	Nylon Coated Wire Shelving System (x2)	
2.05	Nylon Coated Wire Shelving System	
2.06	Nylon Coated Wire Shelving System	
2.07	4 tier, wire storage rack	
2.08	Premier mobile Gastro trolley 15 tier 1/2	
2.09	Nylon Coated Wire Shelving System (x2)	
2.10	Nylon Coated Wire Shelving System	
2.11	Nylon Coated Wire Shelving System	
3.01	Upright Freezer Cabinet	
3.02	Upright refrigerated cabinet	
3.03	Hand Wash station knee operated	
3.04	Excutor Grid Fly Killer	
4.01	Stainless steel rice cooker & bain marie bench	
4.02	Wall mounted Angled Sauce Bottle Holder	
4.03	Stainless steel angled GN shelf	
4.04	Heated Holding / Warming Bin	By Others
4.05	Stainless steel wall shelf	
4.06	Counter top Rice Warmer 20L	
4.07	Slim Jim waste container 60 litres	By Others
4.08	Wet heat two pot Bain Marie (x2)	
5.01	Reinforced mobile combi oven stand	
5.02	Professional combination oven 6 grid	
5.03	Professional combination oven 6 grid	
5.04	Wall mounted 1/2 GN holder	
5.05	Counter top 1850w Microwave oven (x2)	
5.06	Wall bench (sink)	
5.06A	Mixer tap with water saving defuser	
5.07	Stainless steel microwave wall shelf	
5.08	Stainless steel rice bench	
5.09	Buffalo CK598 9ltr Rice Cooker (x2)	Existing
5.10	Mobile ingredient bin 65L (x2)	By Others
6.01	Counter top crisp n hold	
6.02	Food Warmer, Counter top, Electric	
6.03	Stainless steel low height wall bench	
6.04	Label holder	
6.04	Label holder	
6.04	Label holder	
7.01	Stainless steel wall bench	
7.02	Large single ribbed Parini Grill Electric (x2)	
7.03	Label holder	
7.04	4 Slot Toaster	
7.05	Slim Jim waste container 60 litres	By Others
7.06	Stainless steel wall shelf	
7.06	Stainless steel wall shelf	
7.07	Label holder	
7.07	Label holder	
7.08	Stainless steel angled GN shelf	
7.09	Heated Holding / Warming Bin	By Others
7.10	Grease Paper Holder	
7.10	Grease Paper Holder	
7.11	Stainless steel wall bench	
7.12	Vertical contact toaster - without Butter Wheel	Existing
7.13	Wall mounted Angled Sauce Bottle Holder	
8.01	QAT Pass Counter	
9.01	Stainless steel drinks station	
9.01A	Coffee Guardian waste strainer for Barista Machine (x2)	
9.02	Undercounter refrigerated cabinet	
9.04	Glass freshener with recessed drip tray	
9.05	Slim Jim waste container 60 litres	By Others
9.06	Double door Sliding Bottle Cooler	
9.07	Post Mix Station	
9.09	Stainless steel drinks counter	
9.10	Single flavour counter-top machine perfect for milkshakes	By Others
9.11	Waring 45L Blender	
10.01	5/5 Single Tier Wall Mounted Pegs	
	Coffee Machine	By Others
	Coffee Machine	By Others
	Slim Jim waste container 60 litres	By Others

KITCHEN LAYOUT RECEIVED FROM ADVANCE 12/10/2021


ALL DIMENSIONS TO BE CONFIRMED AT STRIP OUT SURVEY

HEIGHT OF SHELVES TO BE DETERMINED BY SIZE OF LEON BOXES

SEATING COVERS	
LOCATION	QUANTITY
FRONT OF HOUSE	16
OUTSIDE	12
TOTAL	28

AREAS SCHEDULE			
	LOCATION	SQ M	SQ FT
GROUND FLOOR	FRONT OF HOUSE	37.3	401
	KITCHEN	24	258
	COUNTER	9.3	100
	STAIRCASE	2.9	31
	AMBULANT TOILET WITH LOBBY	3.5	38
	VOID	4.3	46
	TOTAL GF	81.3	875
	OFFICE	3.8	41
	TEAM ROOM	6.1	66
	TEAM TOILETS	4.3	46
BASEMENT	WALK-IN FRIDGE	5.5	59
	WALK-IN FREEZER	4.8	52
	WASTE ROOM	1.85	20
	ELECTRICAL CUPBOARD	1	11
	KITCHEN	44.5	479
	HALLWAY	4.6	50
	STAIRCASE	3.5	38
	VOID	2.55	27
	TOTAL BASEMENT	82.50	888
	TOTAL	163.80	1763

DIGITAL/ IT			
NAME	SCREEN SIZE	ORIENTATION	QUANTITY
Digital menu screen above counter	43"	Landscape	3
Prep/ collection screen	43"	Landscape	1
Digital advertising screen by windows	46"	Portrait	1
Tills		TBC	2
Table mounted kiosk	15"	Portrait	4
Free standing kiosk		N/A	
Kitchen management screen	24"	Landscape	3
Digital coffee screen	15.6"	TBC	1
Expo screen	15.6"	TBC	1

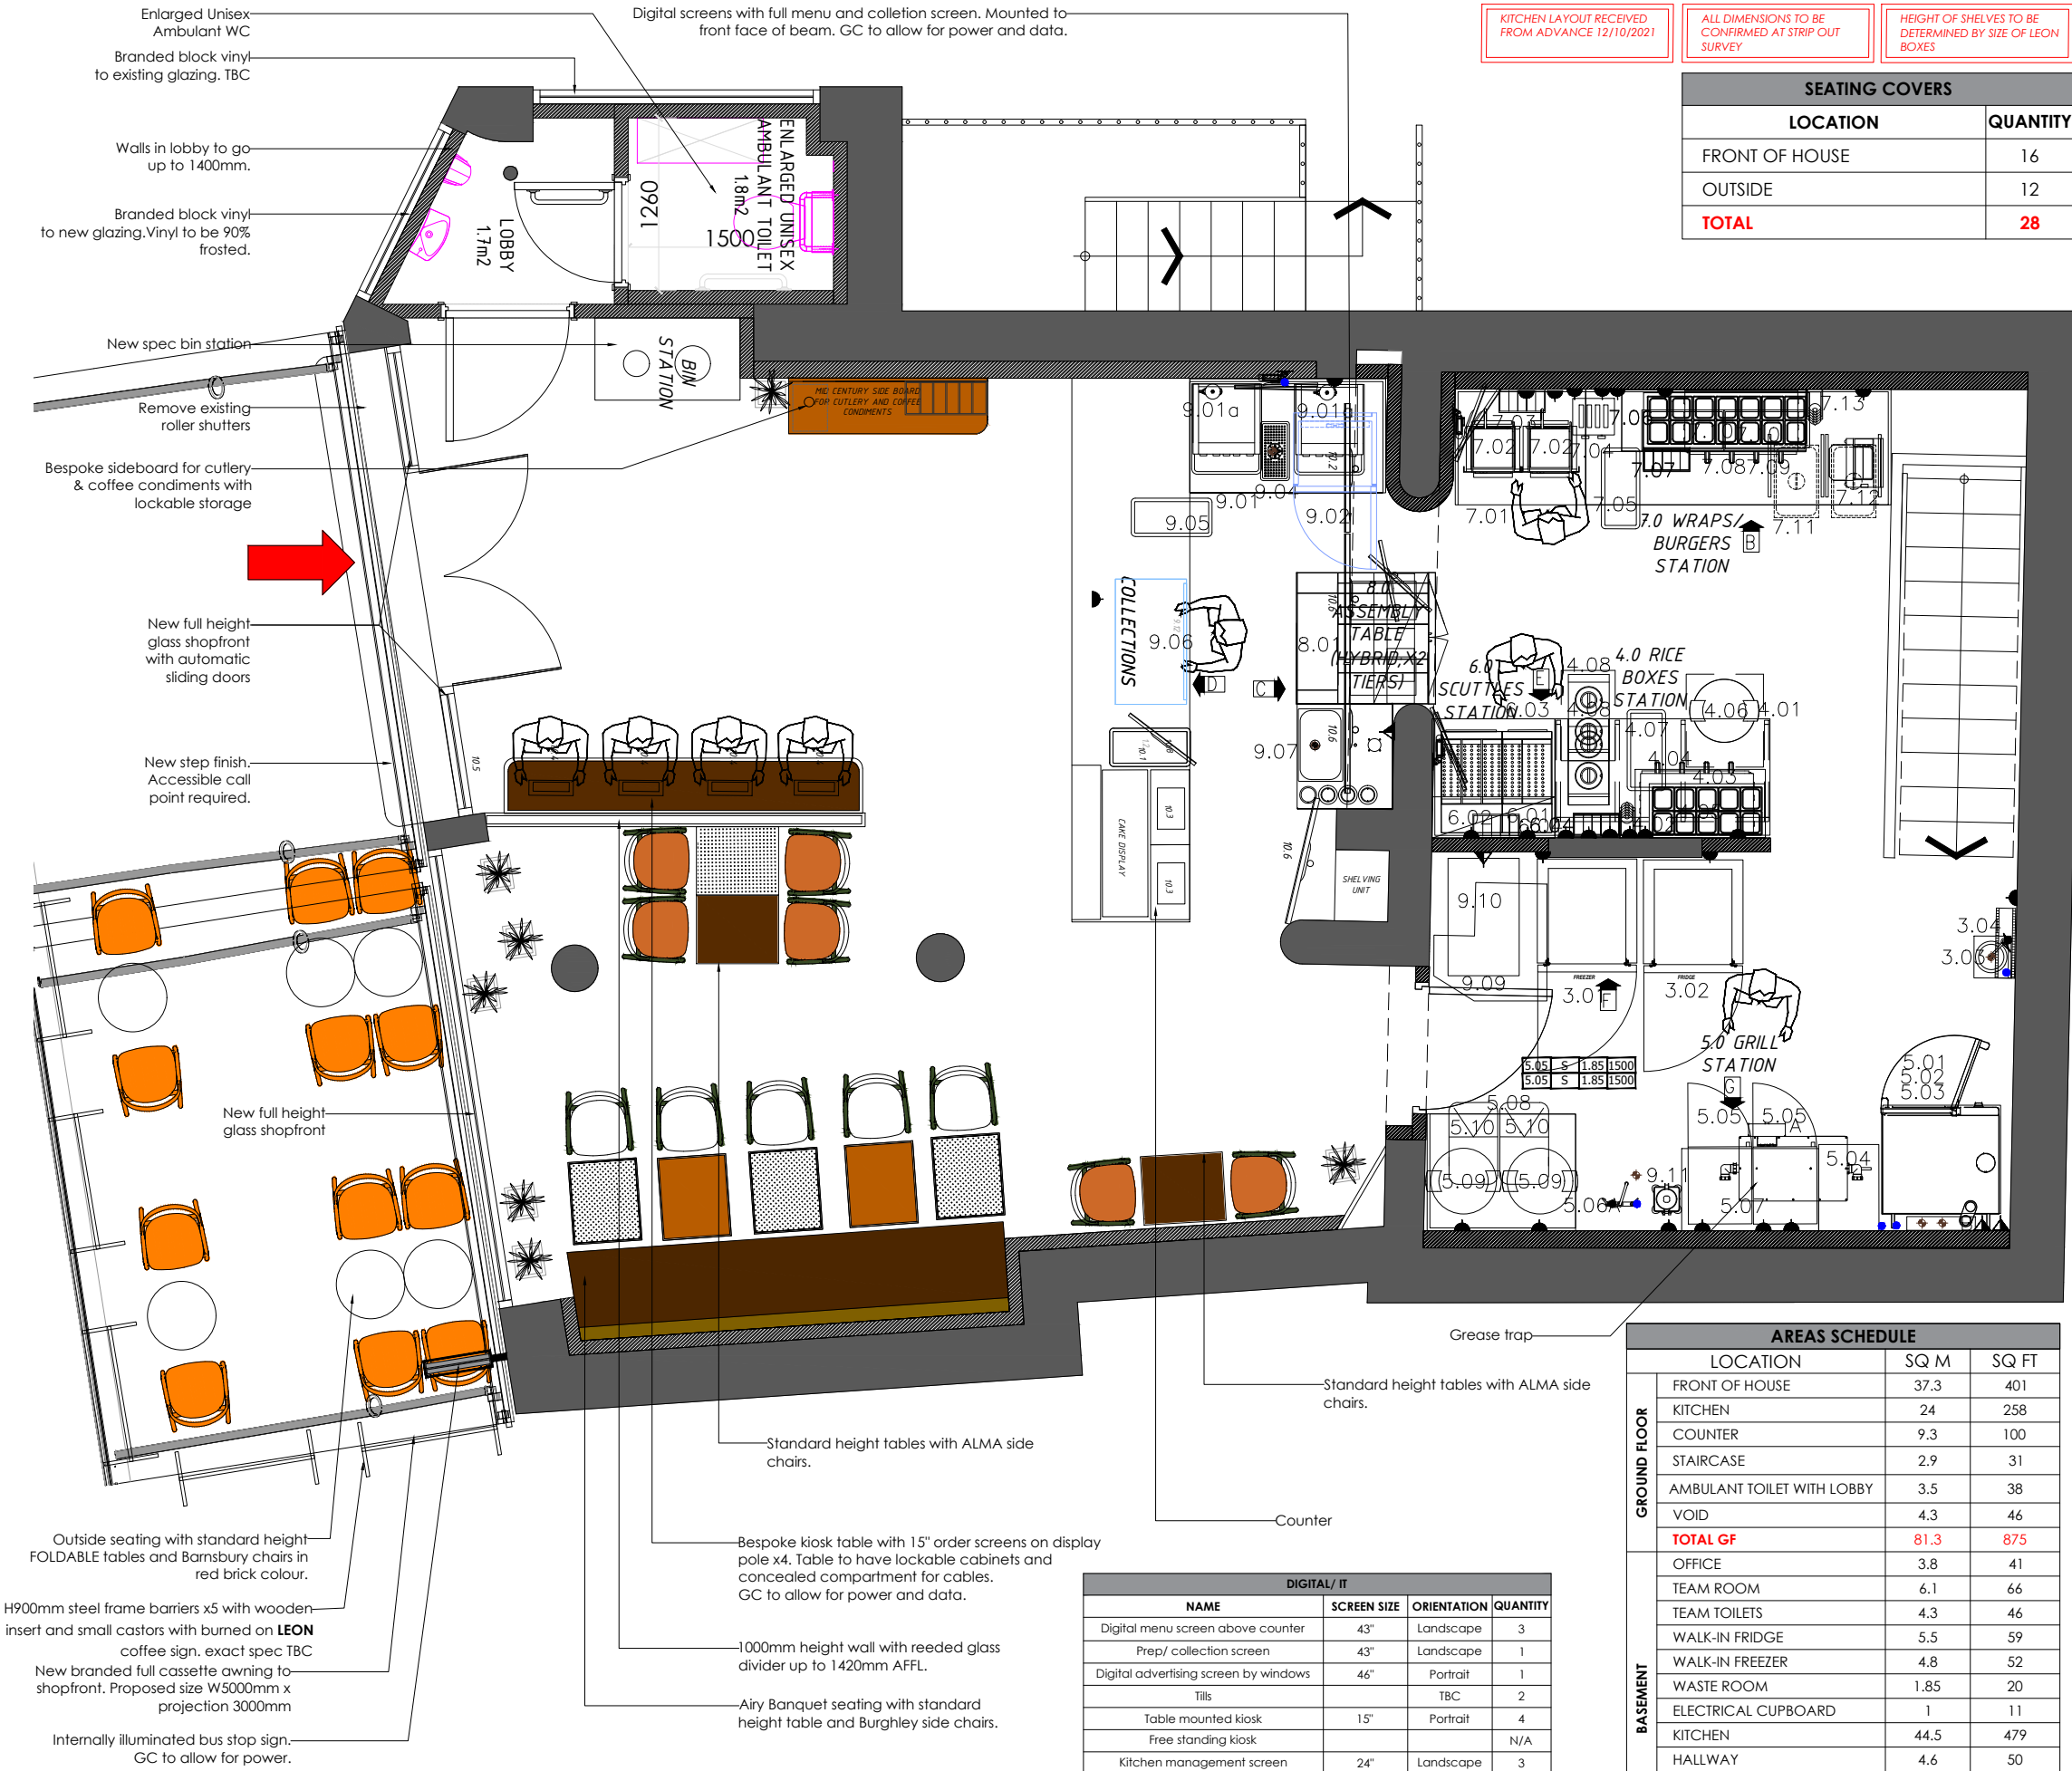

General Arrangement ground floor - as proposed
scale - 1:25 @ A1 / 1:50 @ A3