


General Notes:
 Do not scale from this drawing. Use marked dimensions.
 Should any discrepancies be noted, please inform this office.
 This drawing is copyright of Matthew Alchurch Architects Limited.



- FLOOR FINISHES KEY**
- 1) Cleaned existing terrazzo flooring.
 - 2) Architech Ash grey floor tiles.
 - 3) Engineered oak flooring.
 - 4) Chromitech warm 4.0 floor tiles.
 - 5) External 'Treated Ribbed Timber Deck, Hard wood.
 - 6) Resin bound gravel.
 - 8) Planting, species Lavandula angustifolia 'Hidcote'.

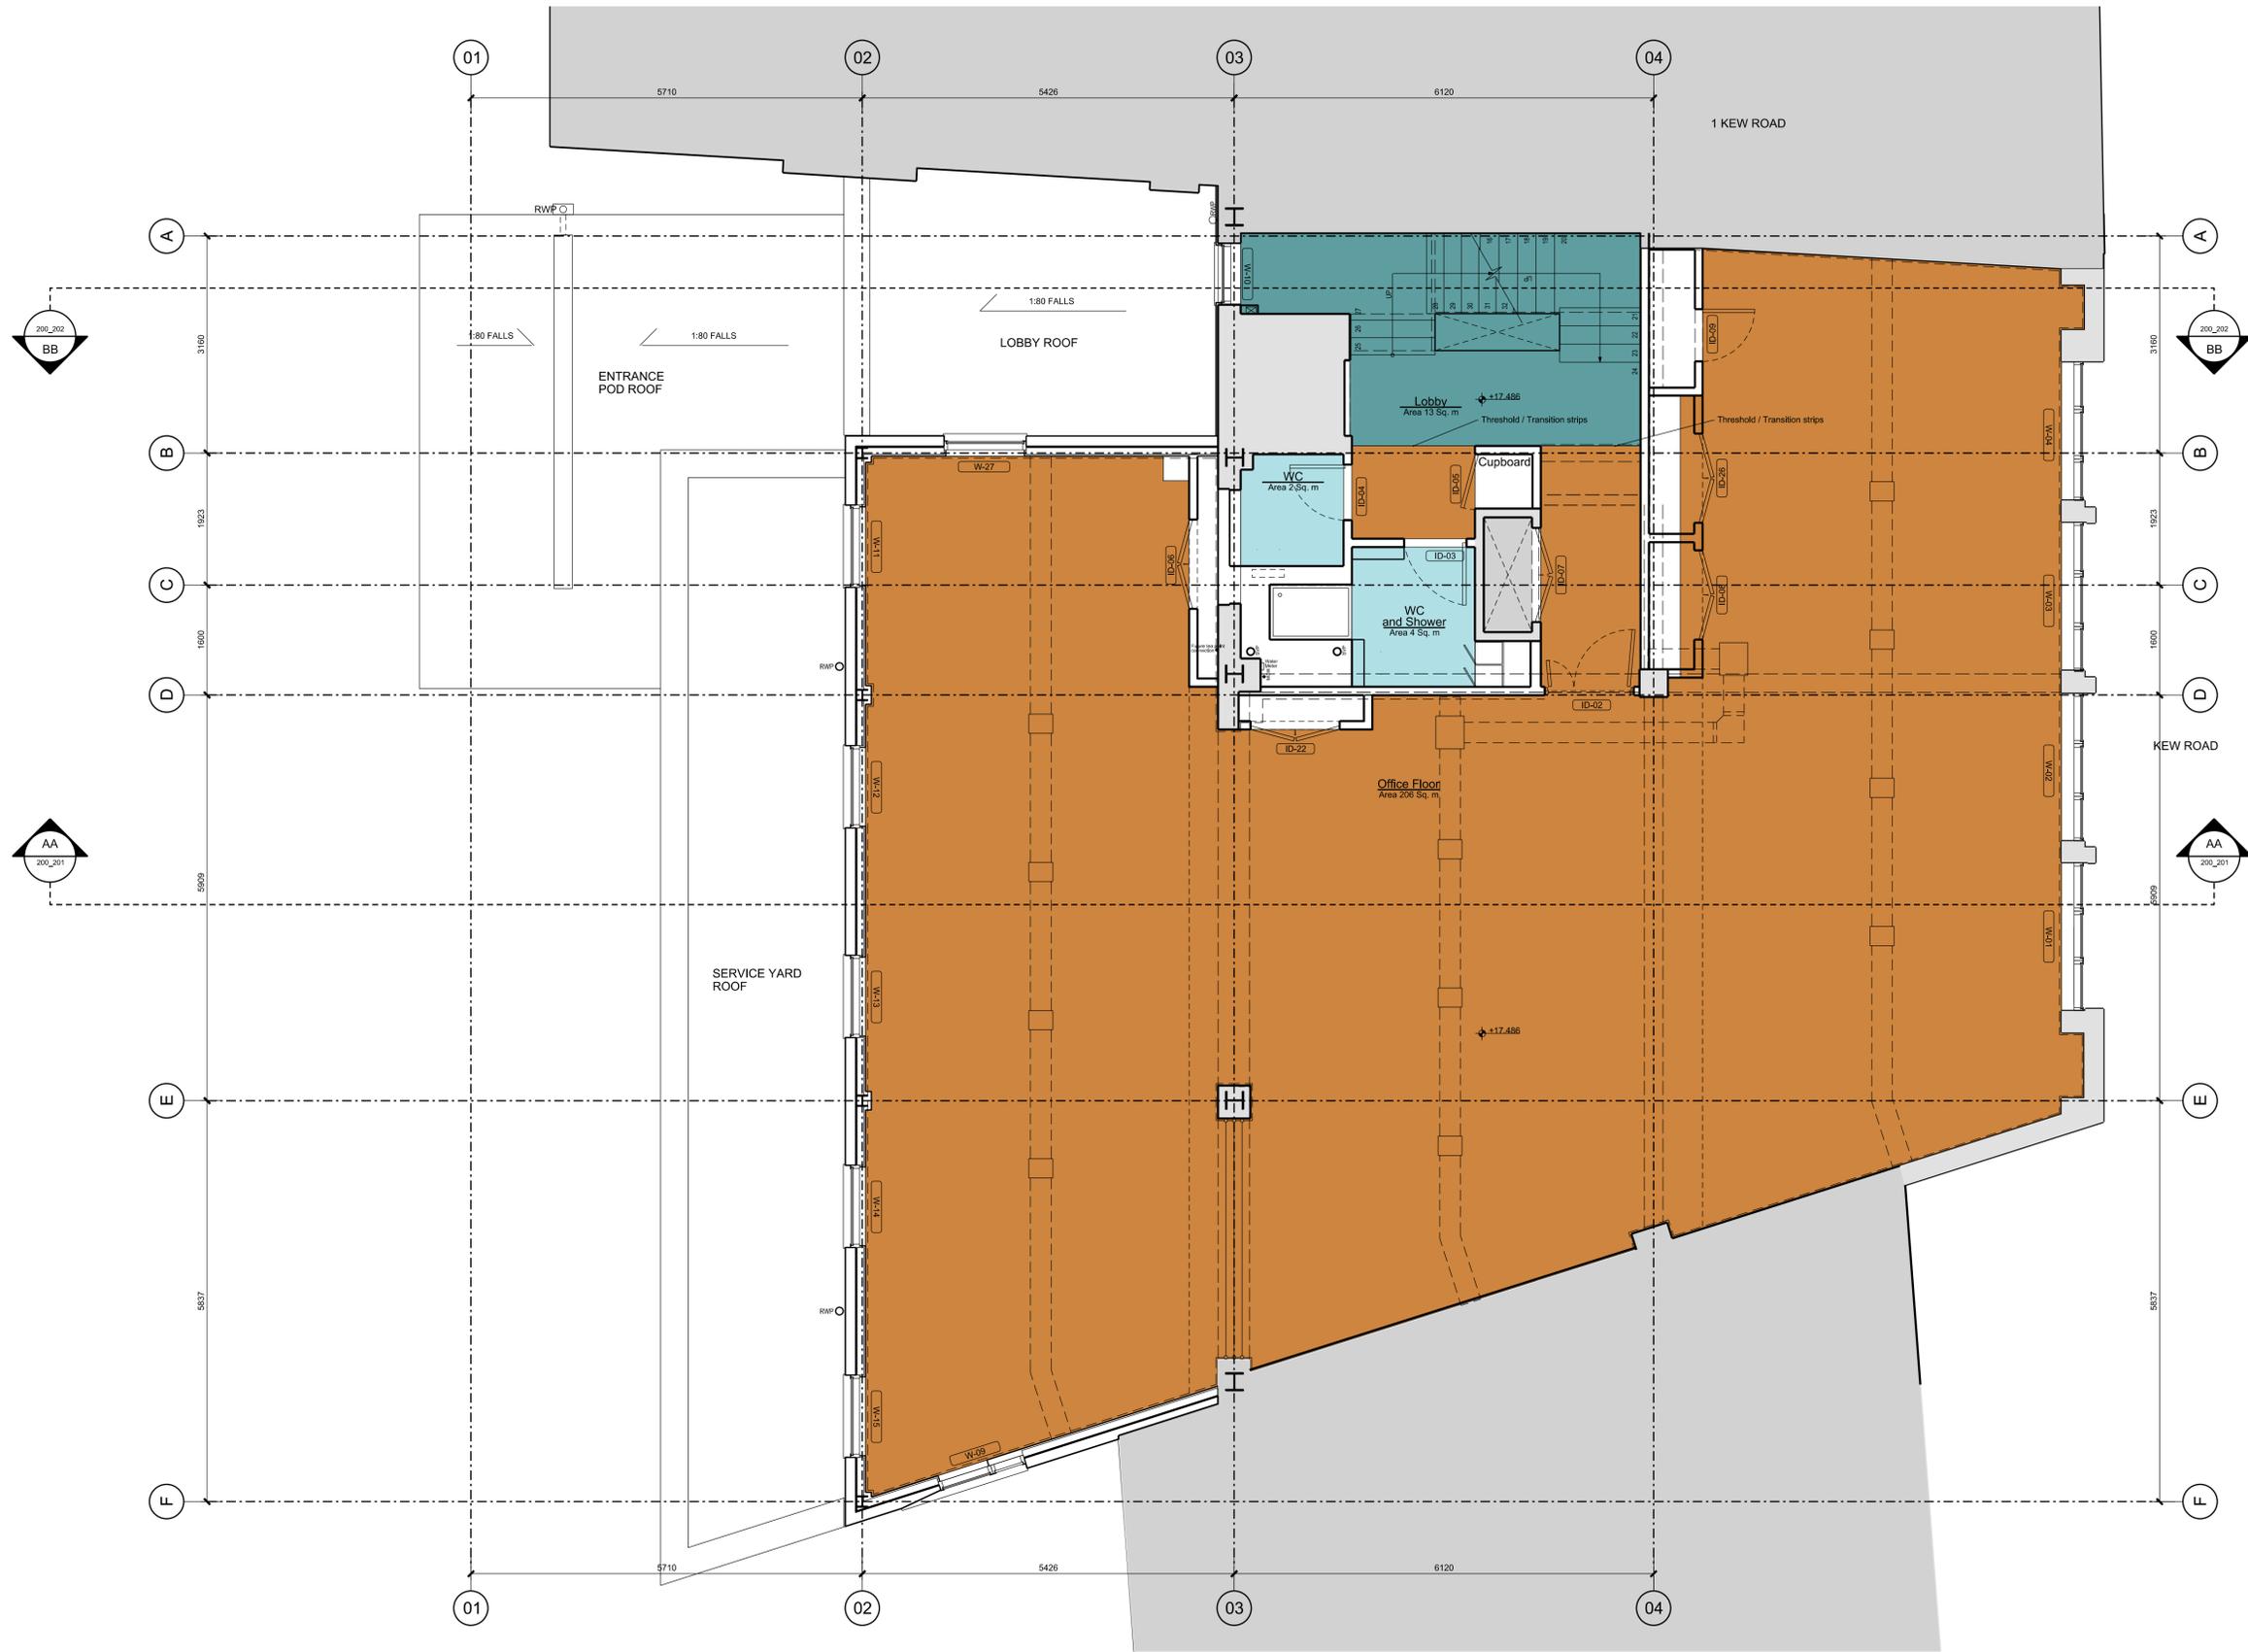

F	FINAL DESIGN ISSUE	03/06/15	BW	MA
E	WC AND SHOWER LAYOUT UPDATED	07/11/14	BW	MA
D	ISSUED FOR CONSTRUCTION	18/09/14	BW	MA
C	ISSUED FOR CONSTRUCTION	15/08/14	BW	MA
B	AMENDED TO COMMENTS ISSUED FOR TENDER	17/04/14	BW	MA
A	ISSUED FOR TENDER	03/04/14	BW	MA

Rev: Description: Date Dm by: Ckd by:

MAA Architects
 the boathouse design studio
 27 ferry road teddington tw11 9nn
 t: 020 8973 0050
 e: info@maa-architects.com
 w: www.maa-architects.com

Client:
CBREI

Project Name:
MIDMOOR HOUSE OFFICE

Drawing Title:
FIRST FLOOR PLAN FLOOR FINISHES

Project No:	Drawing No:	Revision:	Scale:	Date:
CBREI 001	331_002	F	1:50@A1	20/02/2014
Drawn by:	Checked by:	Drawing Status:		
BW	MA	FINAL DESIGN		