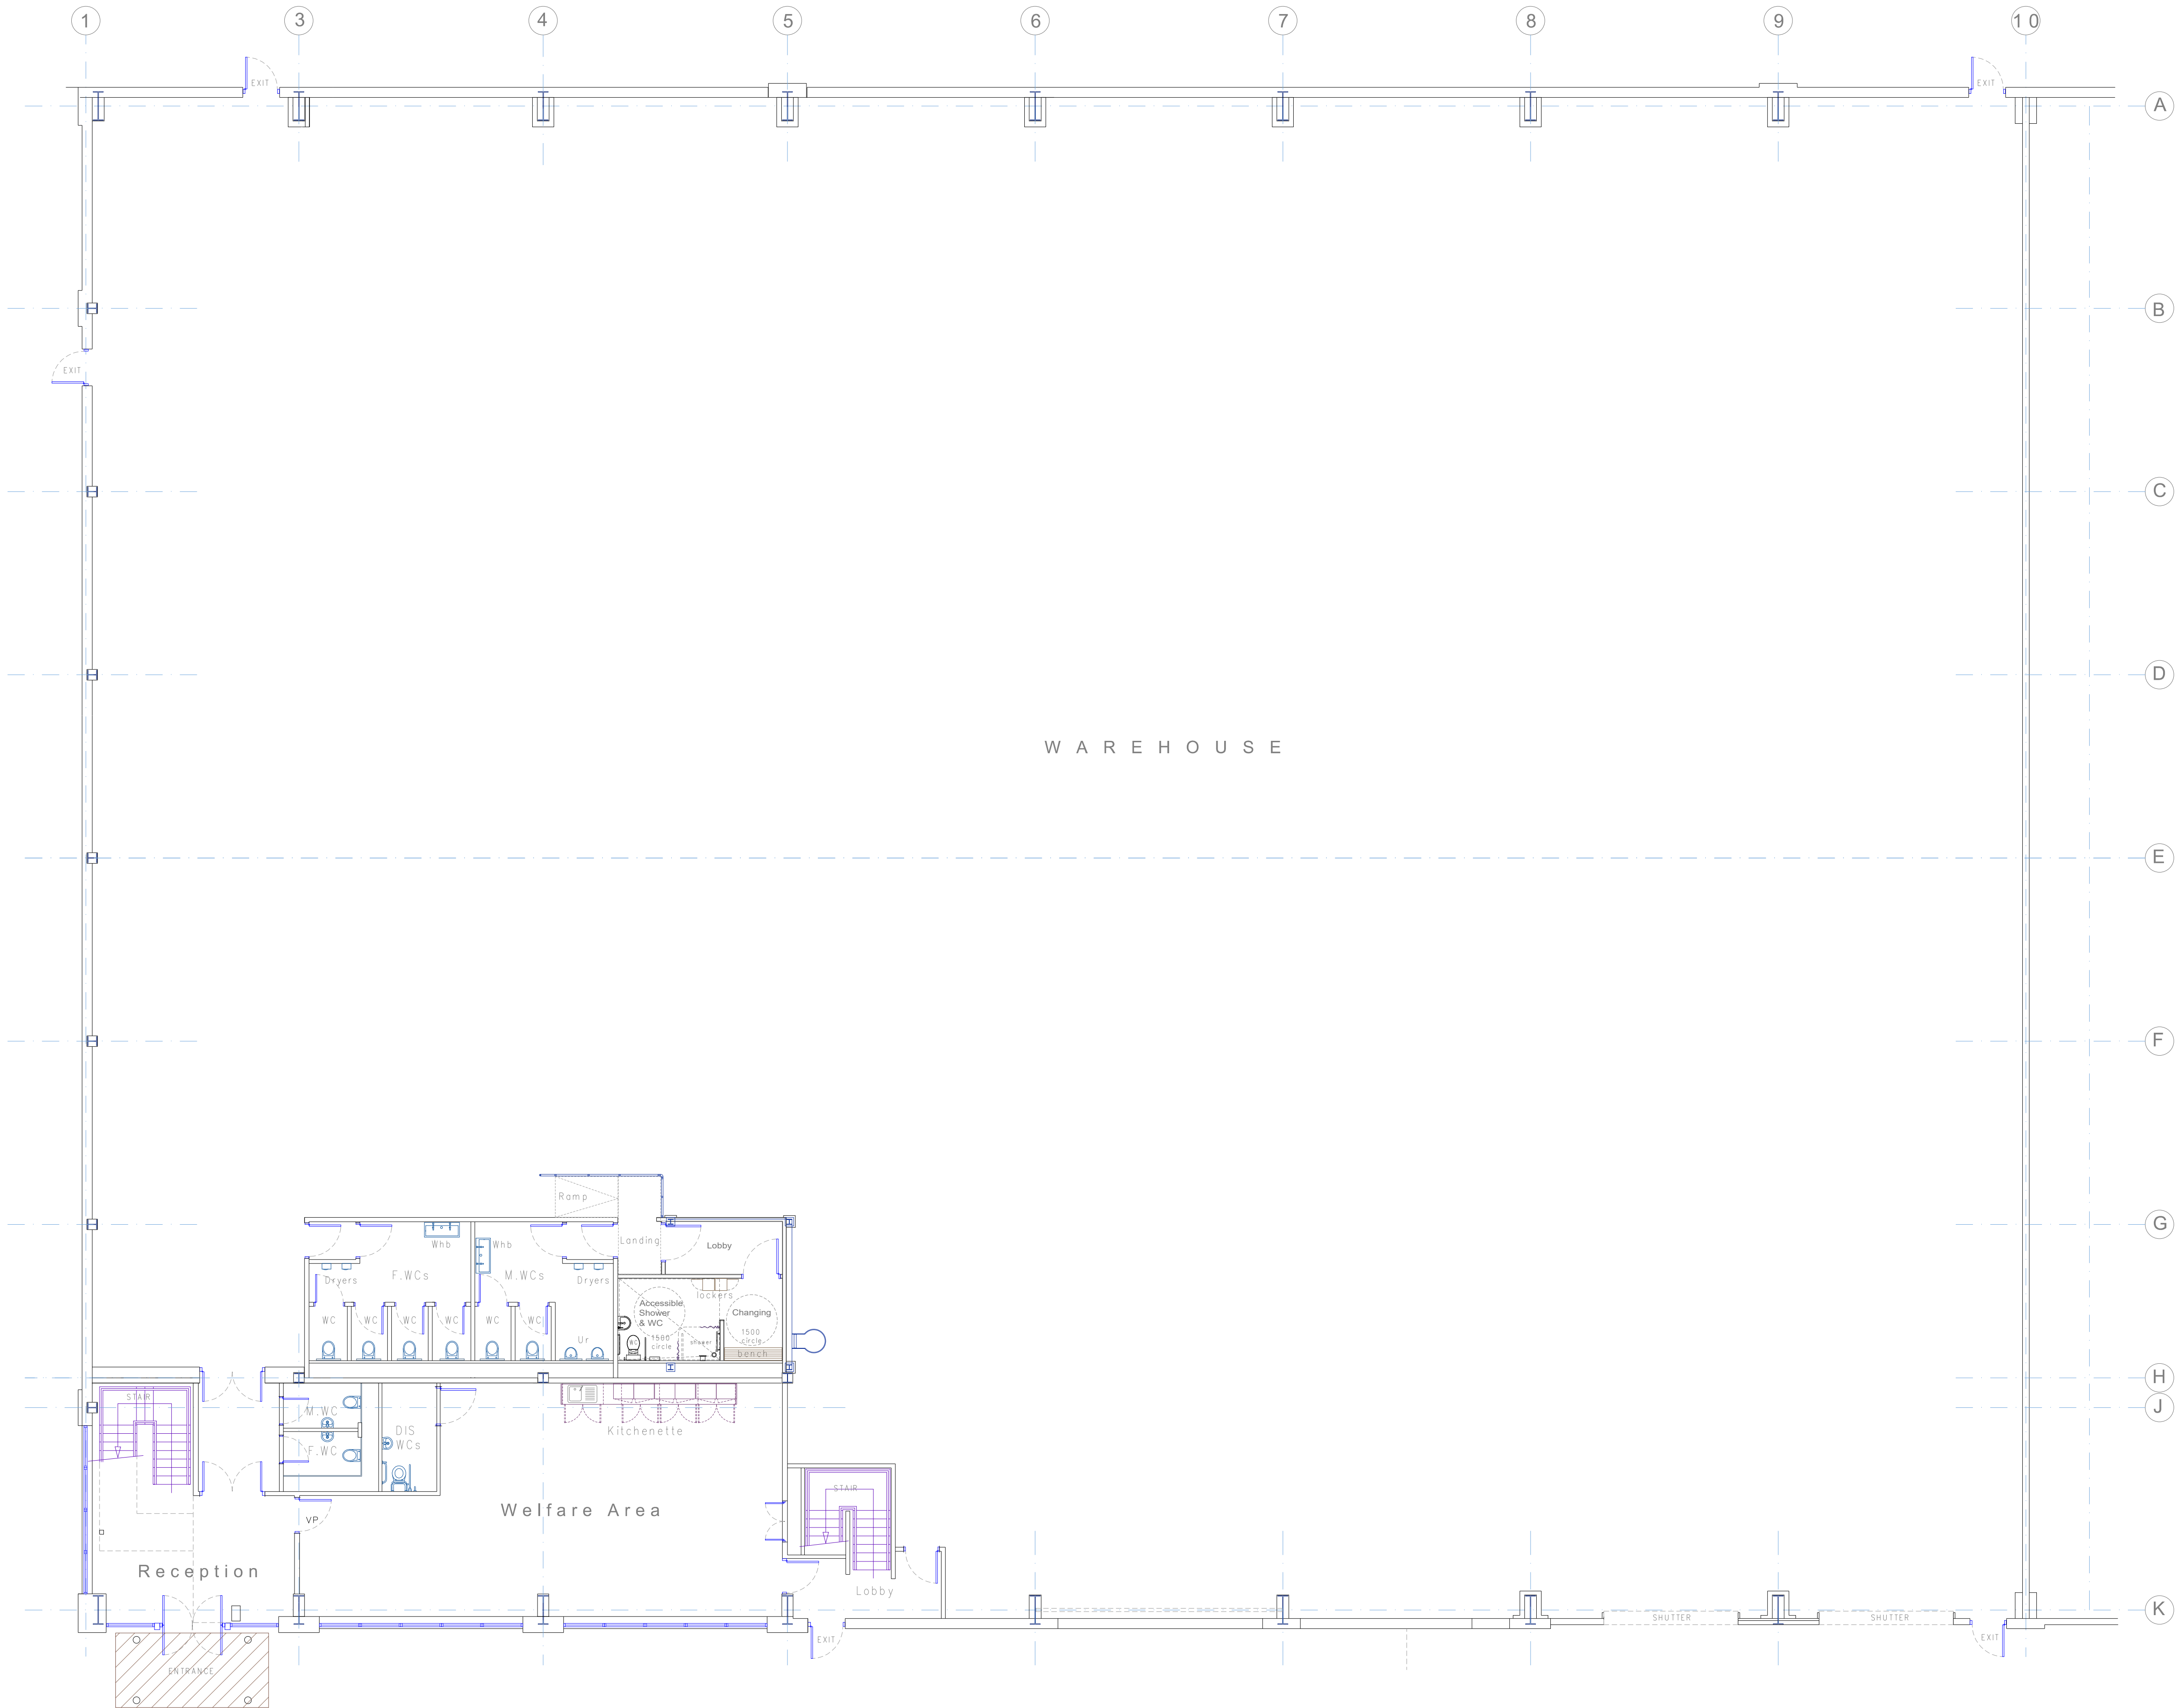


NOTE

AS BUILT Ground Floor

UNIT B1,
Parkway Trading Estate
Heston, TW5 9QA

Rev	Description	Date	By	Chk'd
 <i>Real value in a changing world</i>				
Client		Scale 1:100 @ α 1		
Project		Date 07 JULY 26		
Description		By PJ Checked		
Job		UNIT B1, PARKWAY WEST		
Drg		B1.GF.AB.07		

DO NOT SCALE THIS DRAWING. CHECK ALL DIMENSIONS ON SITE