


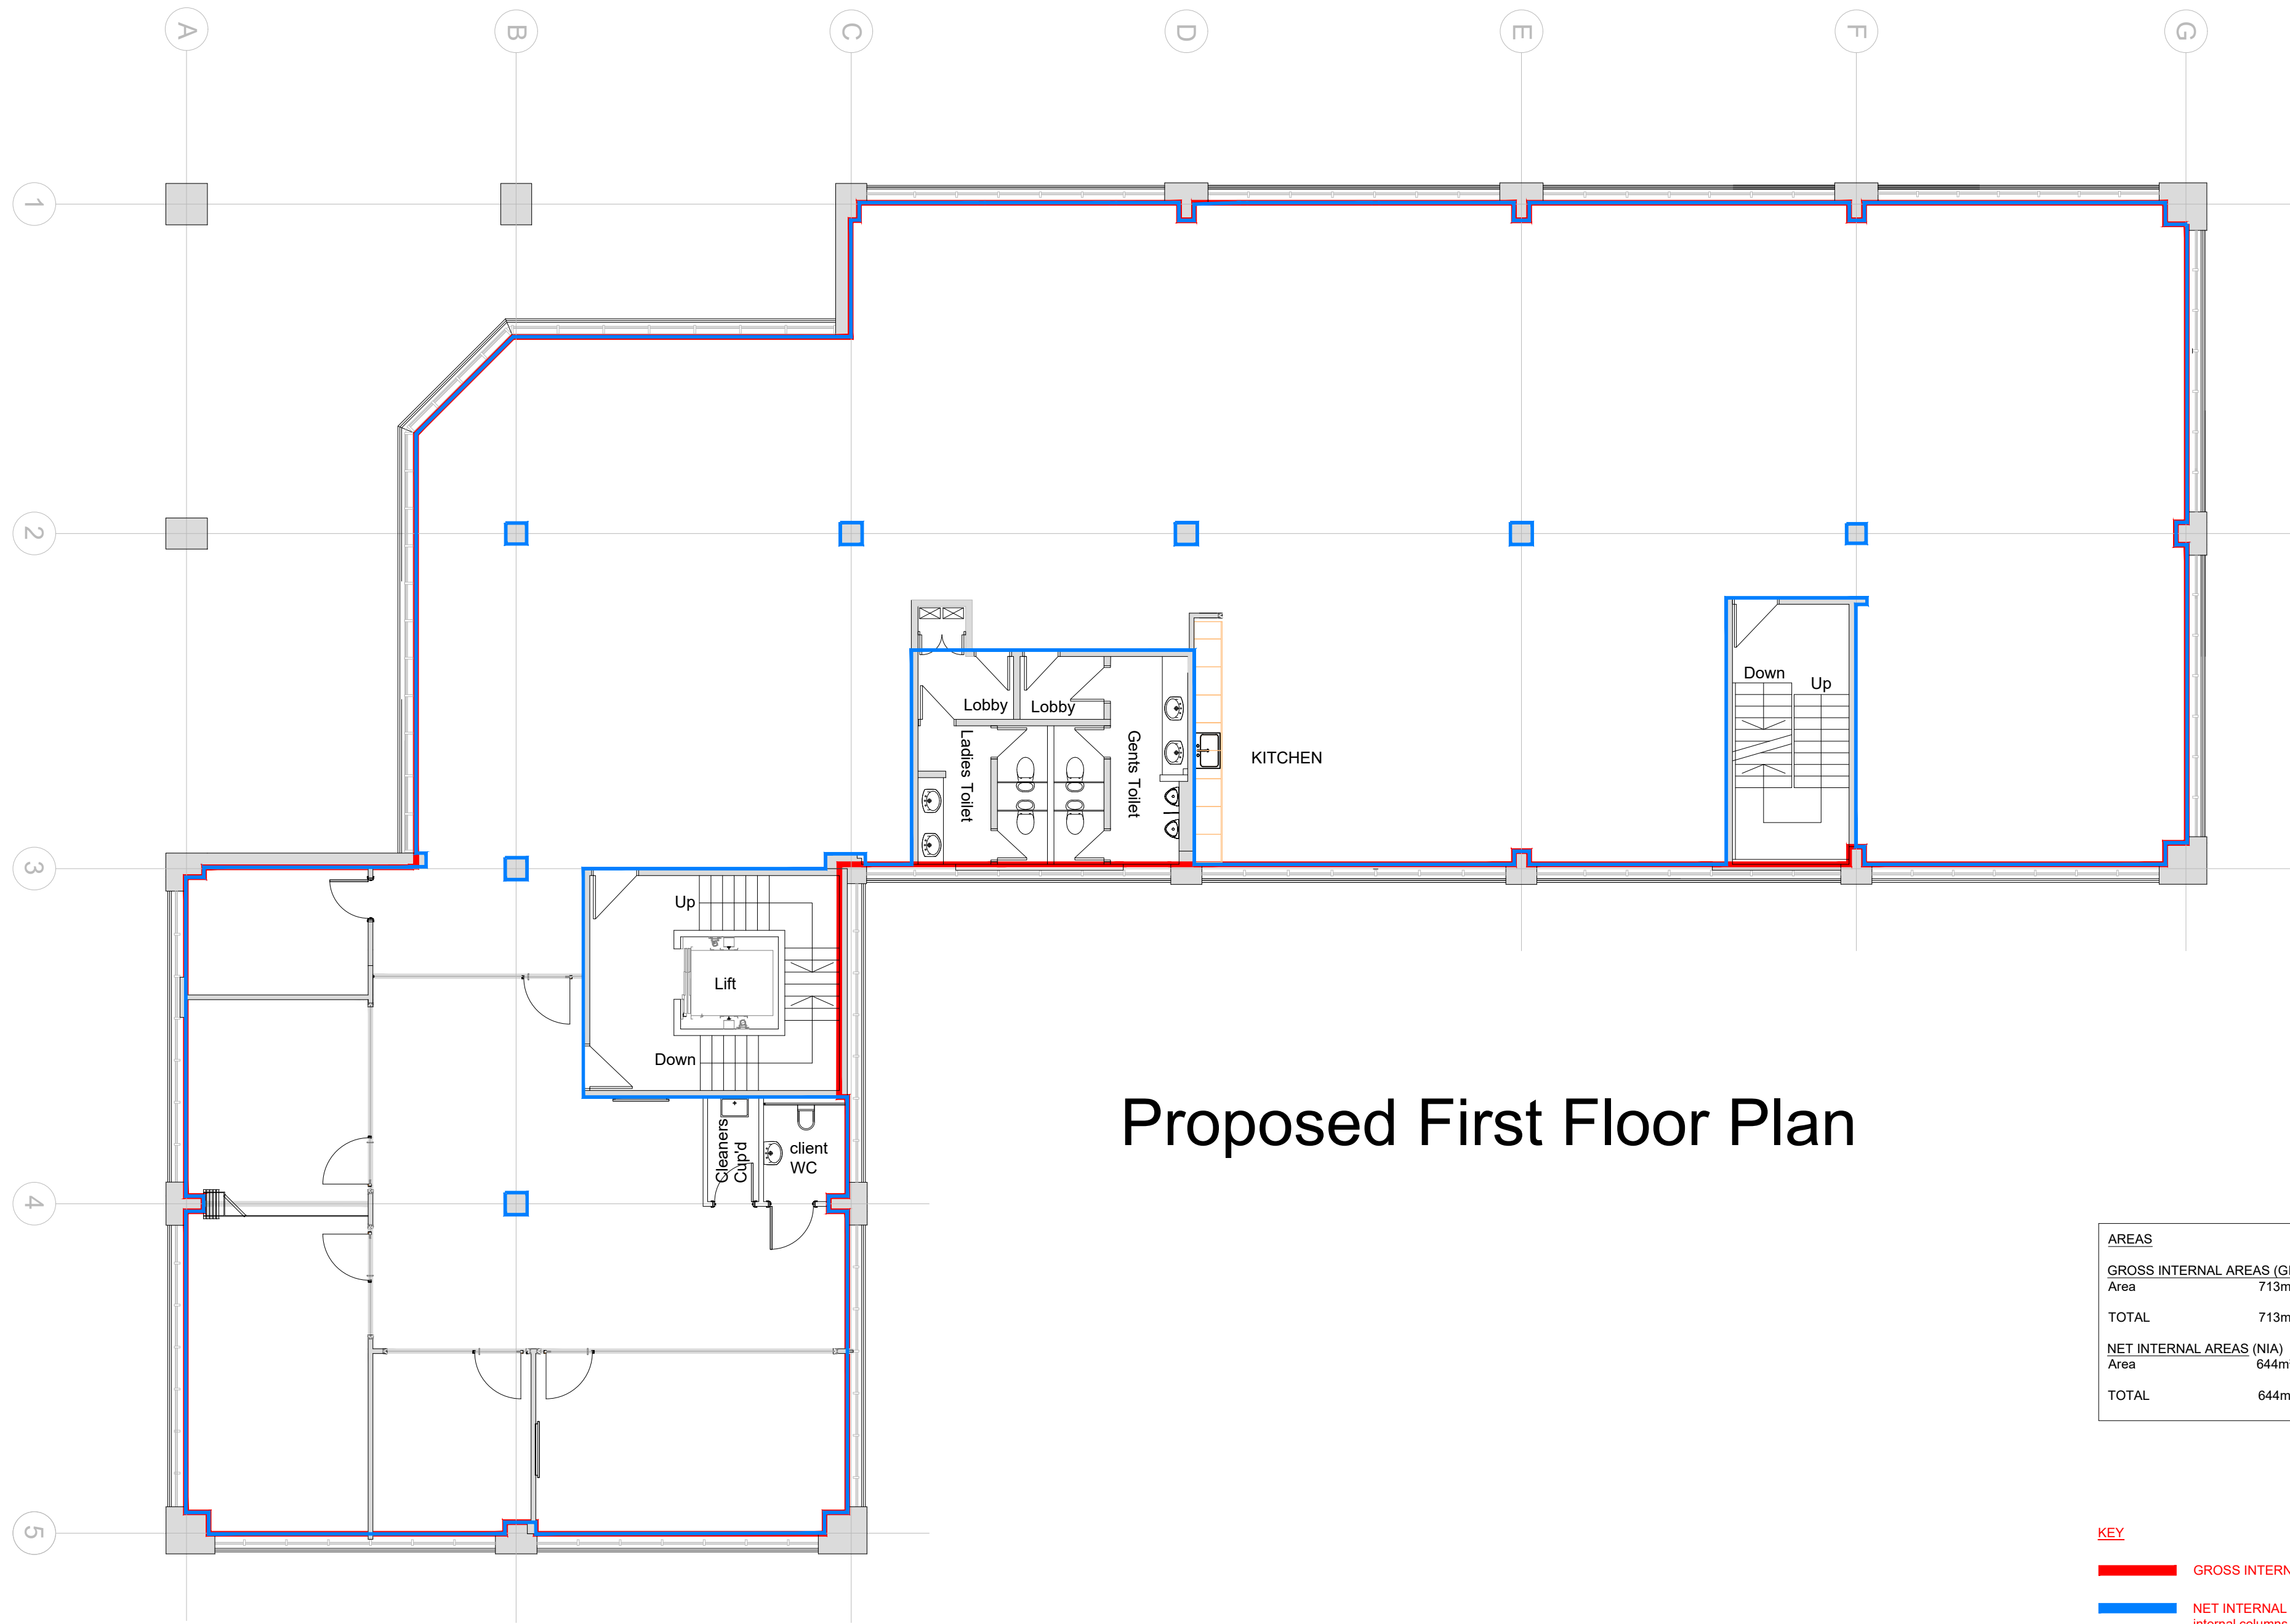

Proposed First Floor Plan

AREAS		
GROSS INTERNAL AREAS (GIA)		
Area	713m²	7 674.67ft²
TOTAL	713m²	7 674.67ft²
NET INTERNAL AREAS (NIA)		
Area	644m²	6 932ft²
TOTAL	644m²	6 932ft²

KEY

— GROSS INTERNAL AREA - GIA

— NET INTERNAL AREA - NIA (The internal columns have been subtracted from the area)

TEW AND SMITH

ARCHITECTS AND SURVEYORS

Drawing issue: AS BUILT

Revisions:

A 18.05.14 JT Revisions to partitions.
B 26.05.14 JT Door spec to client area revised. Notes to wall types revised.
C 09.07.14 JT Dims added to toilet.
D 14.07.14 JT Door nos added.
E 16.07.14 RB Door veneer clarified, access control added special skirtings noted
F 21.07.14 RB Notes adjusted to suit wall type line type.
G 21.08.14 JT Glazed panel to server room partition removed.
H 22.08.14 JT Dimensions added to furniture.
J 03.08.14 RB Kitchen wall n/a dimensions added.
K 05.09.14 JT Lobby to ladies toilet revised to accommodate elec. distrib. boards.
L 05.09.14 JT Net internal area revised.
M 26.02.15 As Built.
N 27.03.2025 Fit-out removed.
P 22.04.2025 NIA line and area update.

Project:

Moorgate House
201 Silbury Boulevard
Milton Keynes MK9 1LZ

Title:

Proposed First Floor Plan
Partition Layout

Date: 14-03-14

Drg No.

Rev:

Scale: 1:100@A1

4338/SK04

P

Drawn: JT

Checked: BF

© Proprietor: Tew and Associates Limited

QUOITS HOUSE, 4 HARBOROUGH ROAD,
KINGSTHORPE, NORTHAMPTON, NN2 7AZ
TEL: (01604)791197 FAX: (01604) 717991
EMAIL: architects@tewassociates.co.uk
WEB: www.tewassociates.co.uk