



This drawing is protected under Copyright and at no time must any portion of this drawing be reproduced or copied in any way without the permission of Morgan Lovell.

All dimensions must be checked on site and NOT scaled from this drawing.

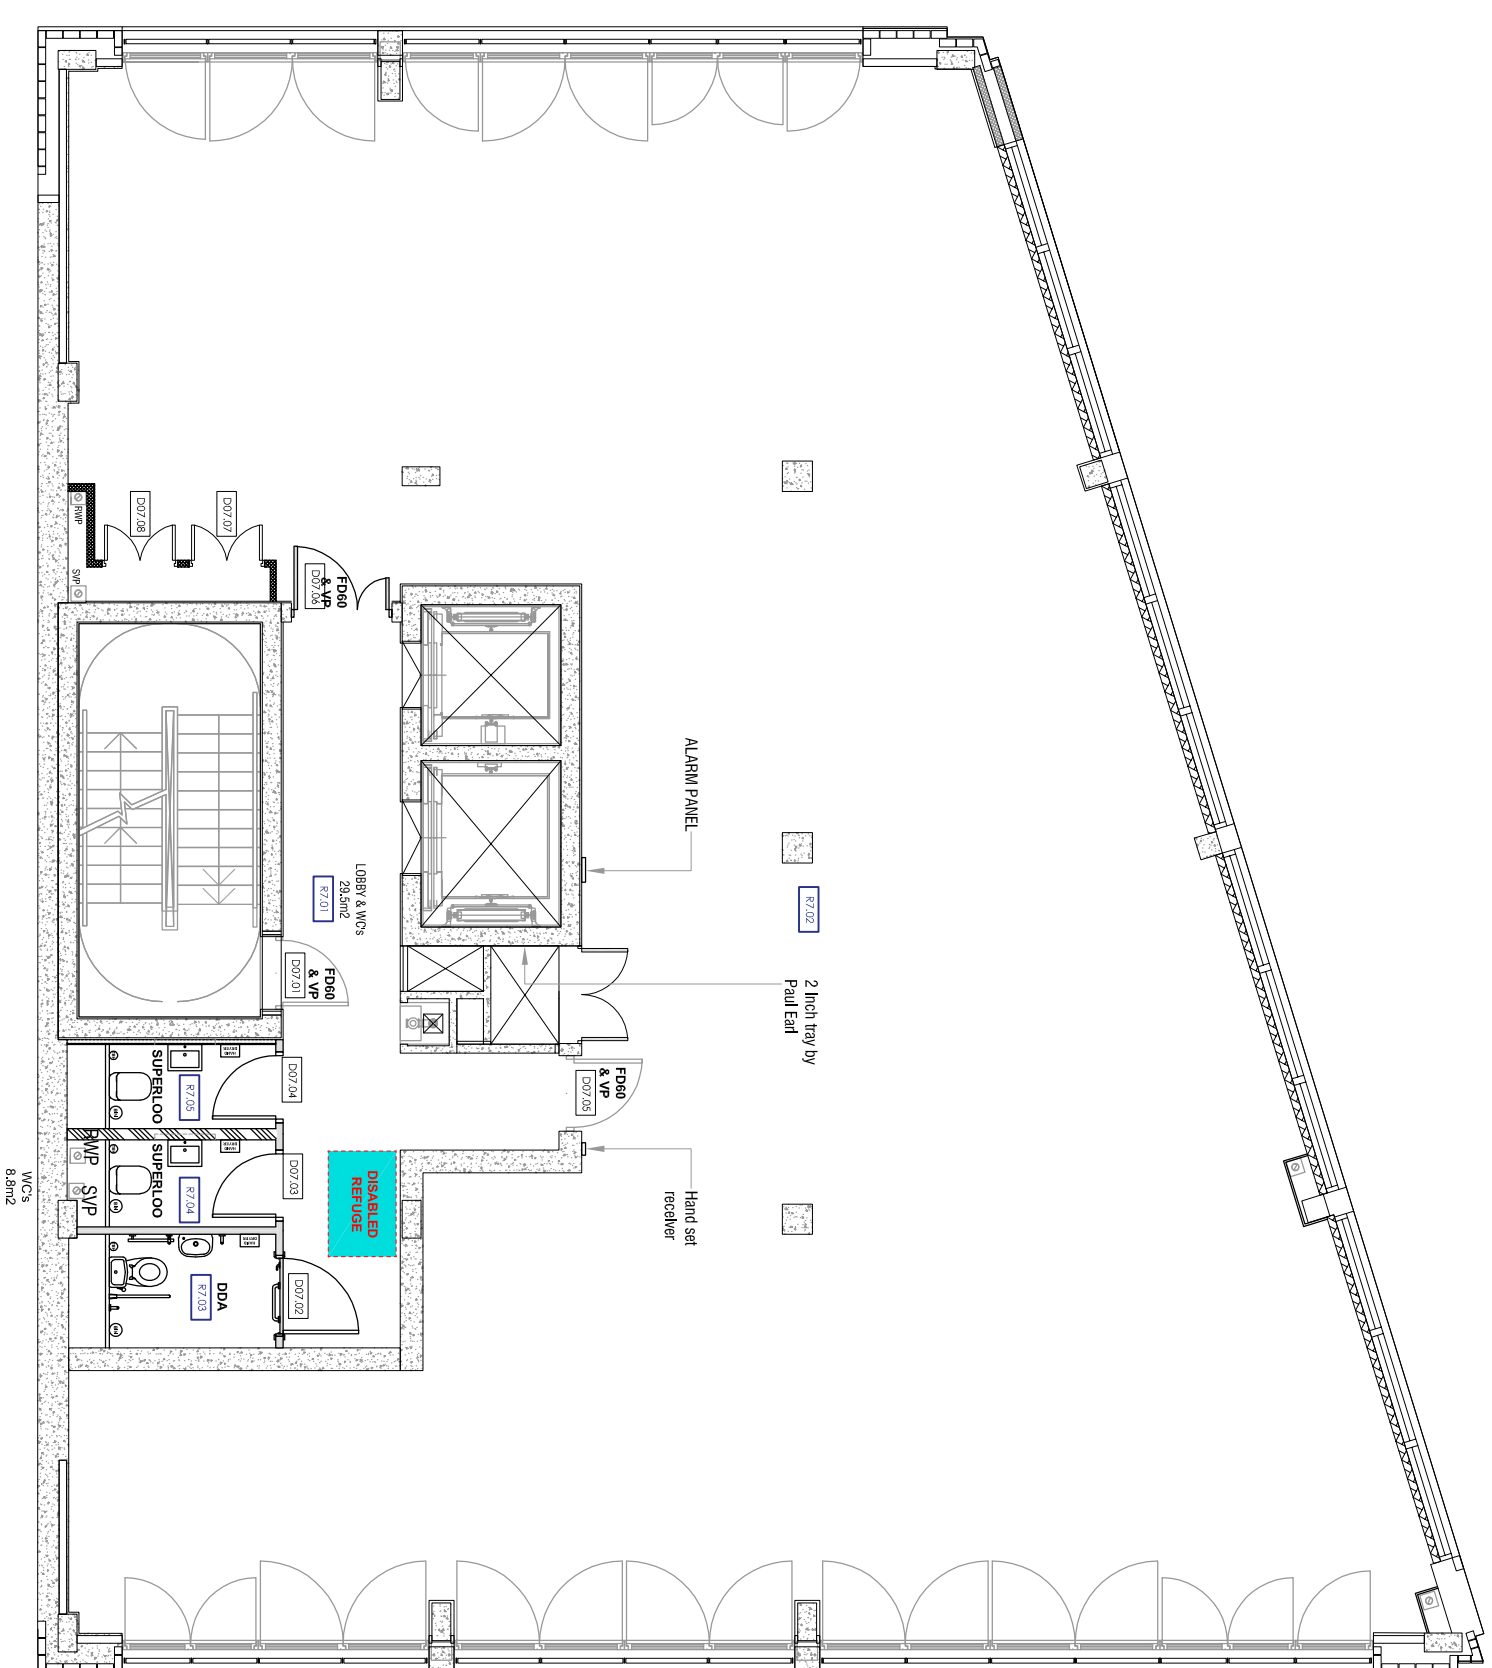

SEVENTH FLOOR
NIA = 246.06m²

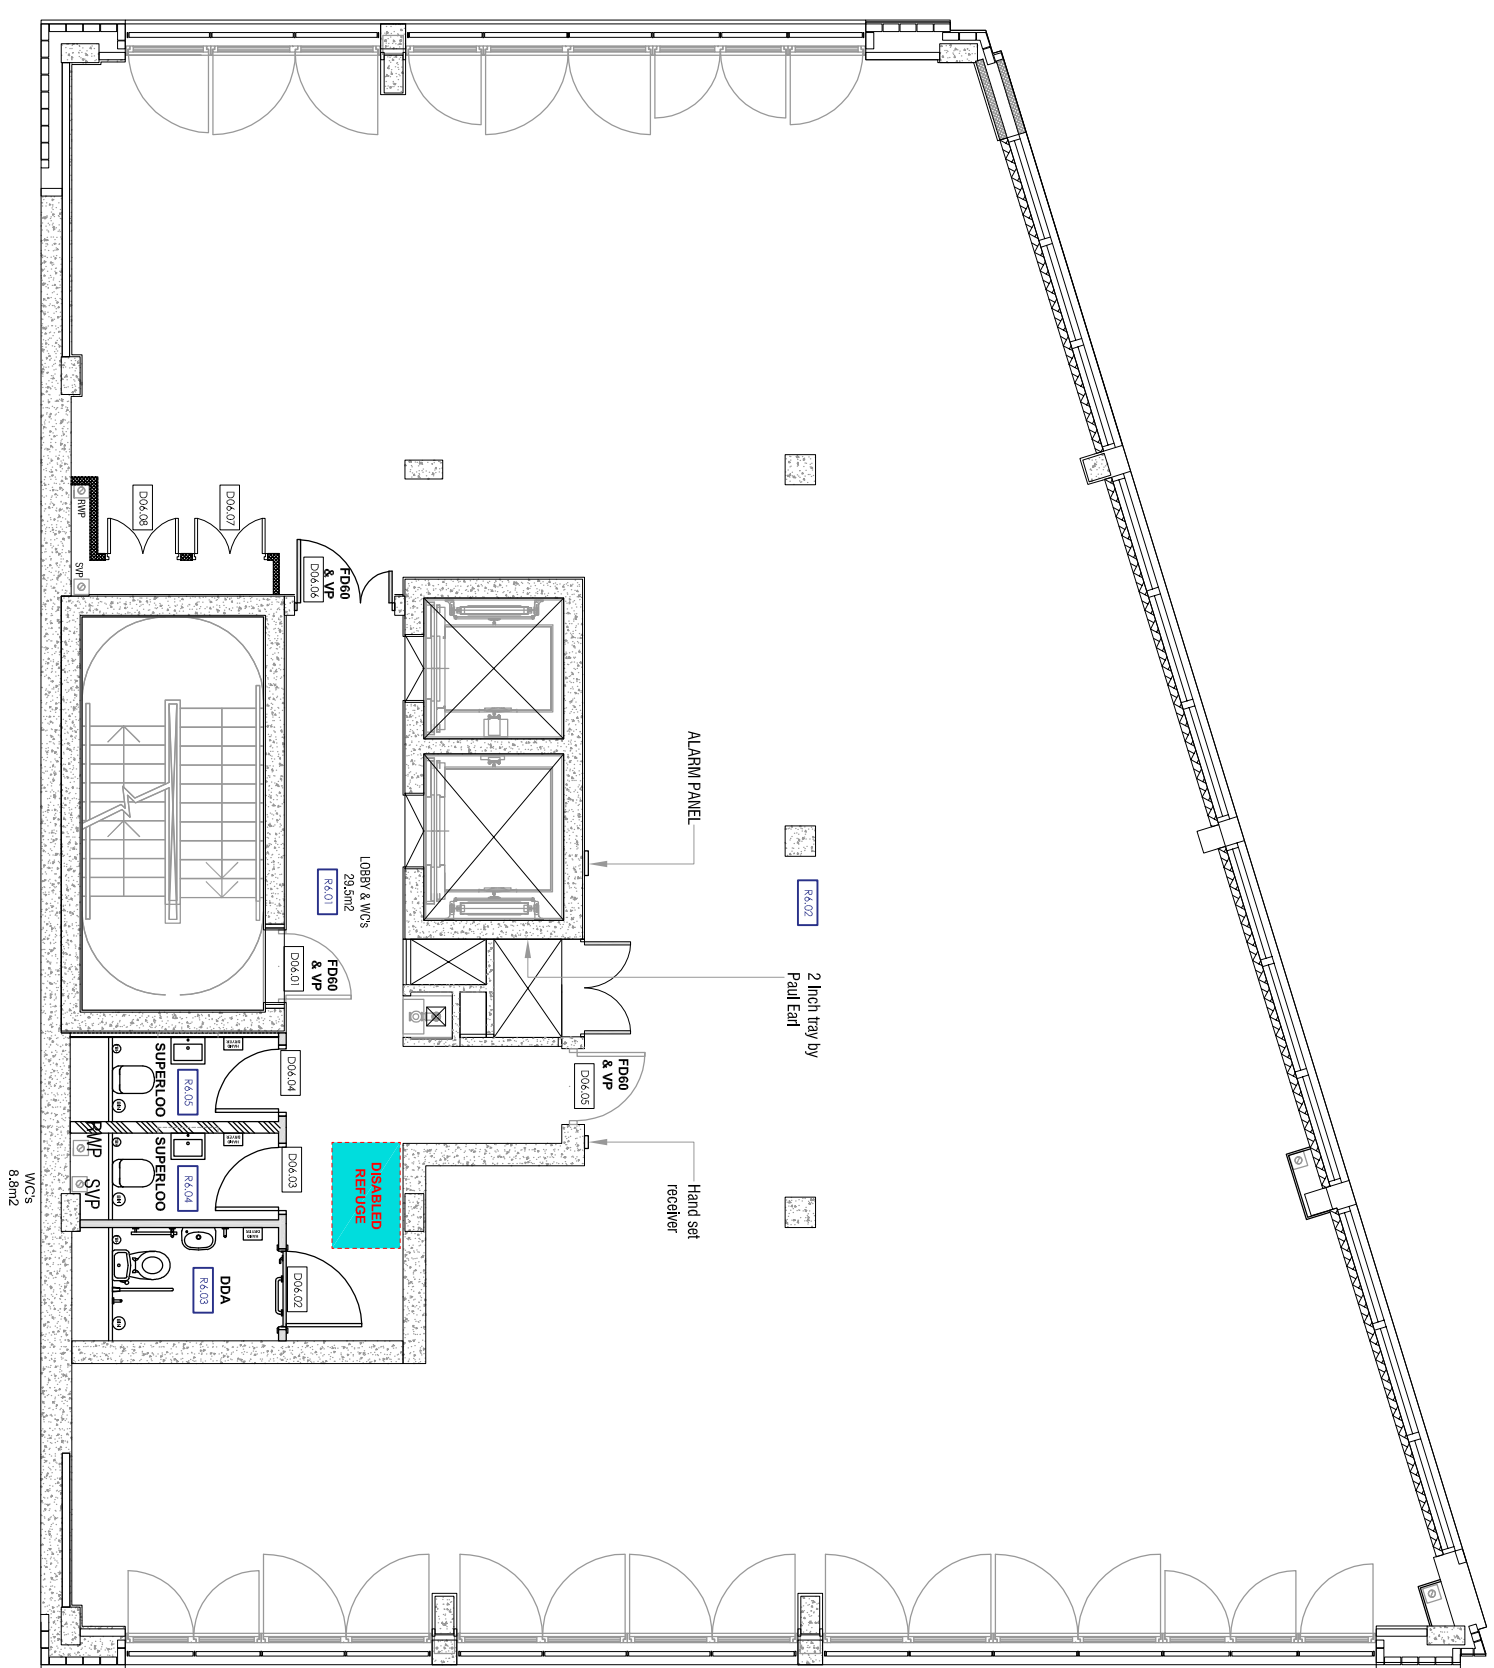

SIXTH FLOOR
NIA = 246.06m2

[illegible]

AS BUILT

Morgan Lovell

16 Noel Street London W1F 8DA
T: 0207 734 4466 F: 0207 734 2968 E: contact@morganlovell.com
W: <http://www.morganlovell.com>

London Square

Project
Cally Yard
Building 7
Caledonian Road
London N7 9BQ

Sixth & Seventh Floors General Arrangement

Scale 1:100 @ A1	Date June 19	Designer/Drawn By ML	Checked By / Date NB
---------------------	-----------------	-------------------------	-------------------------

Project No.	Floor	Drawing No.	Rev
ML3257	06-07	B7-100	AB