


Key

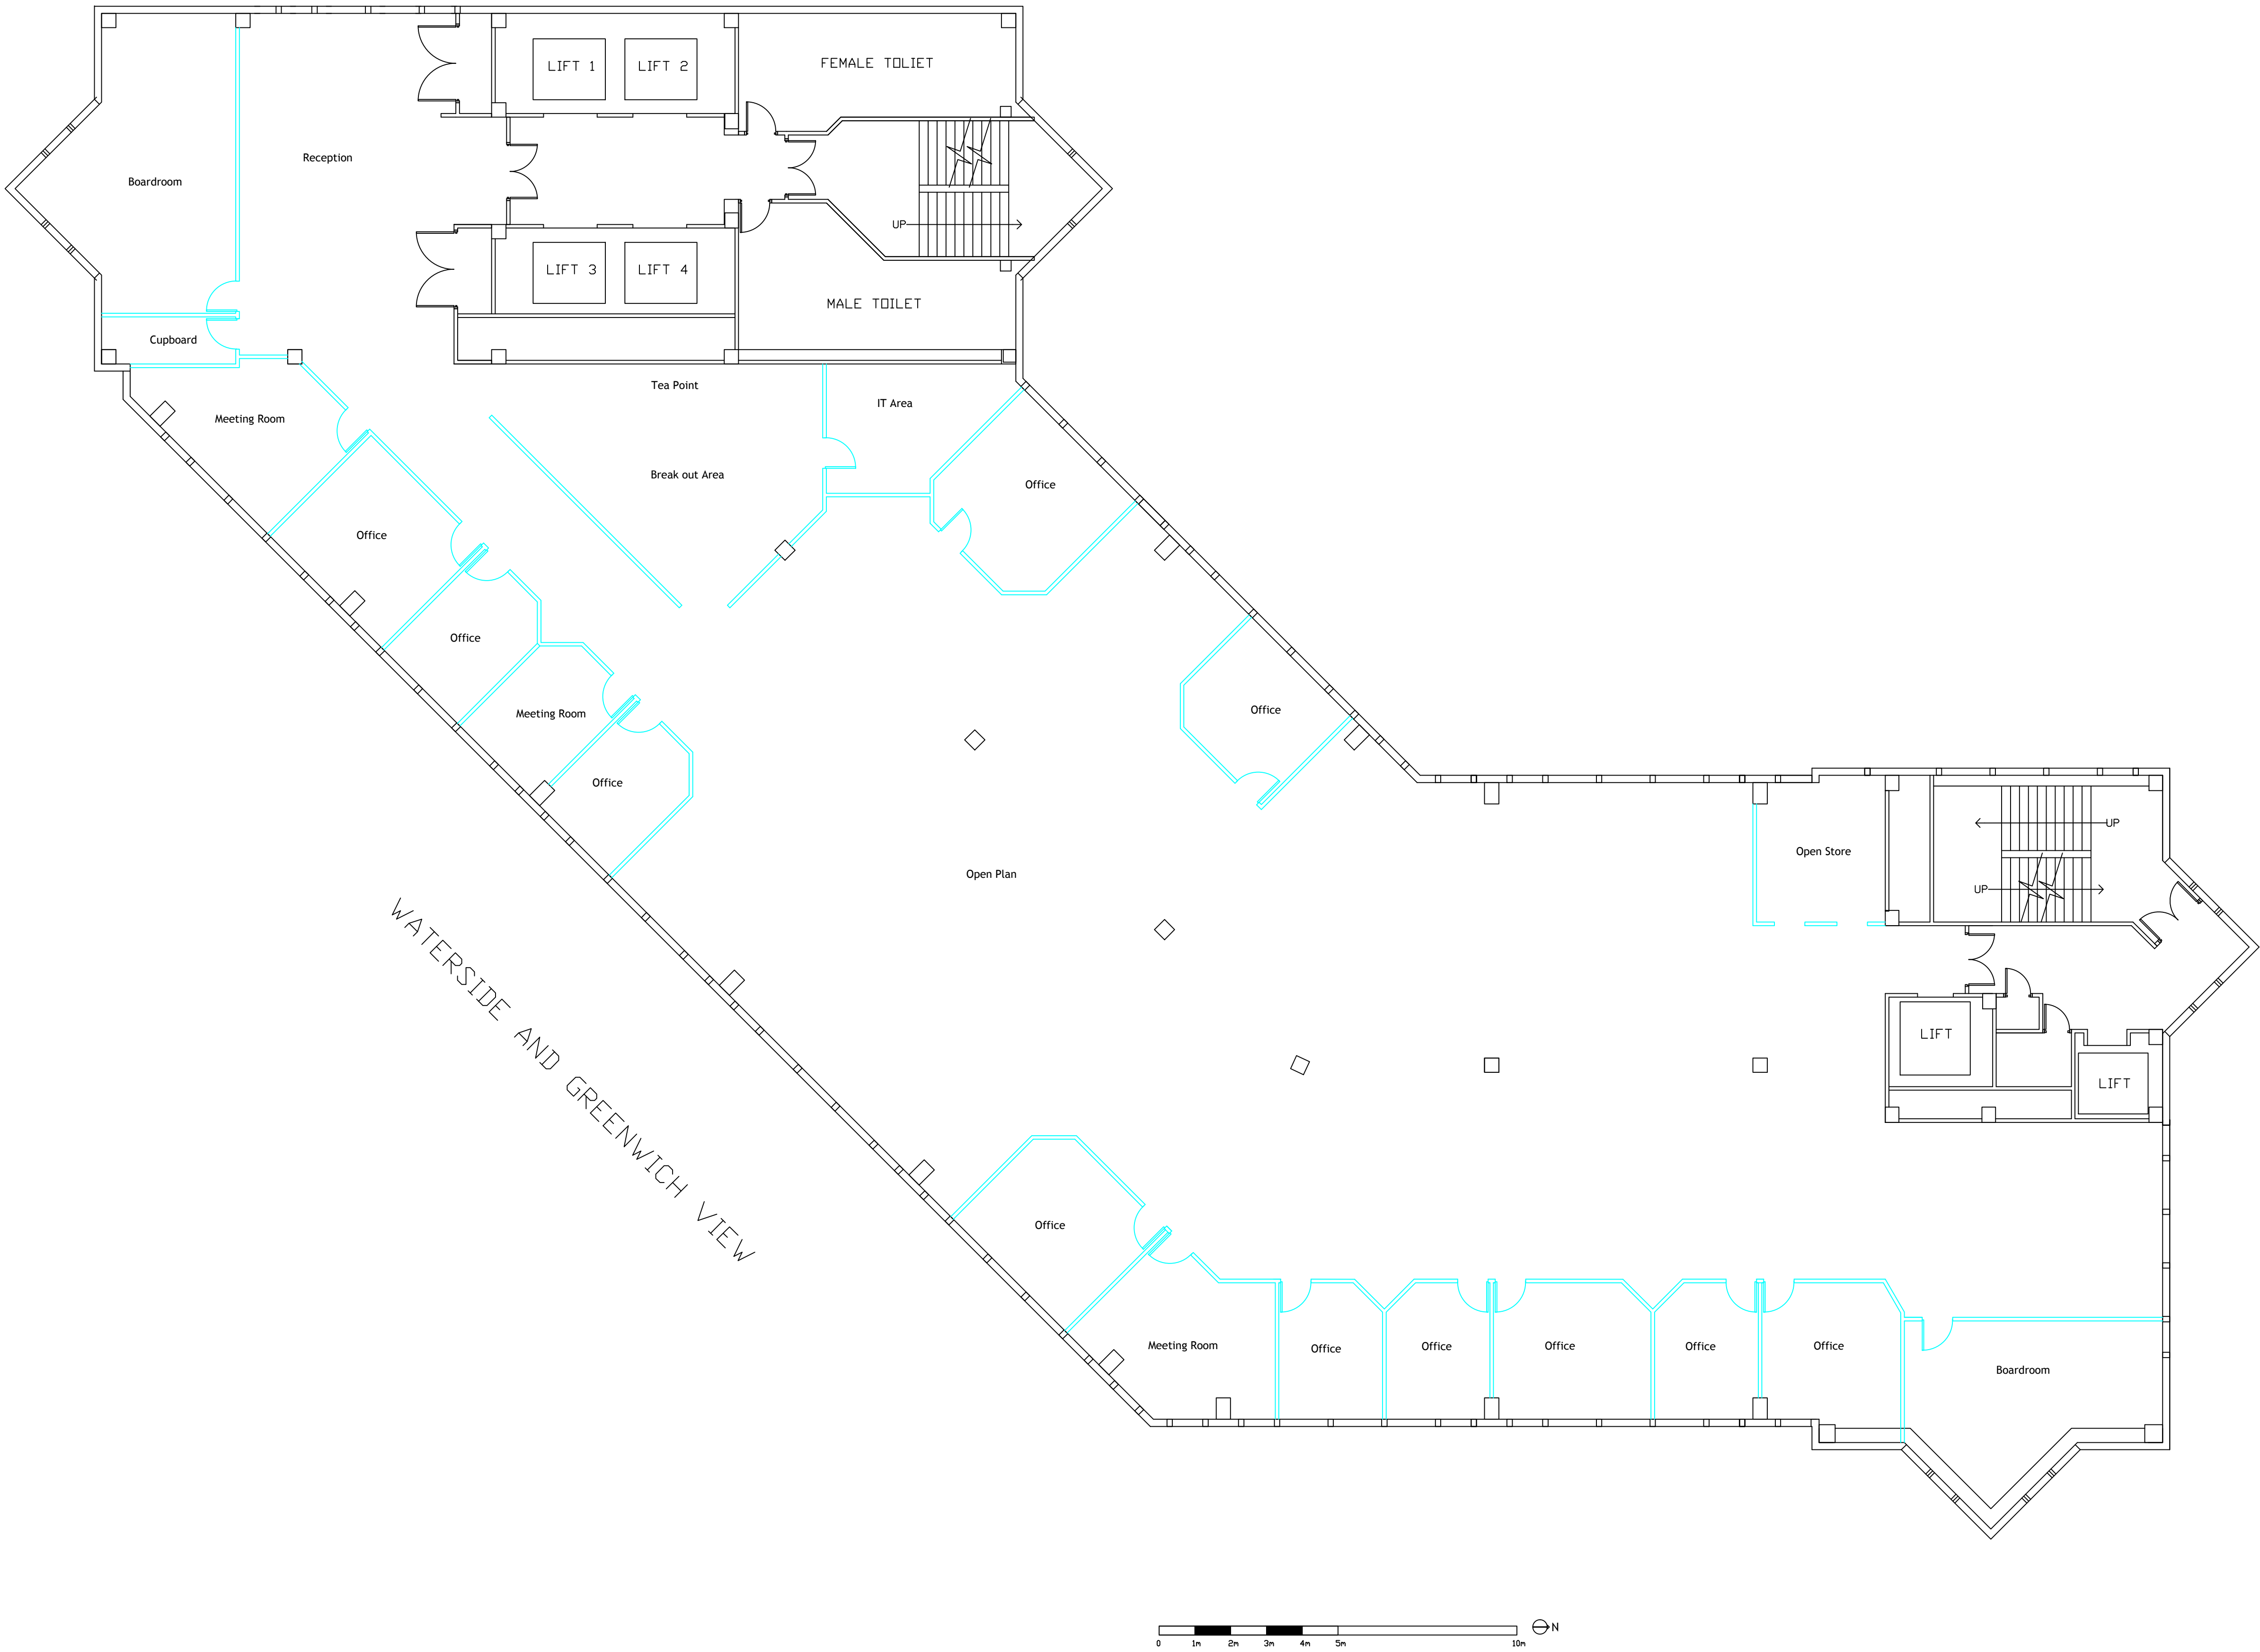

B- 12.08.15 - Addition of small office
Revision:

2Scale ltd

6, Kinfauns Road London SW2 3JL
Tel : 07903 198764
email : lisa.couse@2scale.co.uk
www.2scale.co.uk

Client
Ogden Group

Project
**City Reach, 5 Greenwich View
Place
London E14**

Title
Sixth Floor

Scale Date
1:100 @A1 12.08.15

Drawn By Checked By
LJC

Project No Dwg. No Rev.
0429 606 B