


Existing Short Section 1:200



Existing GA Floor Plan 1:200

NOTES:

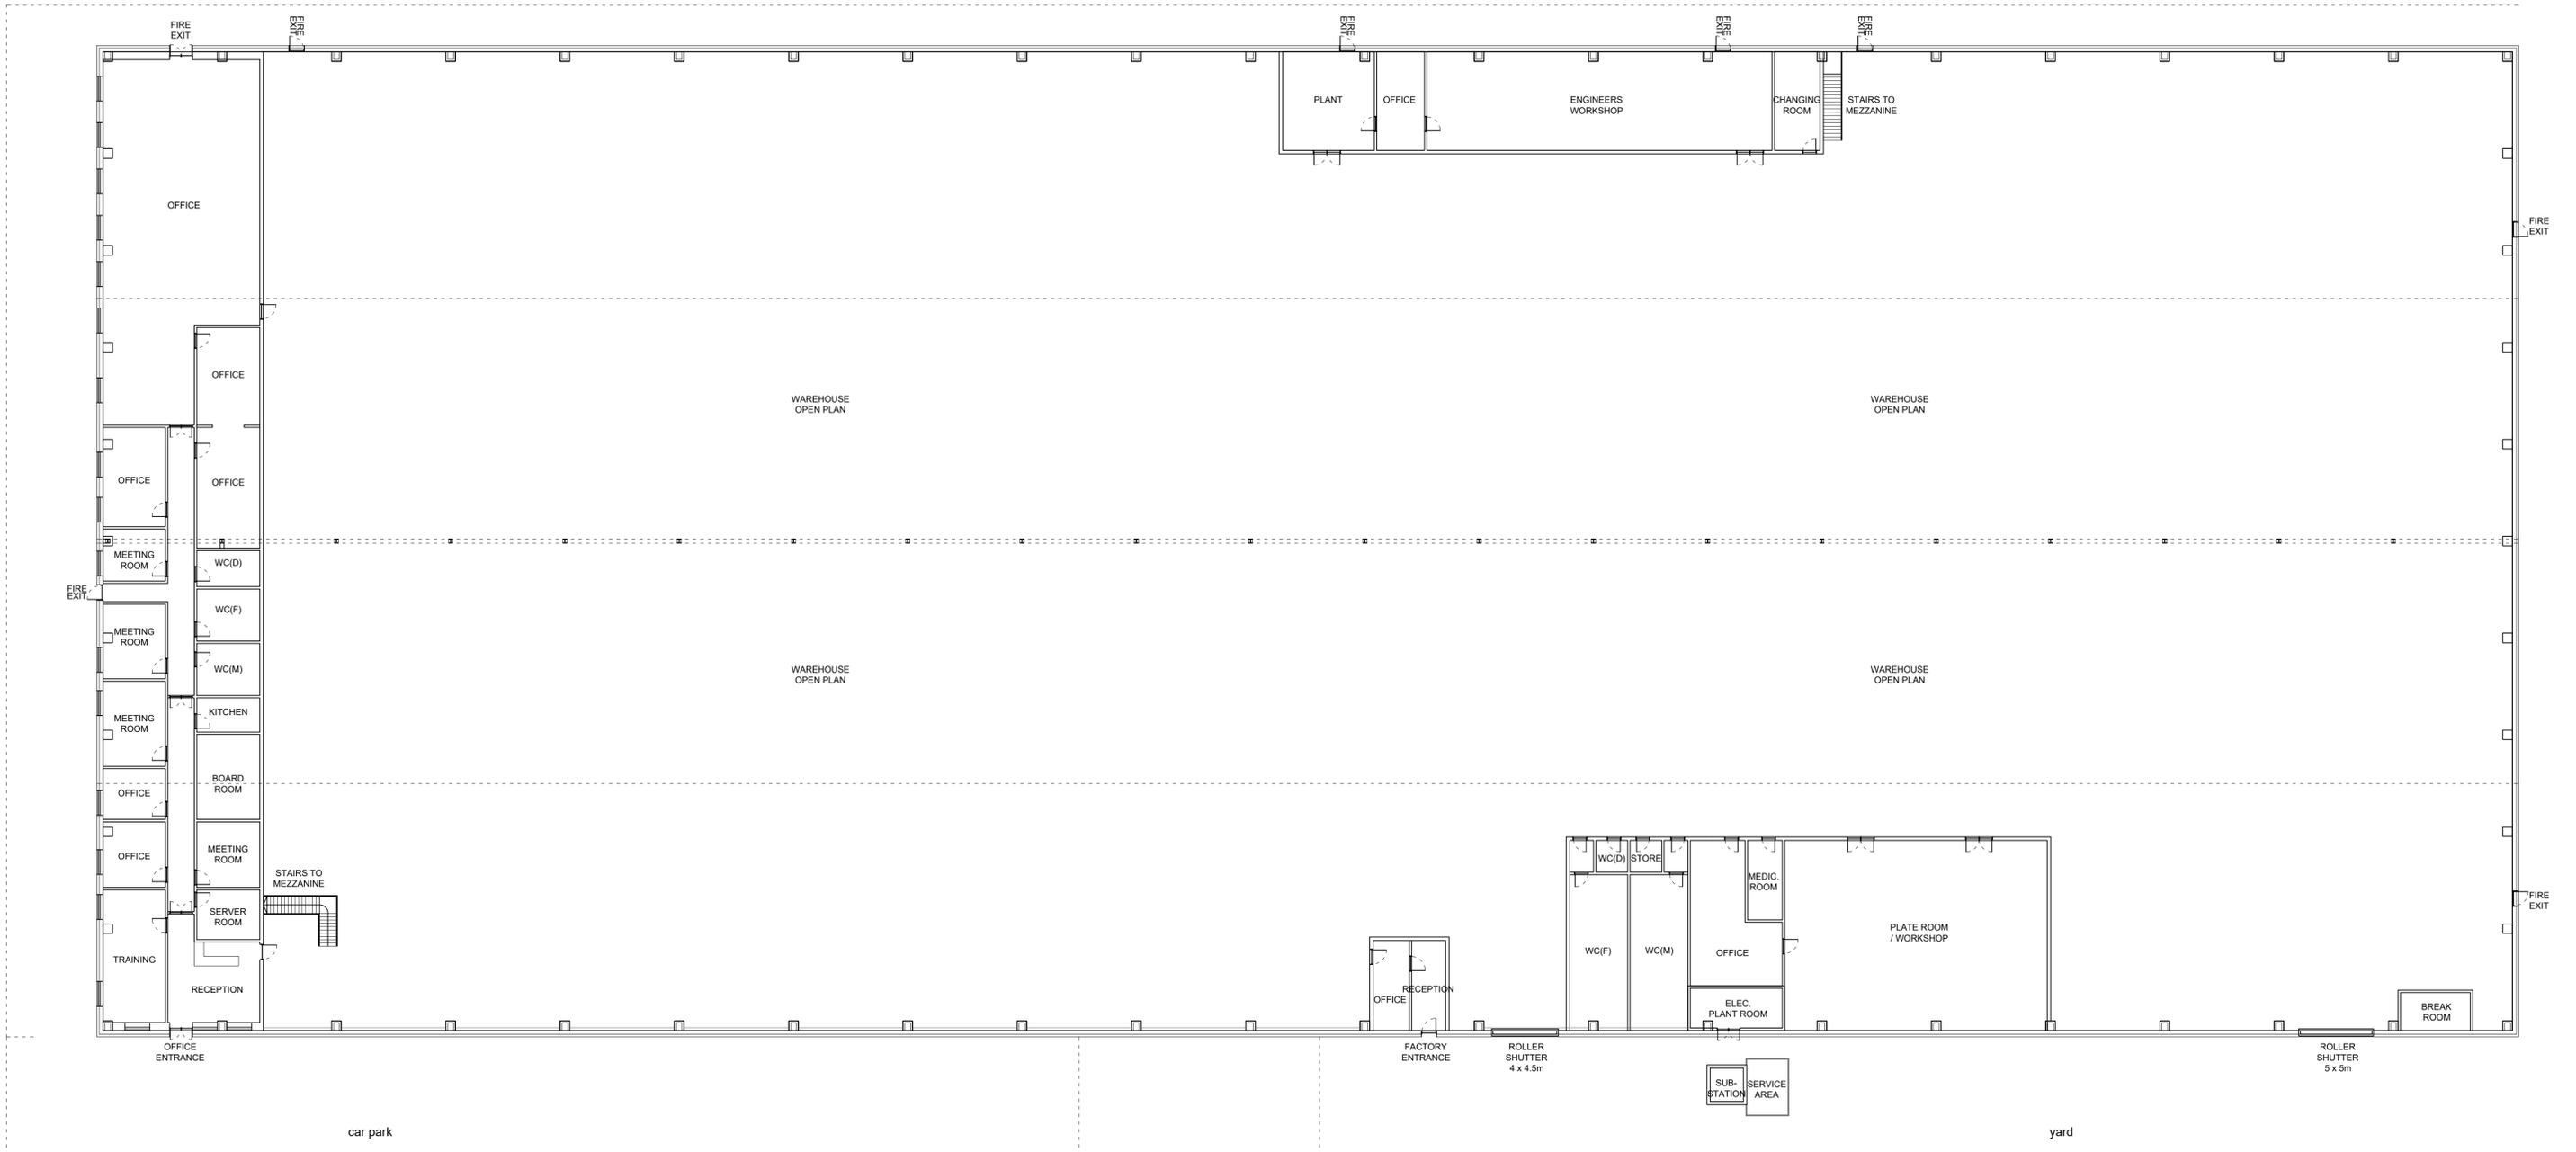

NOTES:
Orientated to fit sheet size, 1:200 @A1

PROJECT NAME
CPI William Clowes, Copland Way, Beccles NR34 7TL

DRAWING NAME
Existing GA Plan and Section

REV	DESCRIPTION	DATE
Purpose of Issue		
INFORMATION		
Drawn	Checked	-
Date	18.11.25	
Scale	1:200	@A1
Project Number	4075	Sheet Number
		03-001
		Rev
		-

© Copyright
Once printed and distributed this document is assumed uncontrolled.
© All rights reserved. No part of this drawing may be reproduced or transmitted
in any form by any means without the written permission of the copyright holder.