


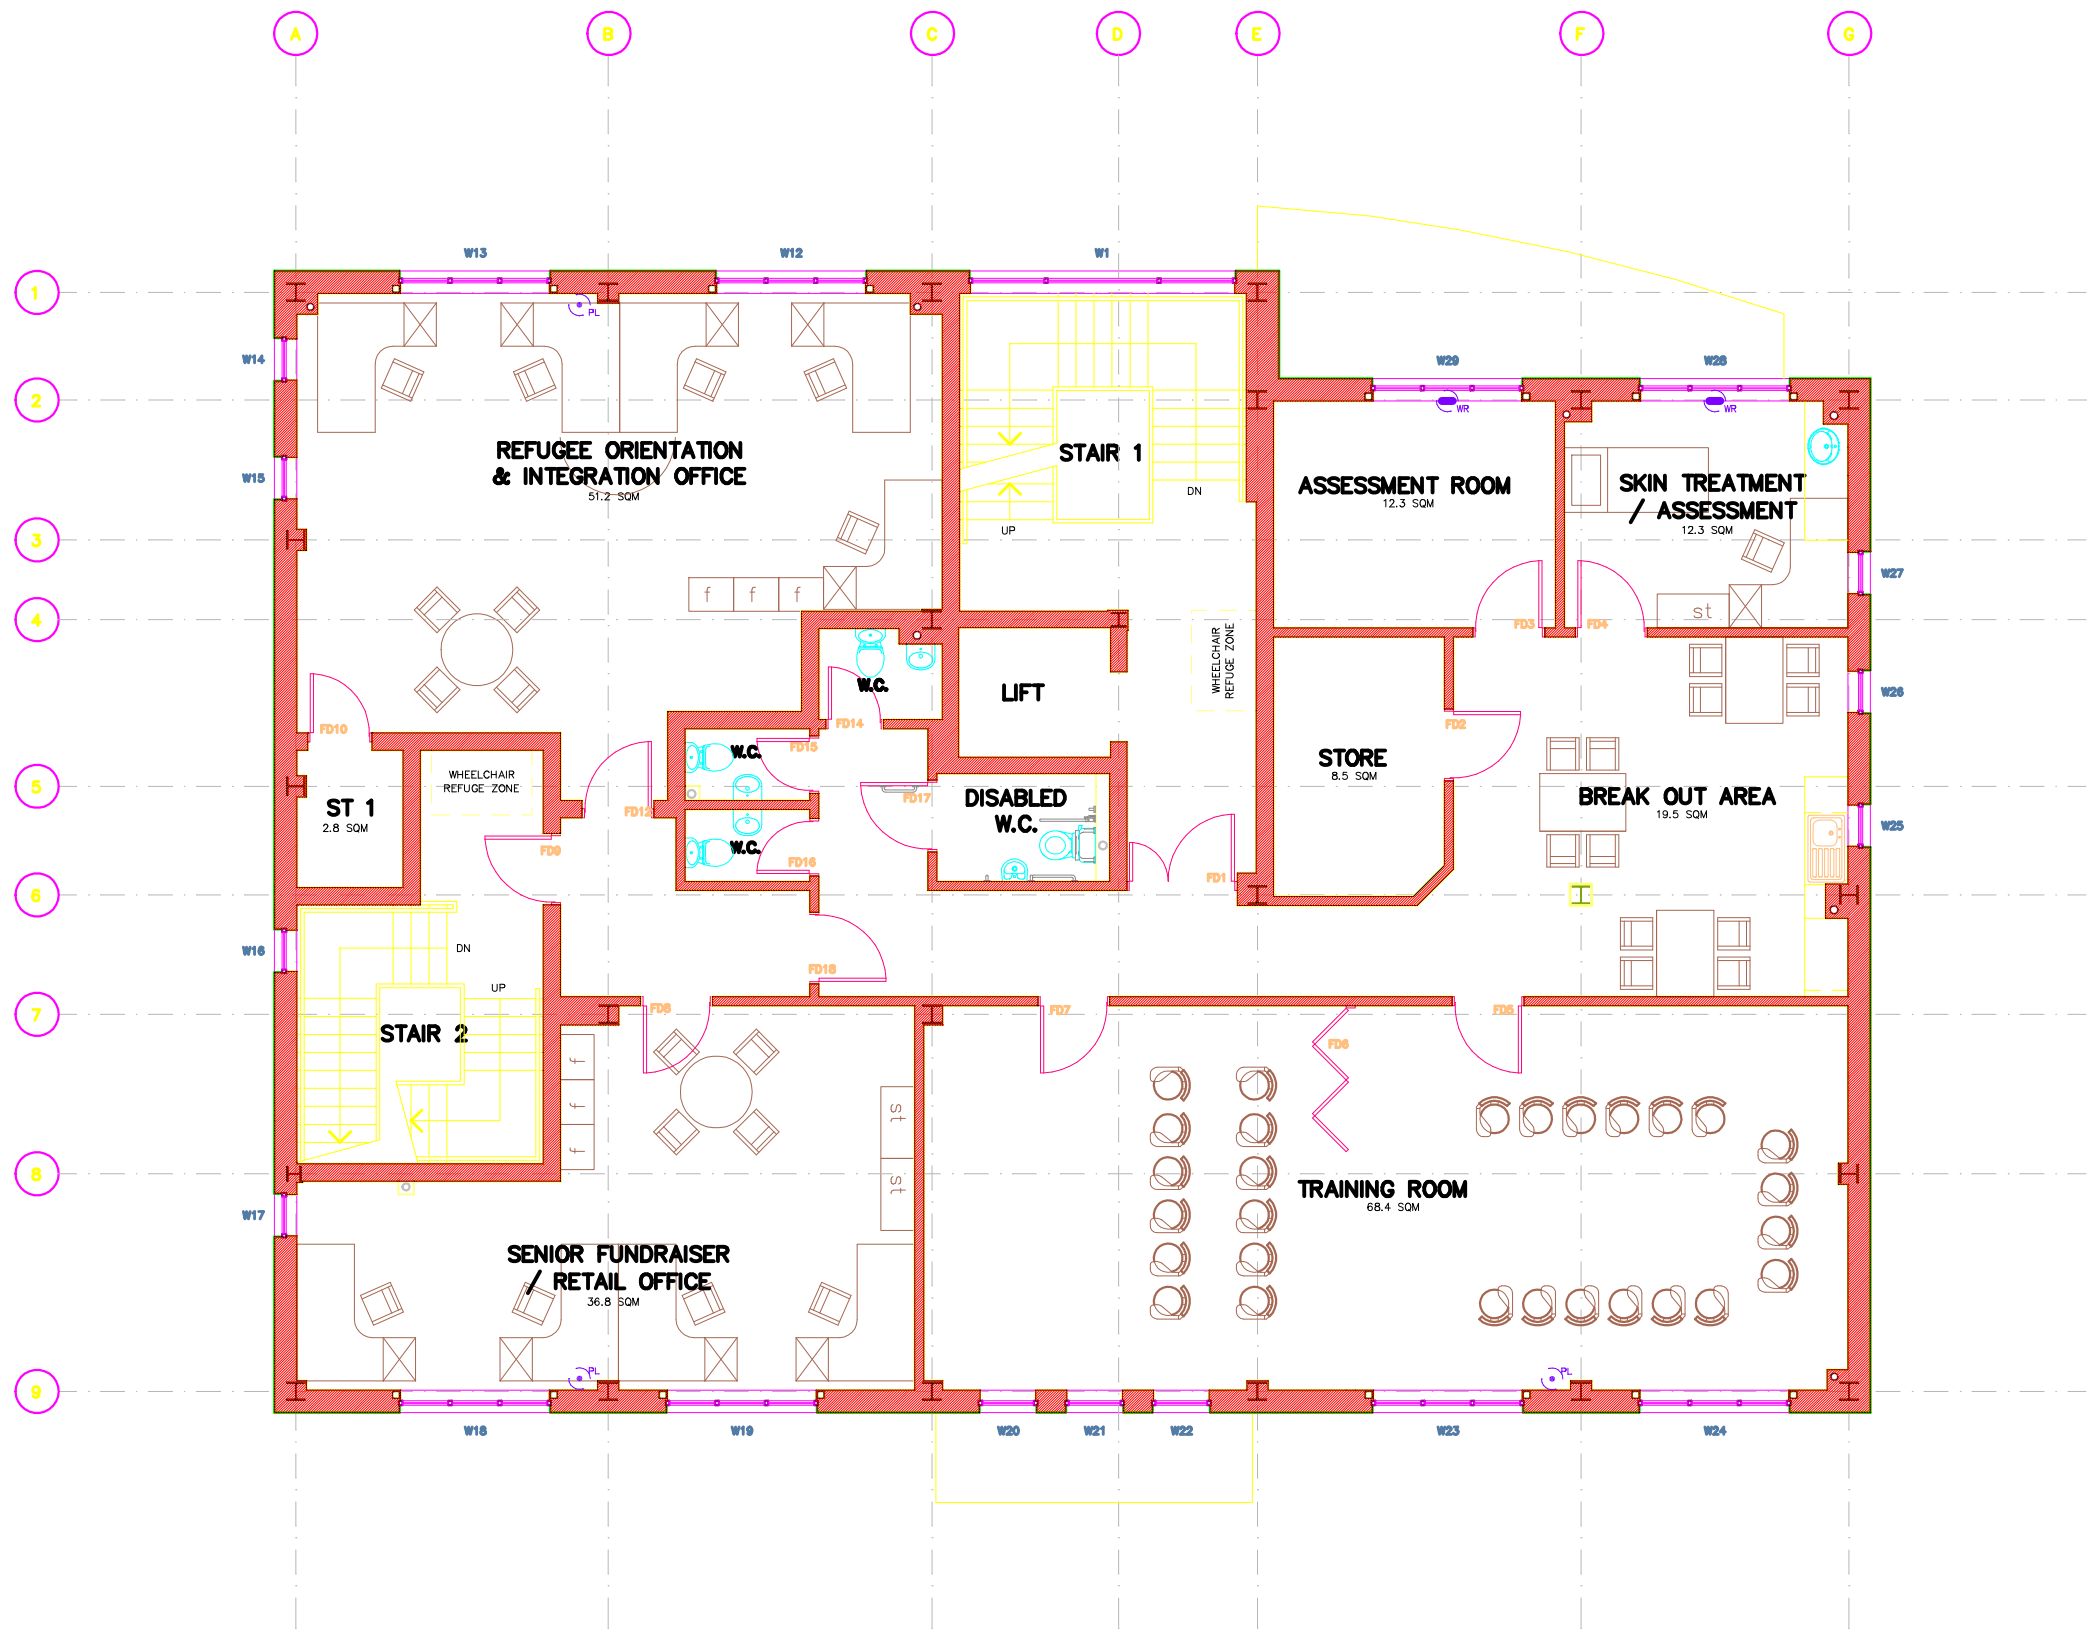

KEY

 PUSH LOCKS

 WINDOW RESTRICTORS

AS BUILT



PROJECT BRADBURY HOUSE, LOWER DOCK ST, NEWPORT.			
CLIENT BRITISH RED CROSS			
DRAWING TITLE FIRST FLOOR PLAN GENERAL ARRANGEMENT PLAN			
CF10 4AH			
DATE JAN'06	SCALE 1:50	DRWG No. 2209/AB/008	REV