


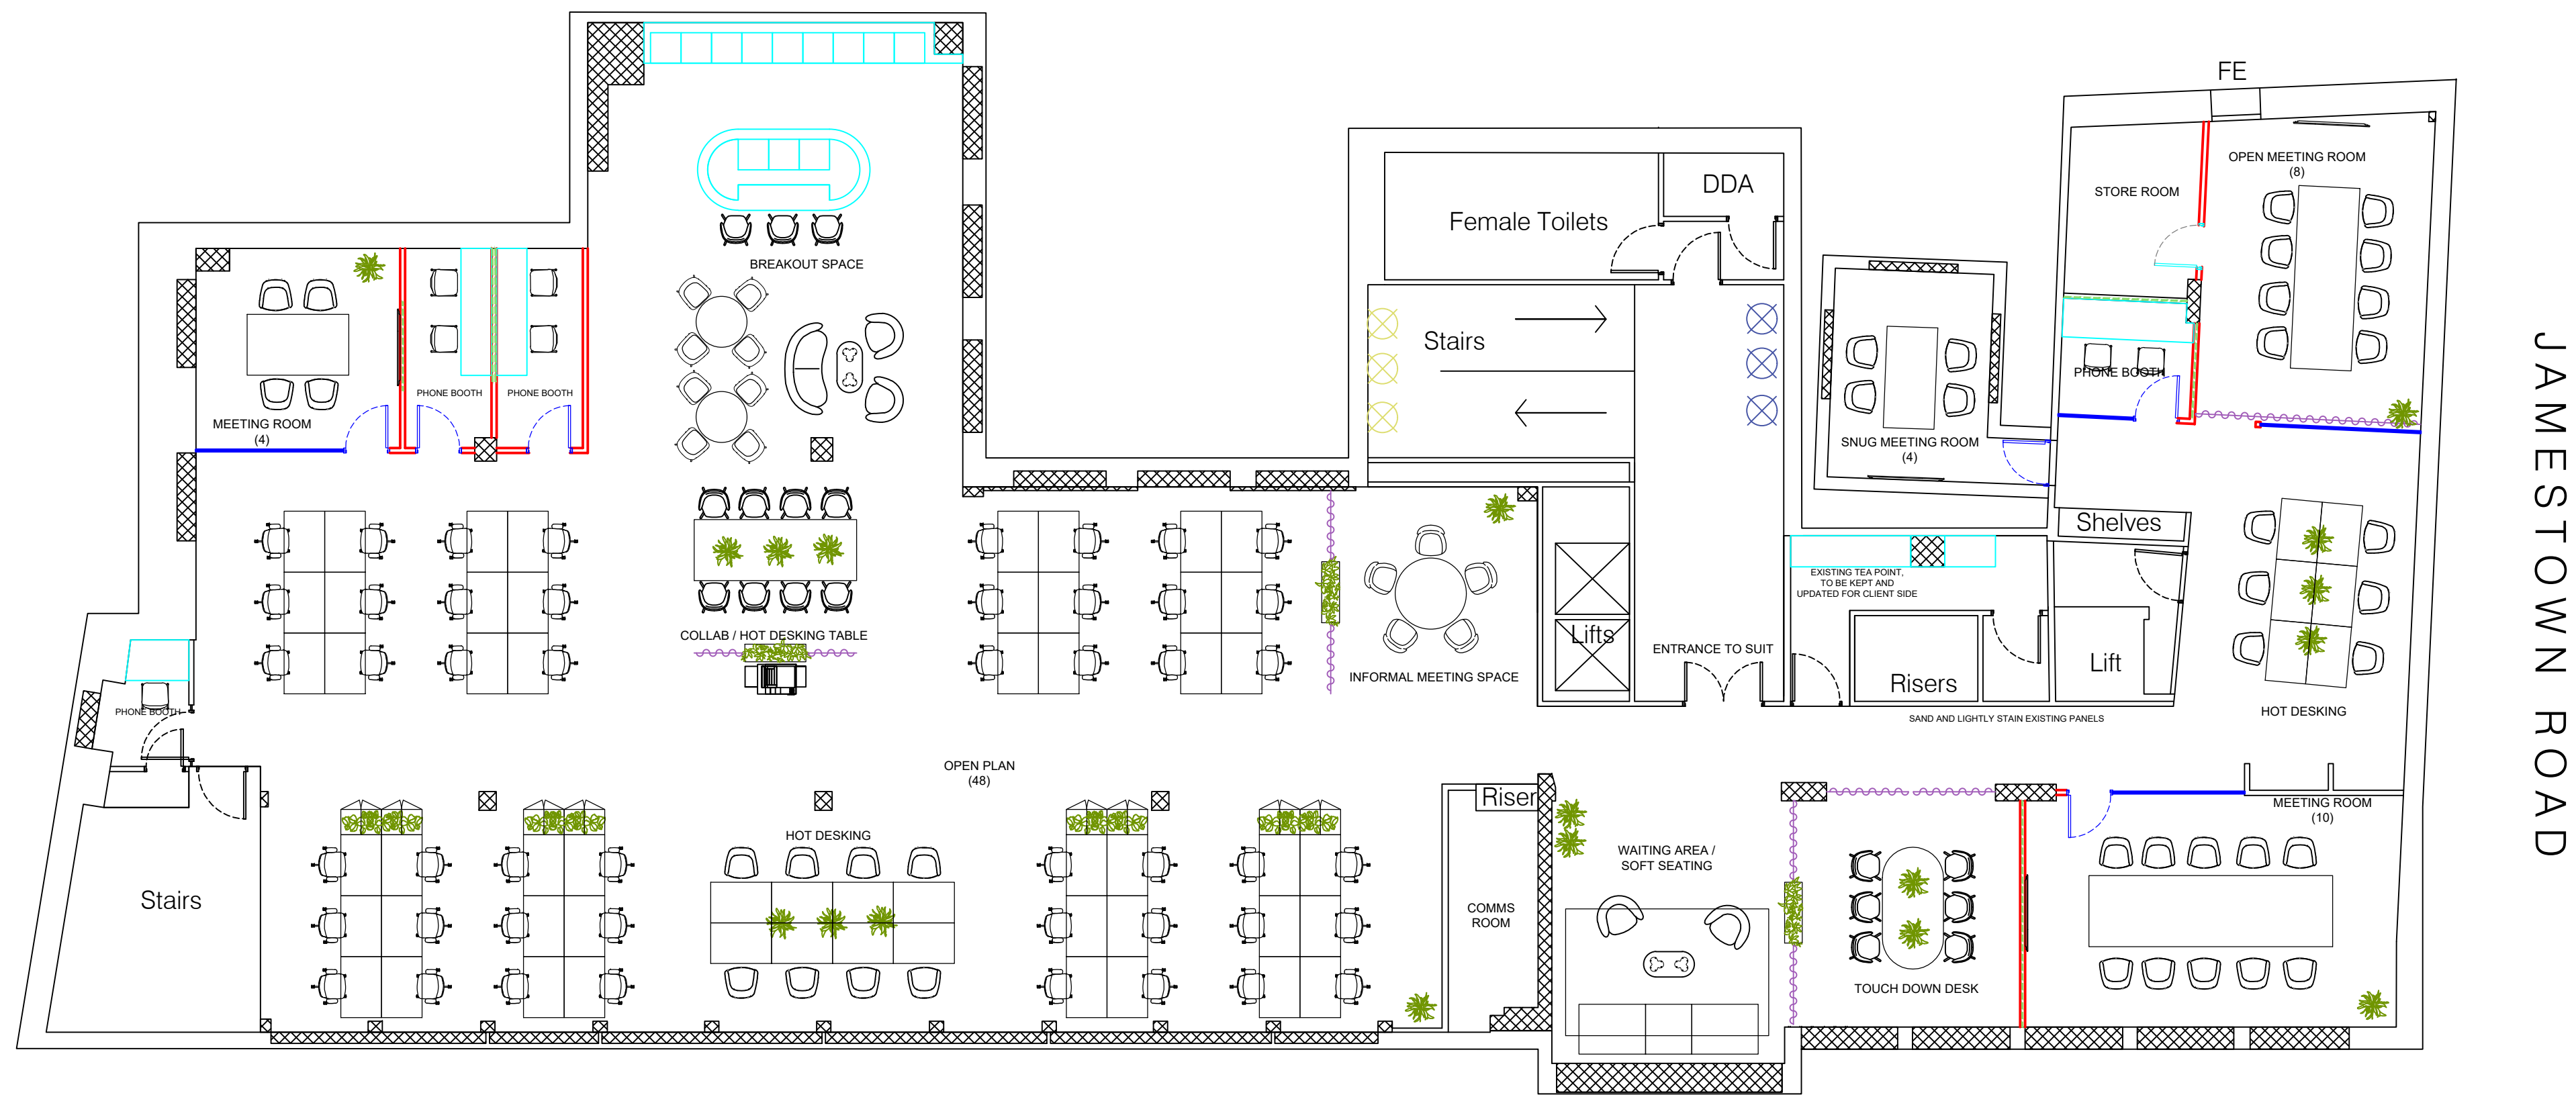

FIRST FLOOR

OVAL ROAD

notes
SUBJECT TO BE CONFIRMED BY BUILDING CONTROL

-	23/12/2024	FIRST ISSUE
rev	date	comment

client **COMPTON**
project name **CAMDEN OVAL ROAD**
drawing title **AS BUILT GA PLAN**
project number **W2374**

scale **1:100** format **A1** revision -
date first drawn **23/12/2024** drawn **KB** checked **XX**
drawing number **100** drawing status **AS BUILT**

Workspace Design & Build Ltd
t0161 710 3700 - w www.workspacedesign.co.uk
Manchester:
Northspring, Suite 1C, 70 Spring Gardens, Manchester, M2 2BQ
Leeds:
Northspring, 36 Park Row, Leeds, LS1 5JL
Midlands:
Northspring, 31 Temple Street, Birmingham, B2 5BD