

WAREHOUSE
UNIT B1

Rev

Description

Date

By

Chck'd



JLL

Real value in a changing world

Client

Scale 1:100 @ A1

Project

UNIT B1
PARKWAY
TRADING ESTATE
HESTON
TW5 9QA

Date 13 JULY 26

Description

AS BUILT
YARD ENCLOSURE

By PJ

Checked

Job

UNIT B1, PARKWAY WEST

Drg B1.FENCE.AB.12


rev

T +44 (0)20 8759 4141

F +44 (0)20 8897 4731

www.joneslanglasalle.com

DO NOT SCALE THIS DRAWING. CHECK ALL DIMENSIONS ON SITE

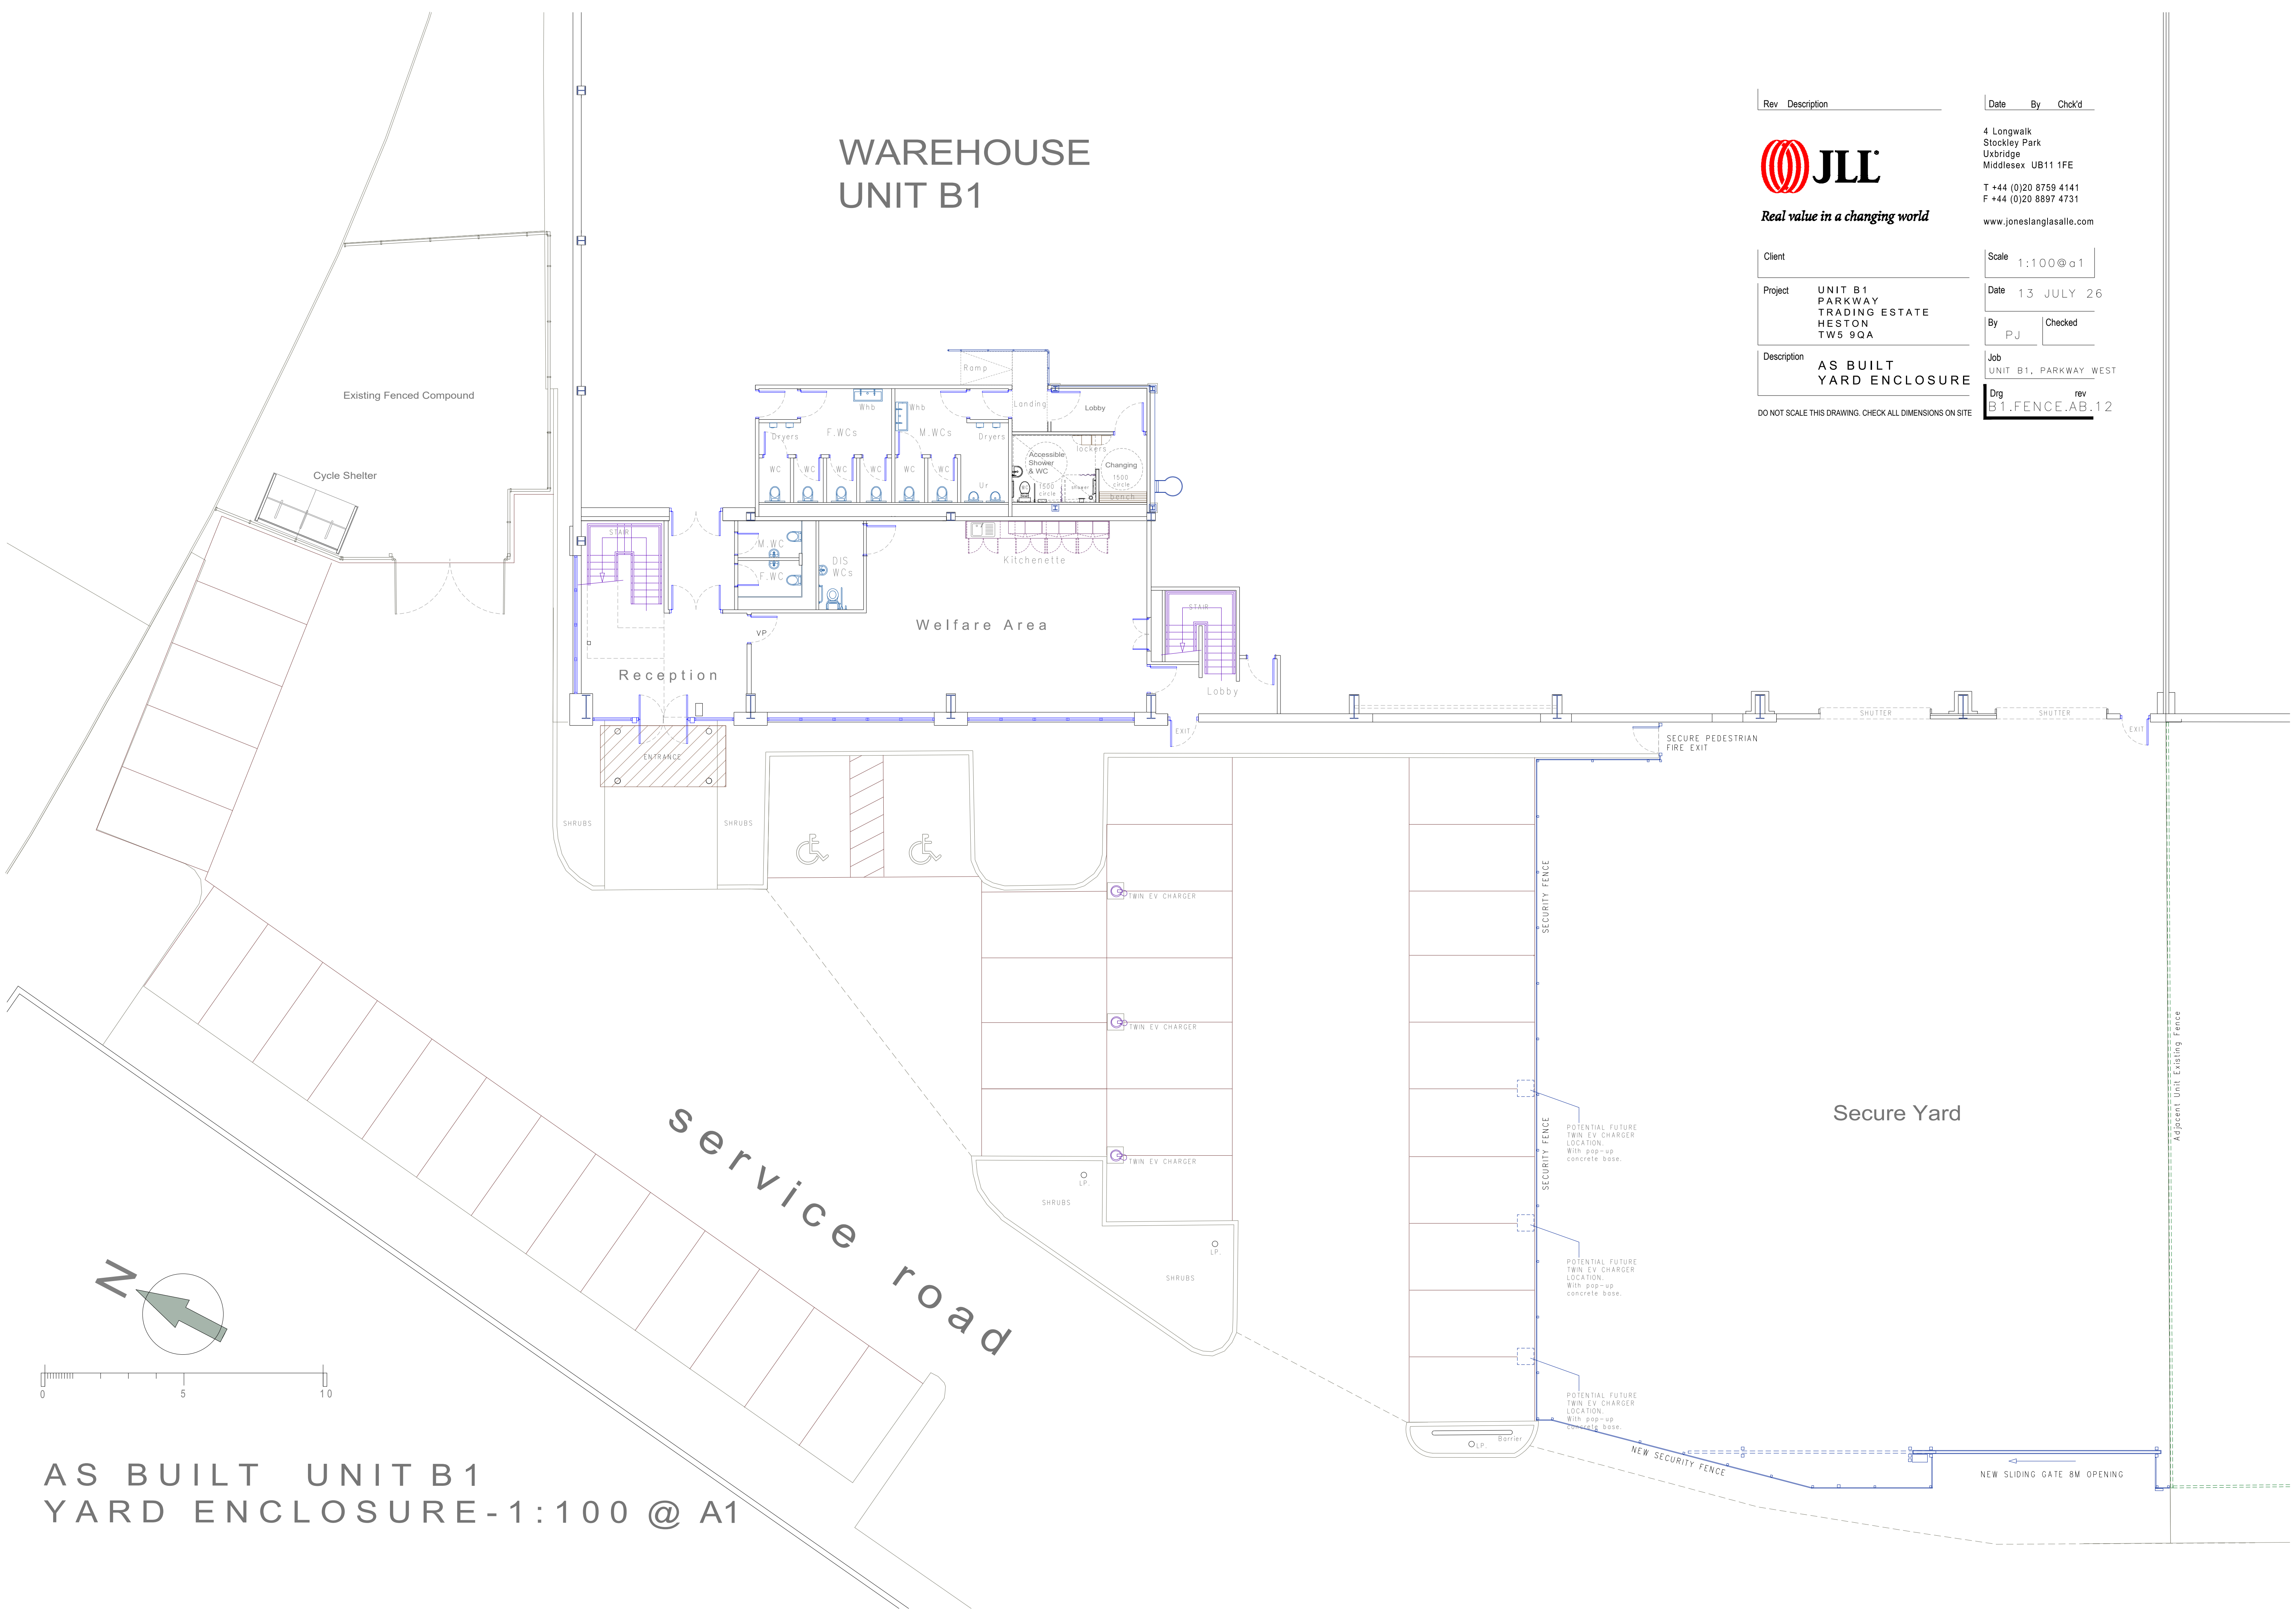

AS BUILT UNIT B1
YARD ENCLOSURE-1:100 @ A1