


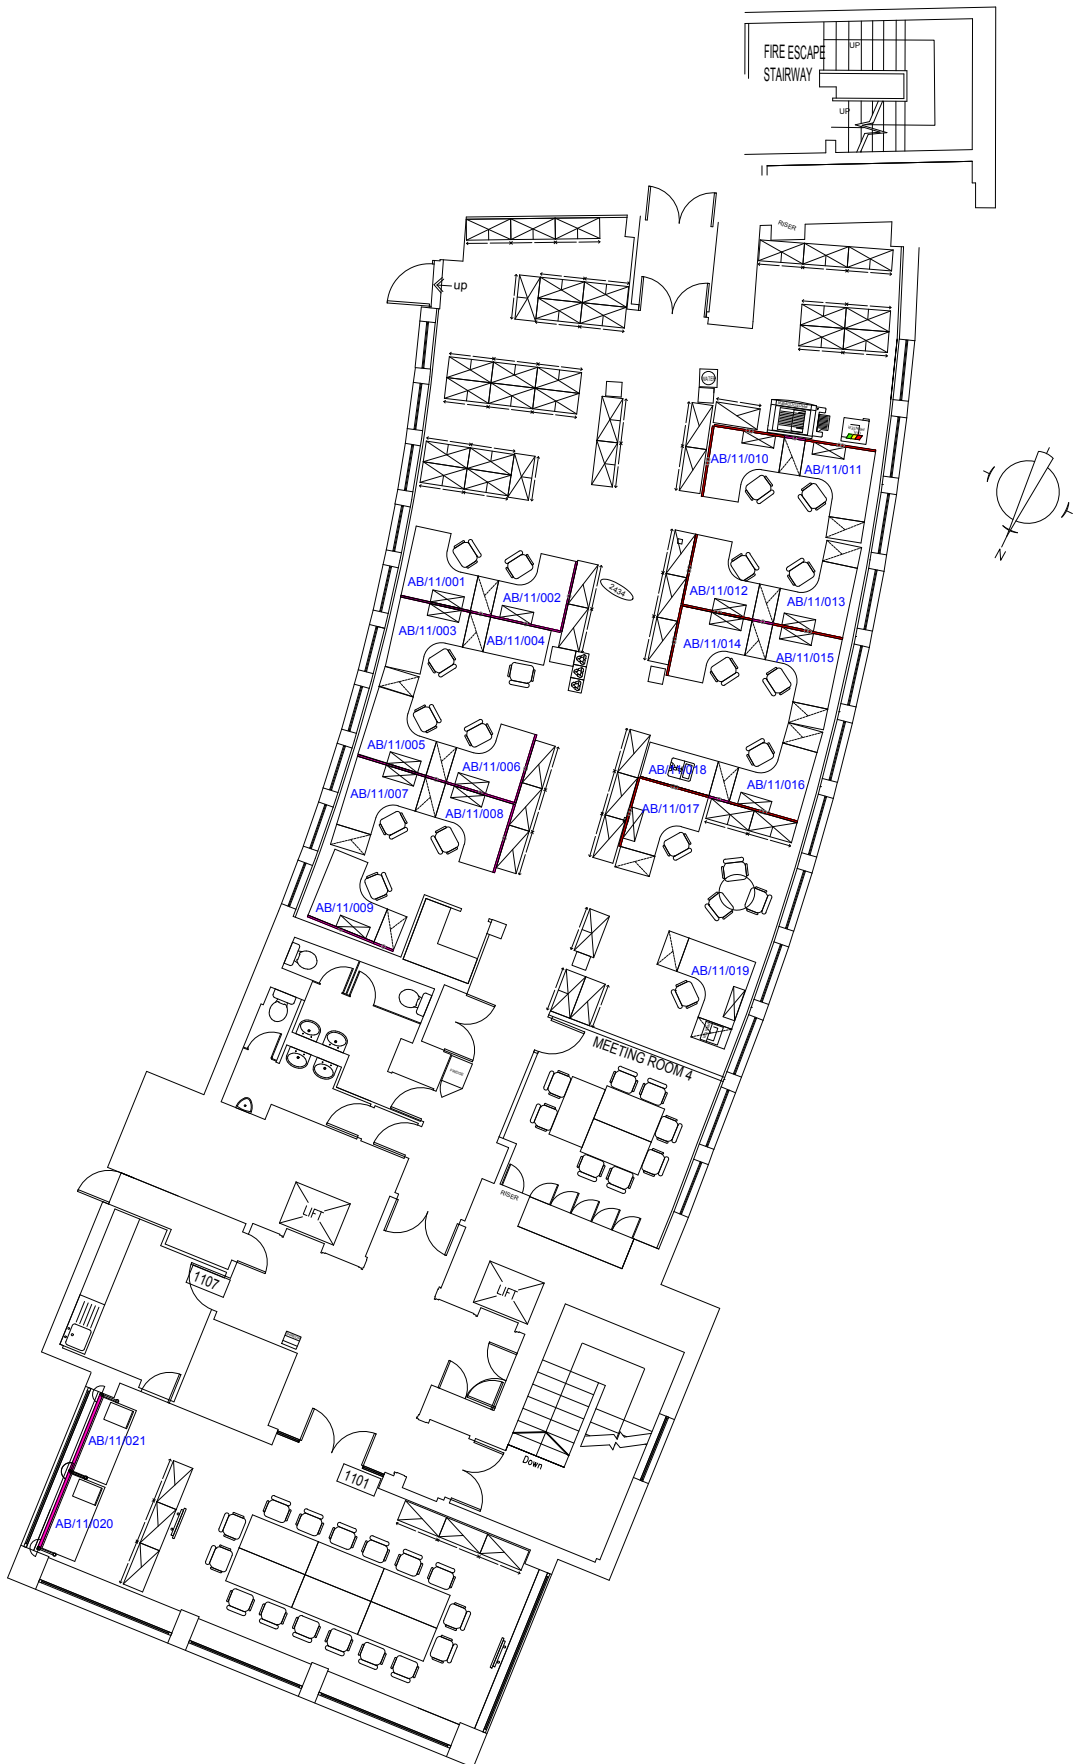

NOTE:
THIS LAYOUT IS PRODUCED ON THE BASIS OF
AN INTERNAL DIMENSION CHECK SURVEY.
ALL DIMENSIONS MUST BE CHECKED AND
VERIFIED ON SITE BY THE MAIN CONTRACTOR
PRIOR TO COMENCEMENT OF ANY WORK OR
SHOP DRAWINGS.

REVISIONS

Rev.	Details.	Date.
Rev A	WR11521 - Meeting Rooms	22.03.17
Rev B	QA SR13442 - Code/Polyline	16.02.18
Rev C	QA SR13538 - Code Updates	22.02.18
Rev D	ACR19223 - Area now VA	27.03.18



Transport for London

COMMERCIAL DEVELOPMENT
PROJECTS & ACCOMMODATION
PALESTRA
197 BLACKFRIARS ROAD LONDON SE1 8NJ

Drawing Title:

ALBANY HOUSE

Layout:

**ELEVENTH FLOOR
AS BUILT LAYOUT**

Survey Date:	Surveyed By:	Date of Occu Survey:
Drawn By: --	Date: --	Scale: NTS
Checked By:		Date:
Approved By:		Date:

Drg. No.

AB_11 TRIRIGA

Rev.

0