
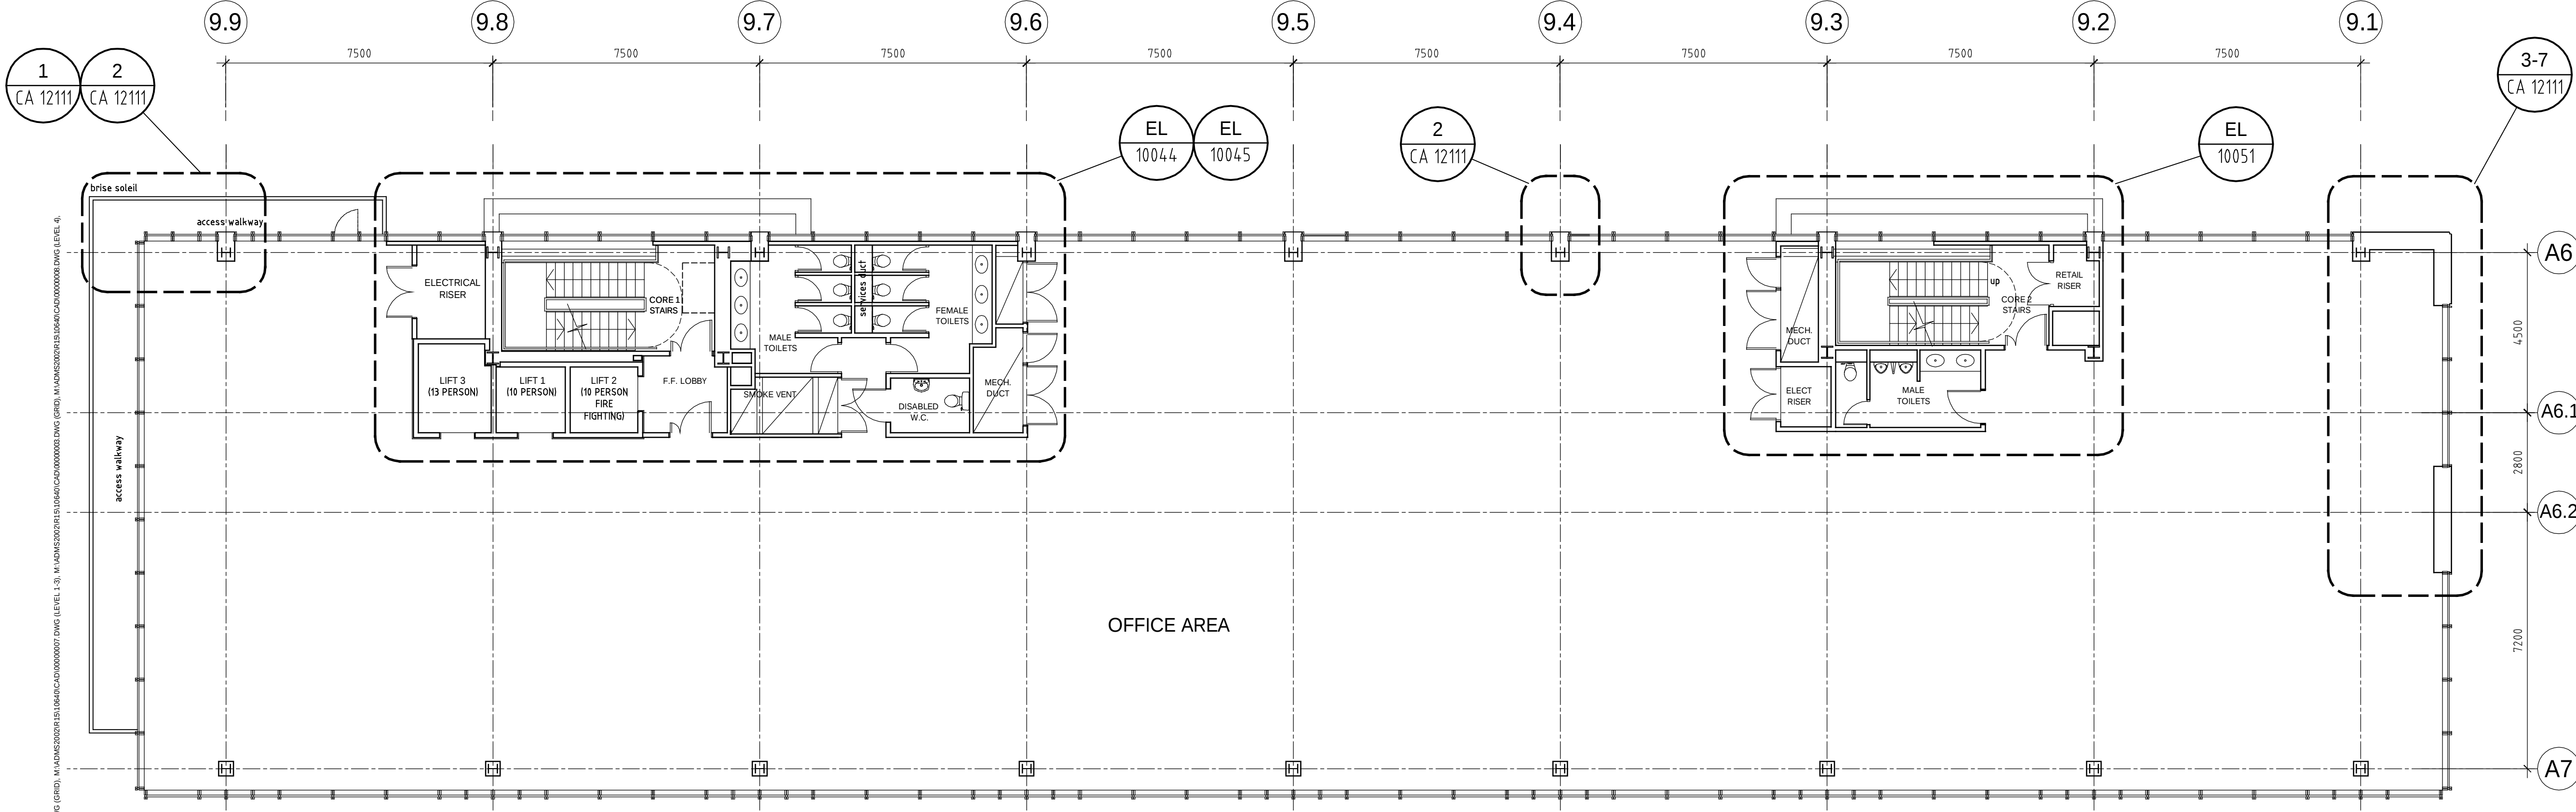


Important note
All dimensions in millimetres. Where dimensions are not given, drawings must not be scaled and the matter referred back to Veretec Limited.
All dimensions and conditions are to be checked on site by the contractor prior to preparing drawings or commencing any work. The contractor is responsible for checking that there is no conflict between site dimensions and drawn dimensions.
In the event of any detail or dimensional conflict between Veretec Limited drawings, the matter must be referred back to Veretec Limited for clarification.

Notes

- A 17/03/2006
CORE LAYOUTS AMENDED. DA
B 25/04/2006
CORE 2 FUTURE LOBBY/SMOKE VENT ADDED. DP
C 05/06/2006
CORE 1 / CORE 2 STAIRS UPDATED. CORE 2 LIFT POSITION AMENDED. CORE 2 SMOKE VENT SIZE INCREASED. DOORS ADDED TO RISER CUPDS AT 9.3. EXTERNAL ENVELOPE UPDATED. HY
D 19/06/2006
CURTAIN WALL / RAINSCREEN DETAIL REFERENCES ADDED AND DRAWING UPDATED. HY
E 31/10/2006
CORE 2 FUTURE LIFT SHAFTS OMITTED. DP
F 01/03/2007
CORE 2 GOODS LIFT ADDED. DP
G 15/03/2007
CORE 2 TOILETS ADDED. KZ
H 28/03/2007
DRAWINGS REFERENCES ADDED. KZ
I 31/05/2007
FLOOR LEVELS REVISED TO LEVELS 2-4 & 5. KZ
J 03/10/2007
RECORD DRAWING ISSUE. AS
Revisions By Authorised

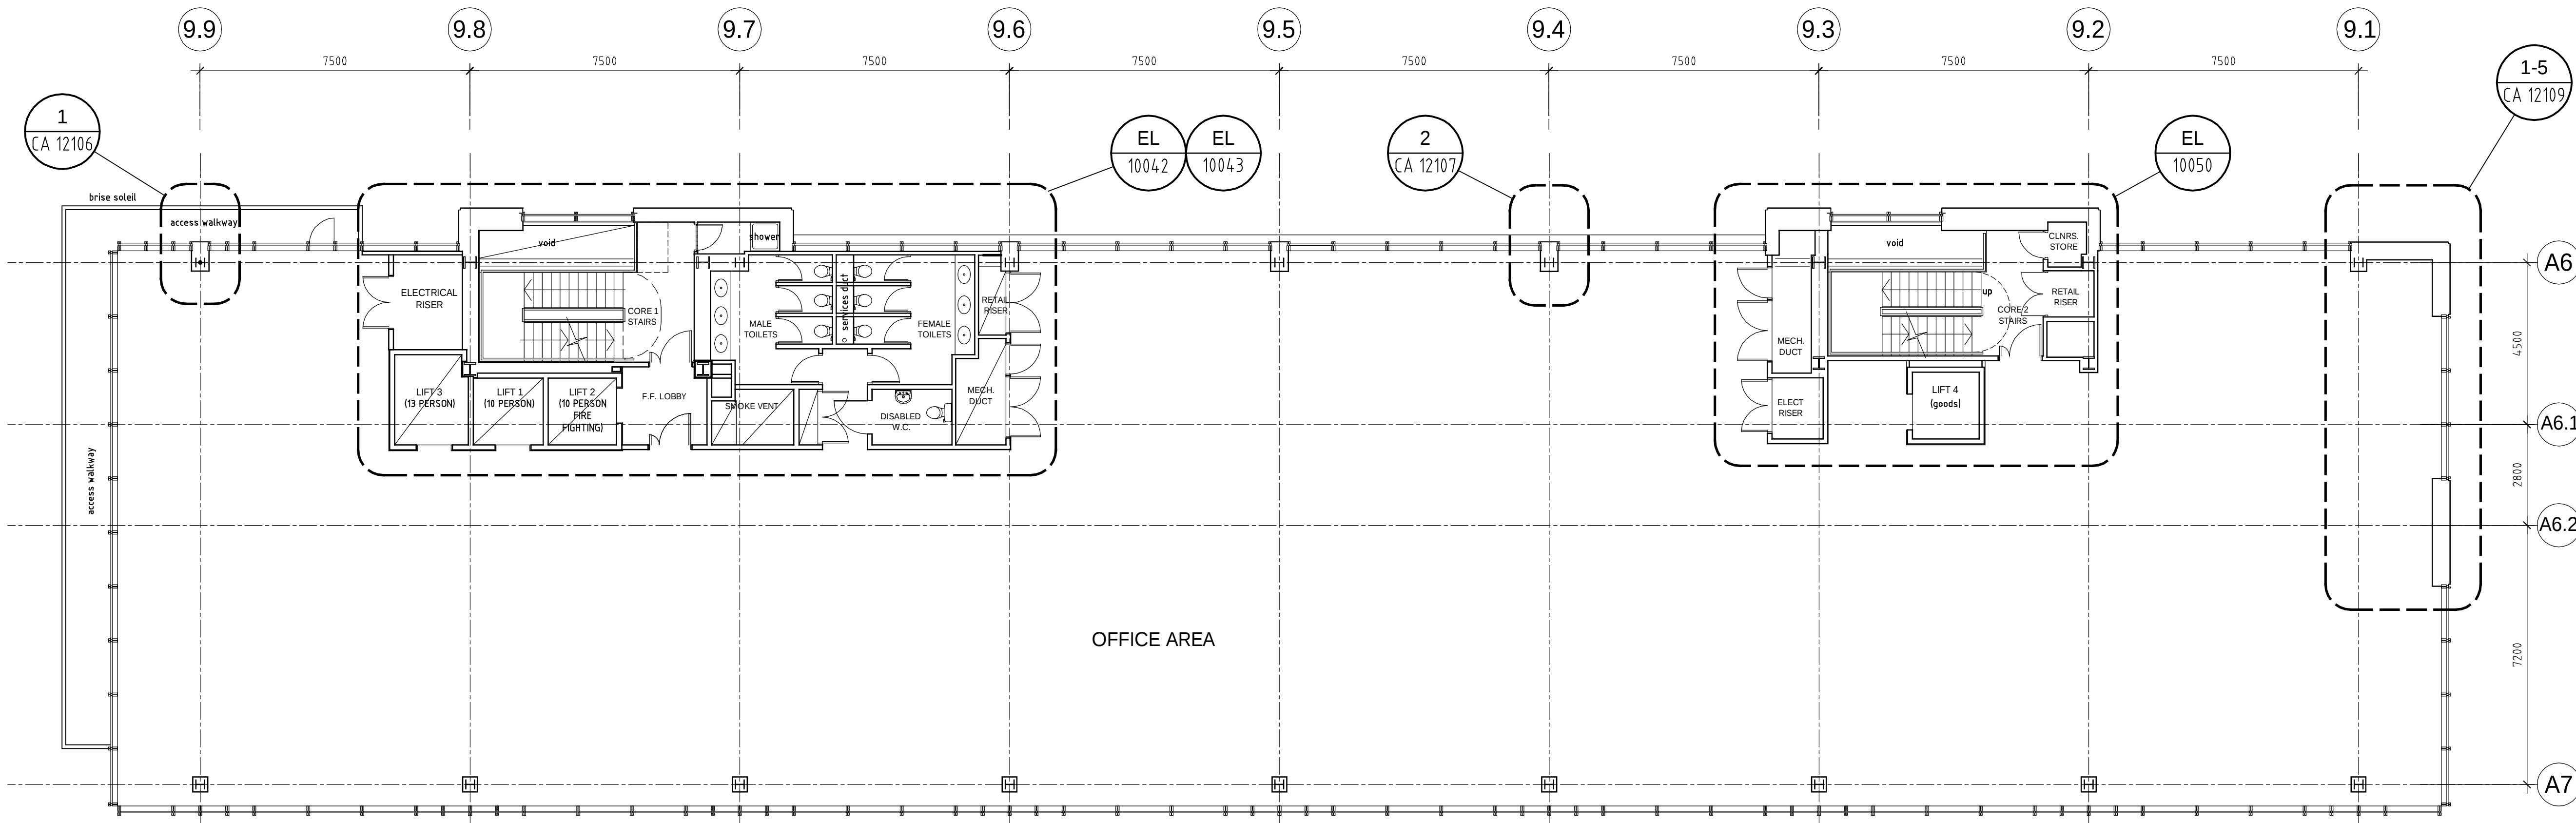

Veretec

Veretec Limited - Chartered Architects
13 14 Devonshire Street
London W1G 7AE
Tel: +44 (0) 20 7636 8033 Fax: +44 (0) 20 7580 3996
Email: london@veretec.co.uk Web: www.veretec.co.uk

Part of the AukettFitzroyRobinson Group

Client
BOWMER & KIRKLAND

Project
**BUILDING 900
MILTON KEYNES**

Title
**LEVELS 2-4 & LEVEL 5
FLOOR PLANS**

Scale	Drawn	Checked	Authorised
1:100 @ A1	CS	DP	BB

Date
07/03/2006

Issue status

RECORD DRAWING

Drawing number	Rev
10640 / RE / 10012	J

© Copyright 2005 - Veretec Limited 10/10/2007 (10:18) BY AGNIESZKA SOPATA