


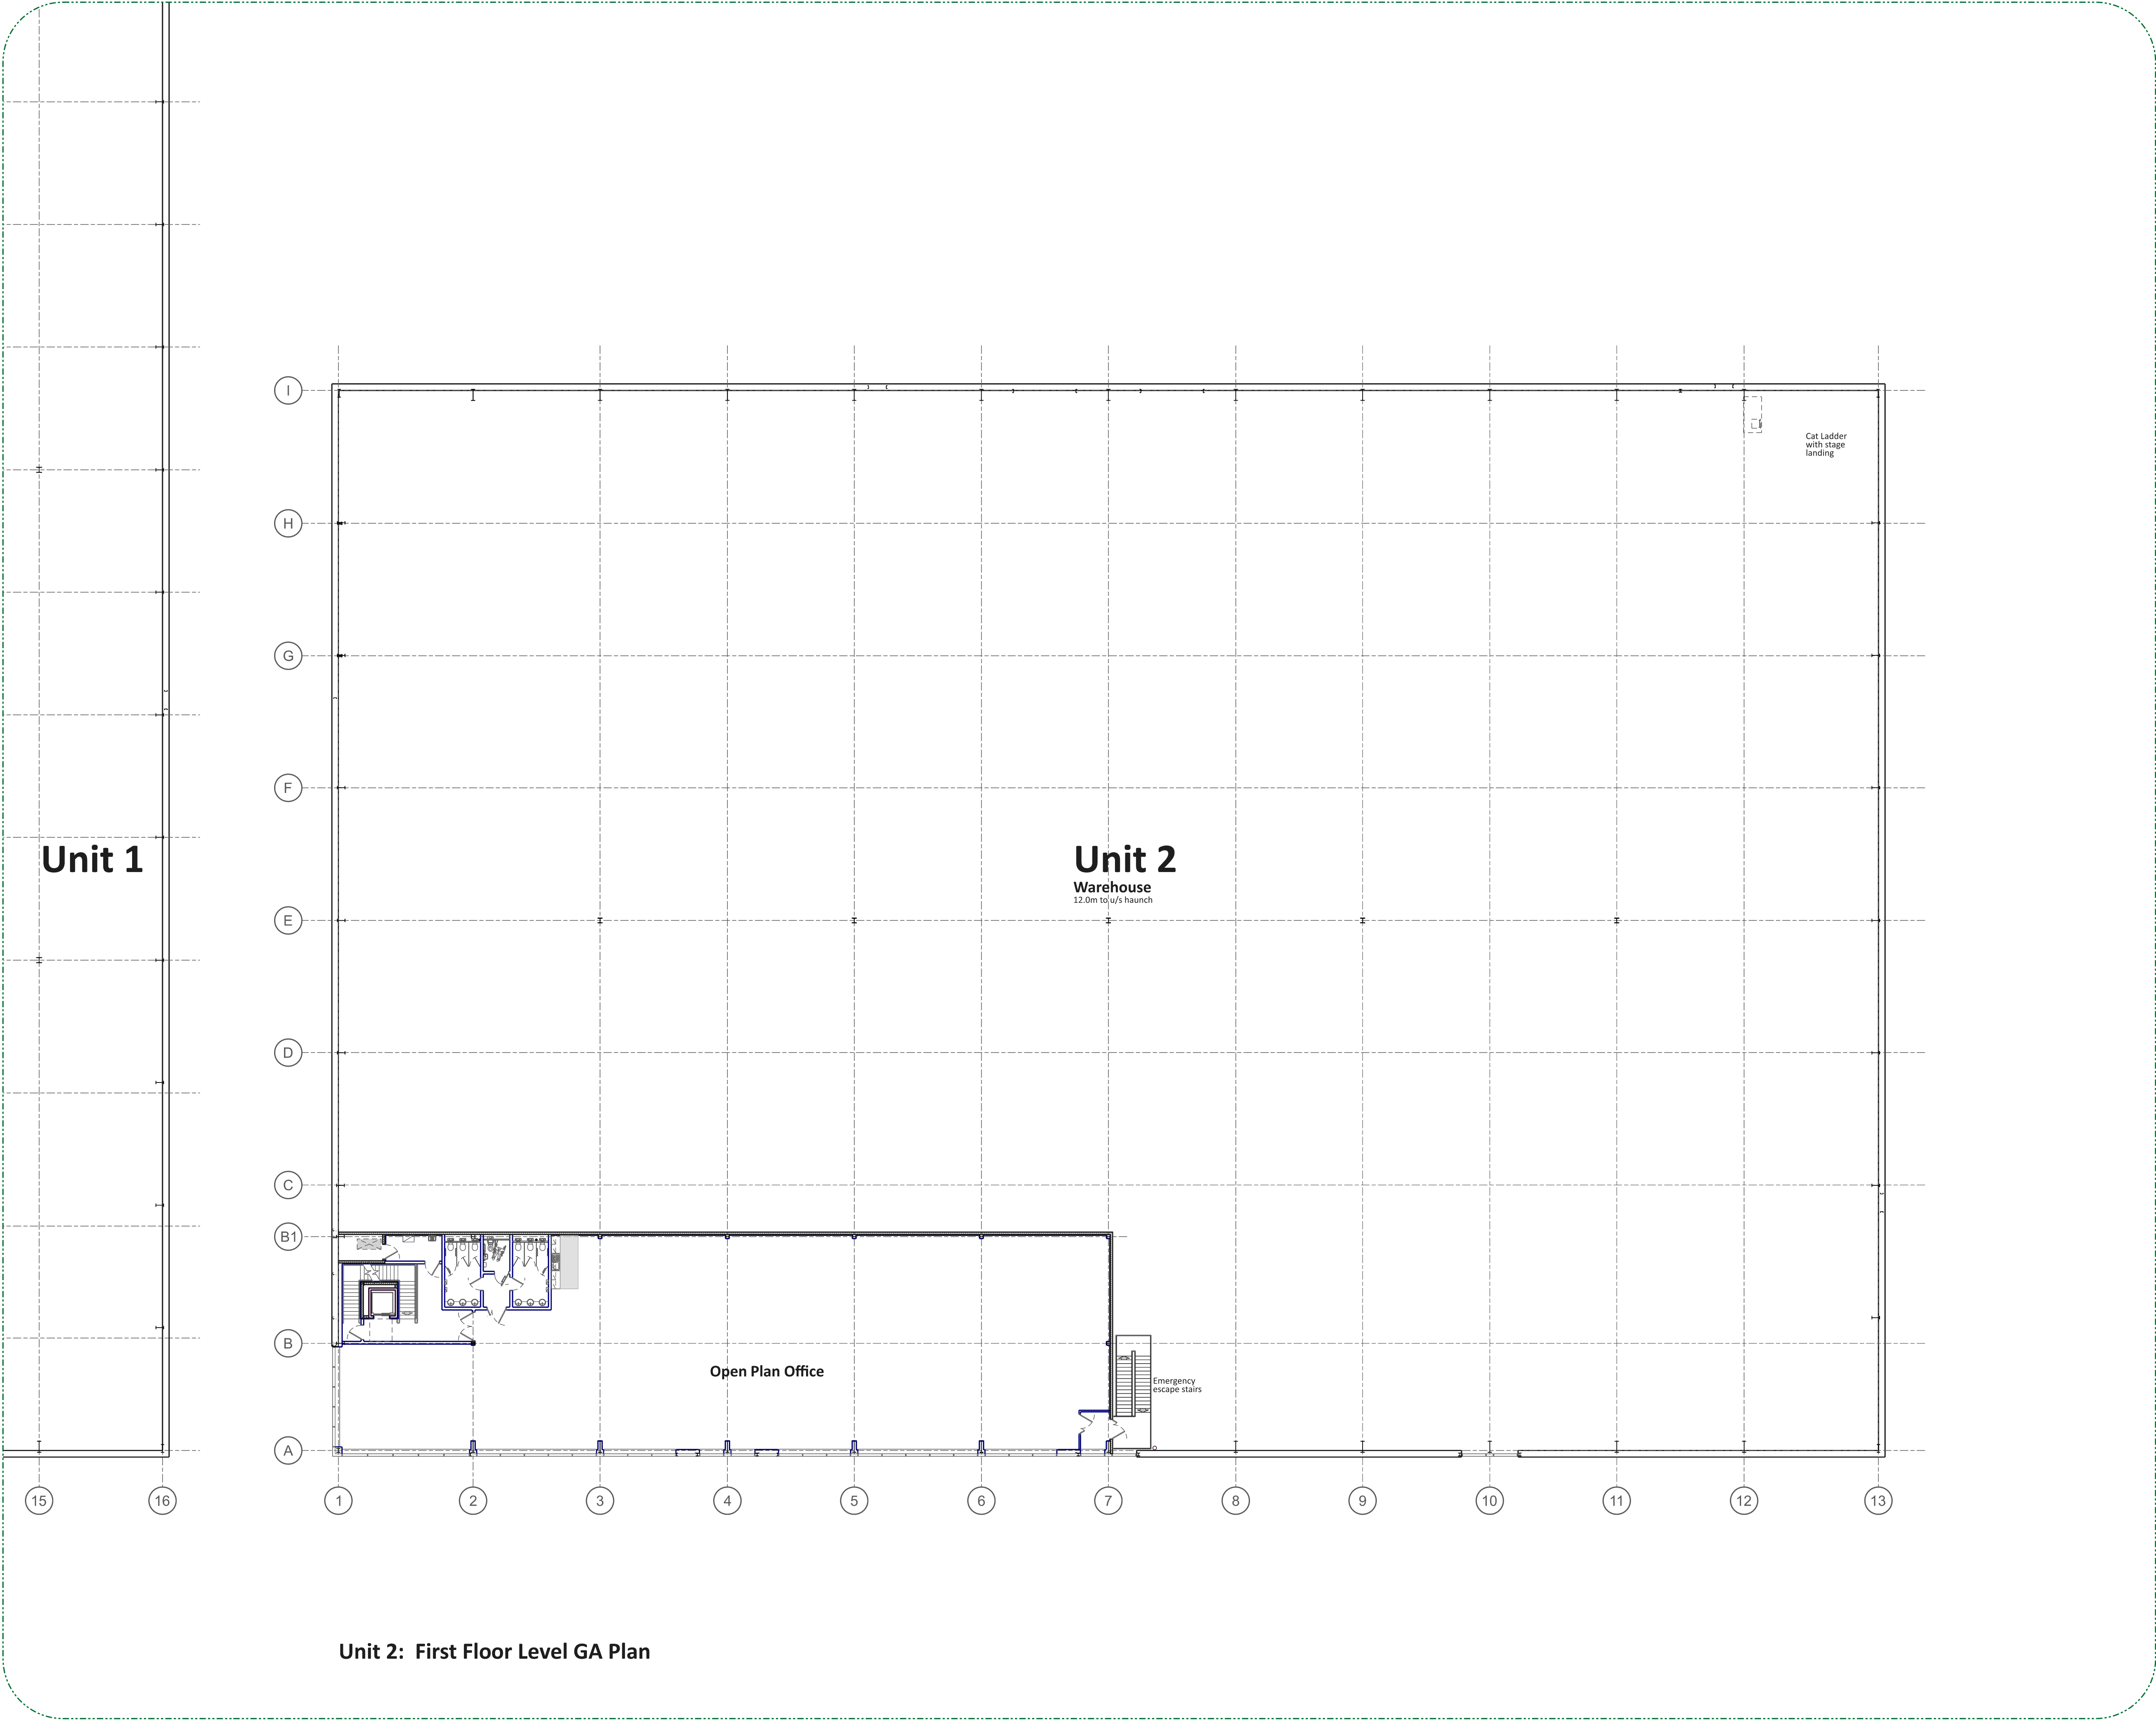

Scale Bar - metres:
0 2 4 6 8 16

Note: This drawing incorporates the information last issued for construction under the building contract. This drawing has not been verified by dimensional survey and allowable construction tolerances may have resulted in differences between this drawing and the finished building.

Rev AB1: FINAL AMENDMENT ISSUE

LAS - 22.08.2021

Drawing Status:
AS BUILT

CMP Architects

Client

Project
Project Bolt, Fleming Way, Crawley

Title
Unit 02.
First Floor Level GA Plan

Scale
1:200@A1

Drawn
HM

Date
22.08.2022

Org. No.
C227/ 6202

Revision
AB1

This drawing is copyright. Do not scale from drawing.
Subject to accurate site survey.