



This drawing is protected under Copyright and at no time must any portion of this drawing be reproduced or copied in any way without the permission of Morgan Lovell.

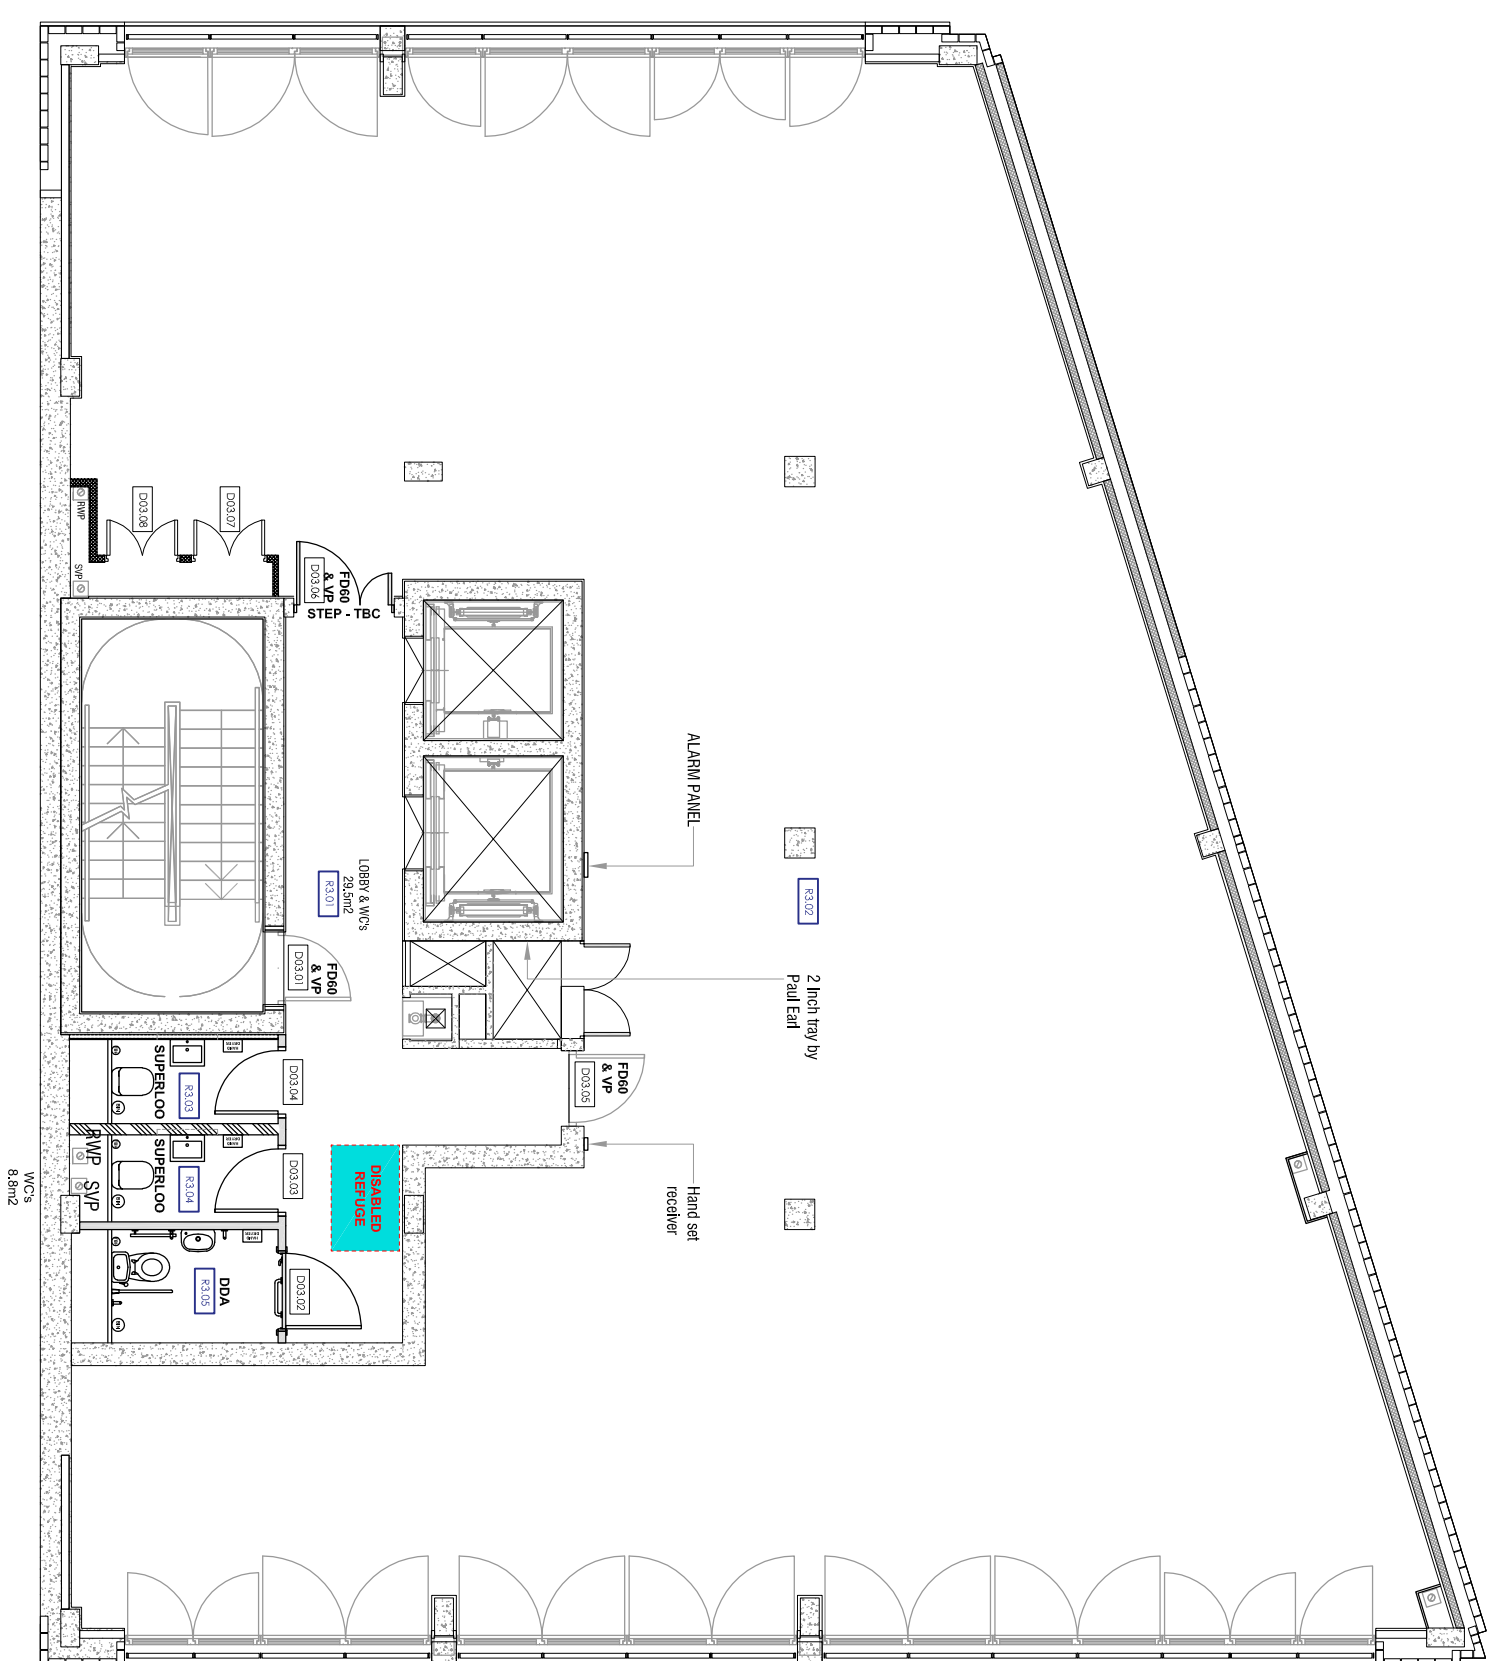

THIRD FLOOR
NIA = 246.66m²

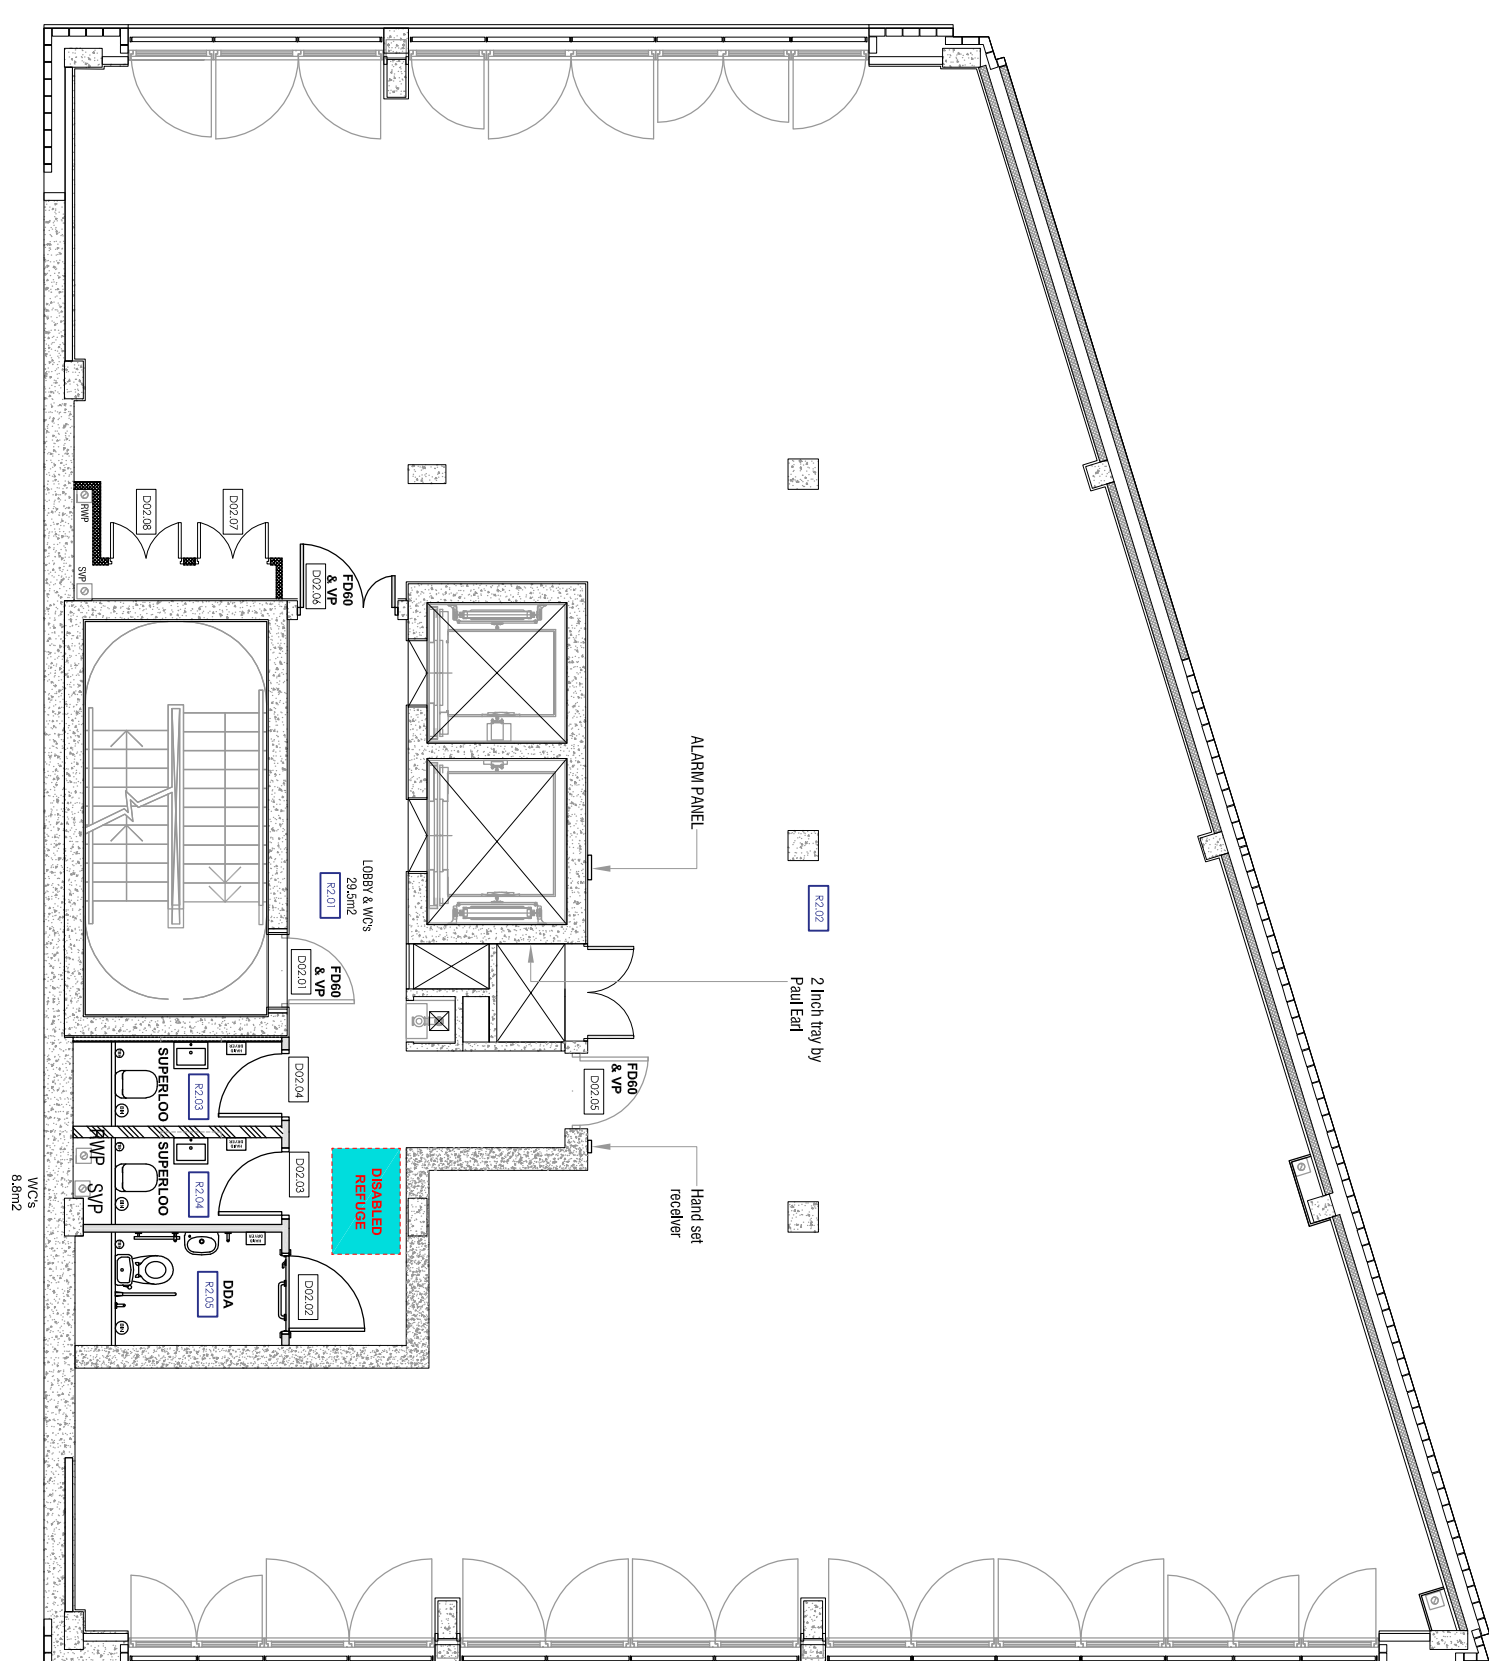

SECOND FLOOR
NIA = 246.66m2

[illegible]

AS BUILT

Morgan Lovell

16 Noel Street London W1F 8DA
T: 0207 734 4466 F: 0207 734 2968 E: contact@morganlove.com
W: <http://www.morganlove.com>

London Square

Project
Cally Yard
Building 7
Caledonian Road
London N7 9BQ

Second & Third Floors

General Arrangement

Scale	Date	Designer/Drawn By	Checked By / Date
1:100 @ A1	June 19	ML	NB

Project No.	Floor	Drawing No.	Rev
ML3257	02-03	B7-100	AB