


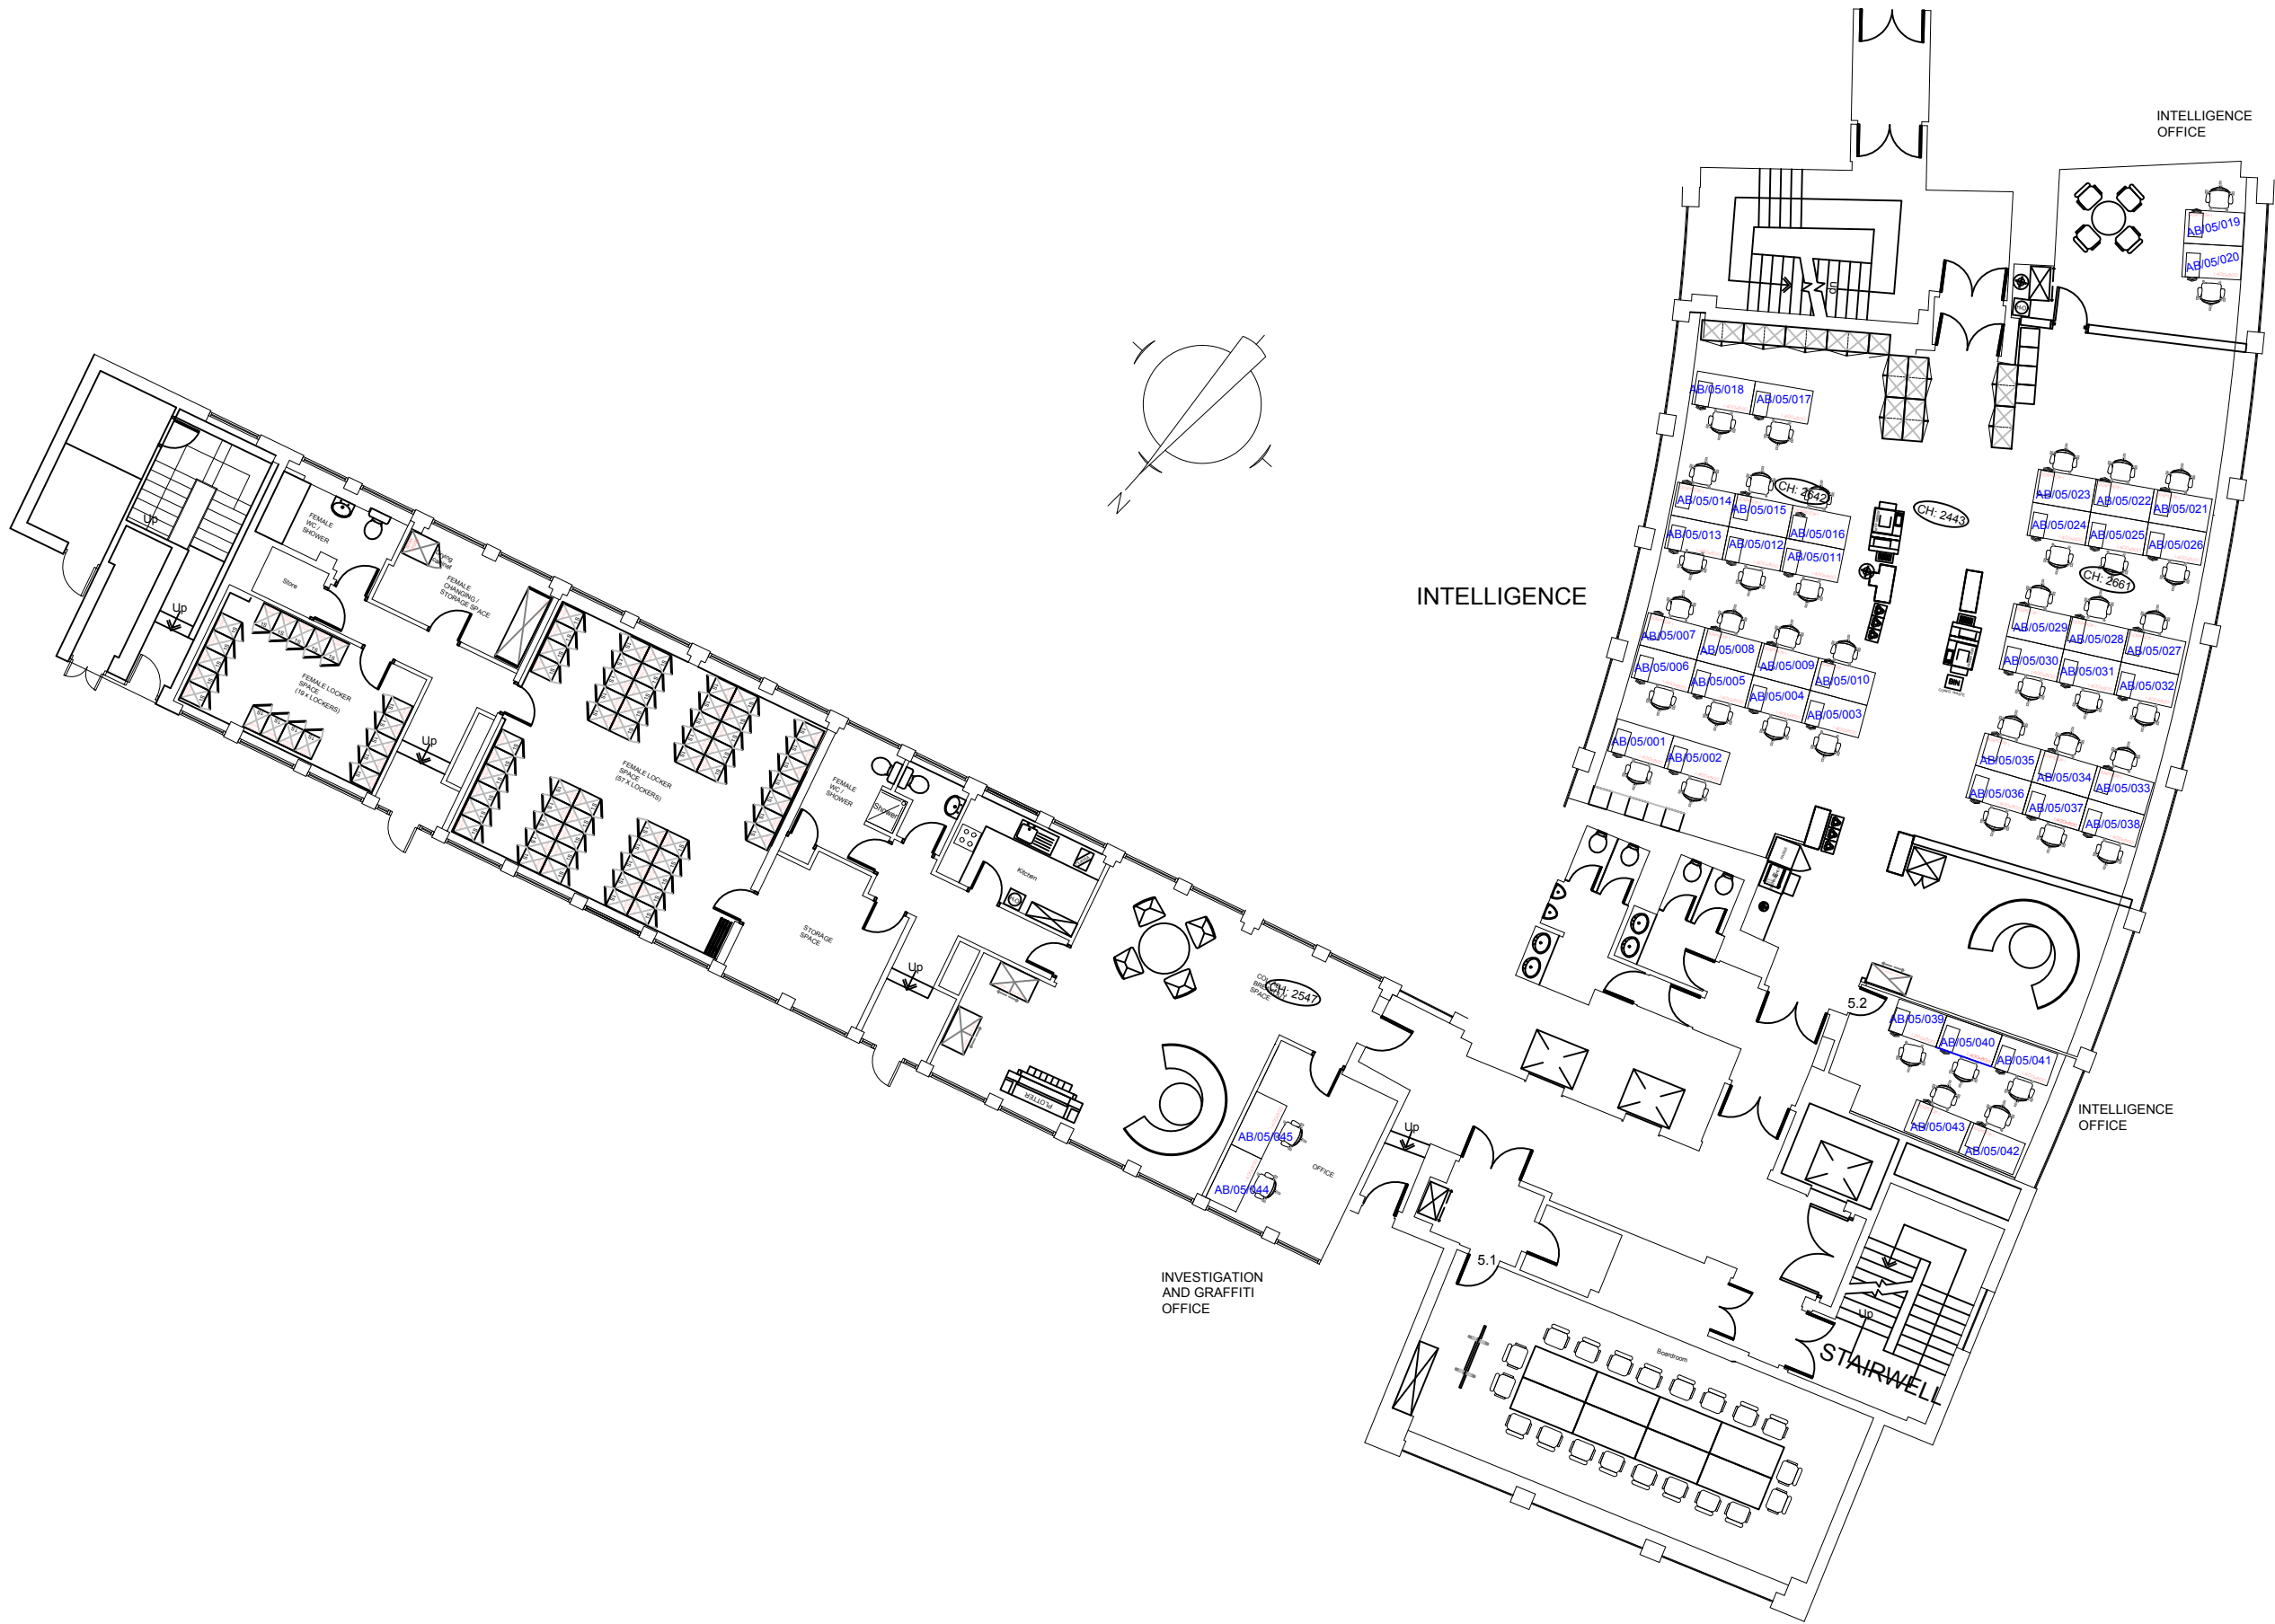

NOTE:
THIS LAYOUT IS PRODUCED ON THE BASIS OF
AN INTERNAL DIMENSION CHECK SURVEY.
ALL DIMENSIONS MUST BE CHECKED AND
VERIFIED ON SITE BY THE MAIN CONTRACTOR
PRIOR TO COMENCEMENT OF ANY WORK OR
SHOP DRAWINGS.

REVISIONS

Rev.	Details.	Date.
Rev A	WR11521 - Meeting Rooms	22.03.17
Rev B	QA - SR12257	05.09.17
Rev C	QA - SR13419	15.02.18
Rev D	QA - SR13542	22.02.18
ACR	ACR22507 - CC change	2019Apr30
	ACR30648	2022Feb21


Transport for London
COMMERCIAL DEVELOPMENT
PROJECTS & ACCOMMODATION
PALESTRA
197 BLACKFRIARS ROAD LONDON SE1 8NJ

Drawing Title:
ALBANY HOUSE
Layout:
**FIFTH FLOOR
AS BUILT LAYOUT**

Survey Date:	Surveyed By:	Date of Occu Survey:
Drawn By: --	Date: --	Scale: NTS
Checked By:		Date:
Approved By:		Date:

Drg. No. AB_05 TRIRIGA	Rev. 0
----------------------------------	------------------