


REVISION	DATE	DESCRIPTION
A	15.07.27	BUILDING REGS ON PLAN
B	15.09.17	GREETER STATION

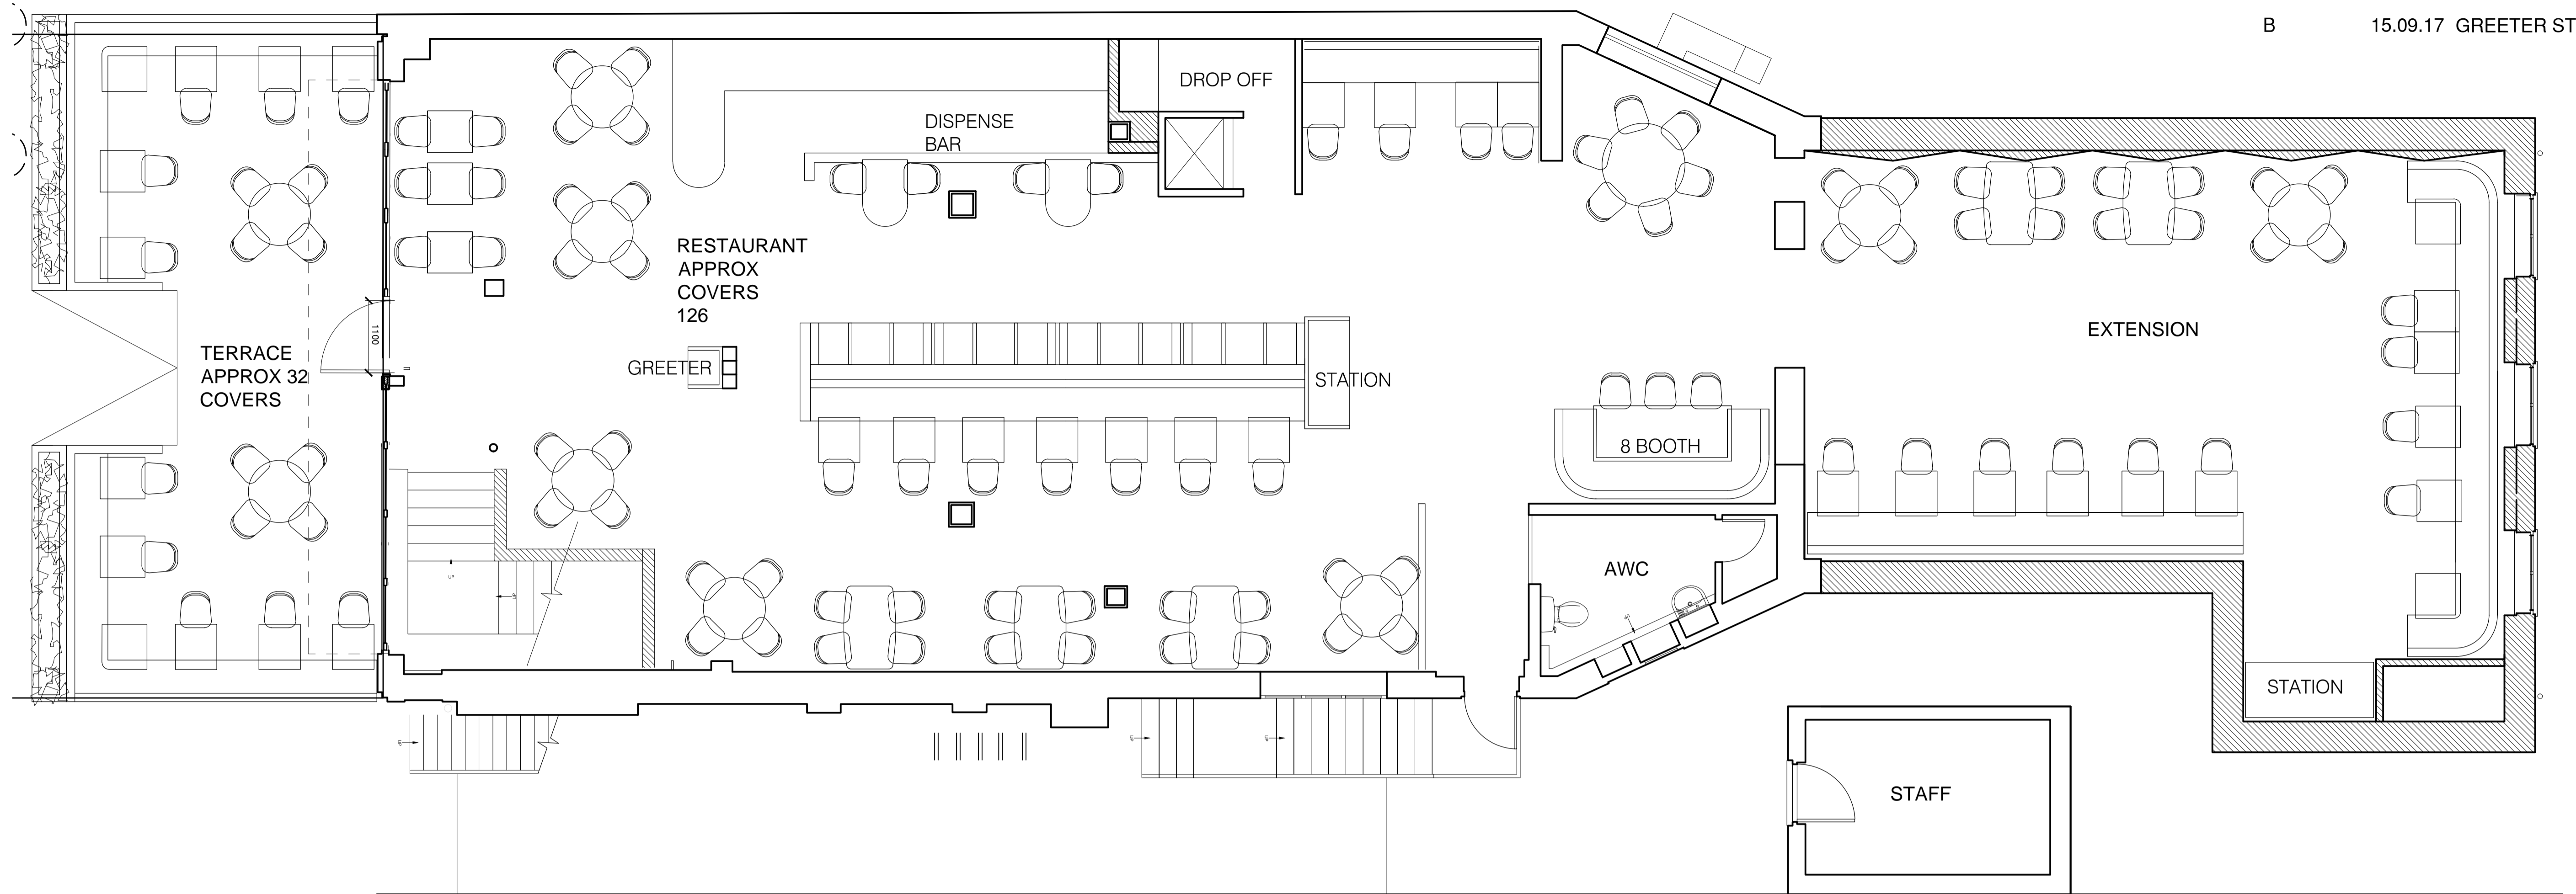

A GROUND FLOOR PLAN
SCALE 1:50@A1

CANTOR CM MASTERS

INTERIOR DESIGN

No1 The Colour House
7 Bell Yard Mews
London SE1 3UA
Tel: +44(0)20 7407 5434
e: info@cantormasters.com
www.cantormasters.com

CLIENT
COTE RESTAURANT


PROJECT
**HAYWARDS HEATH
59-61 THE BROADWAY
RH16 3AS**

TITLE
**GROUND FLOOR
GENERAL ARRANGEMENT PLAN**

JOB No	SCALE	DATE
9015	AS SHOWN	16.06.15
DRAWING No	REVISION	
GA.G.00	B	A1 SHEET


AS BUILT

SCALE @ 1:50

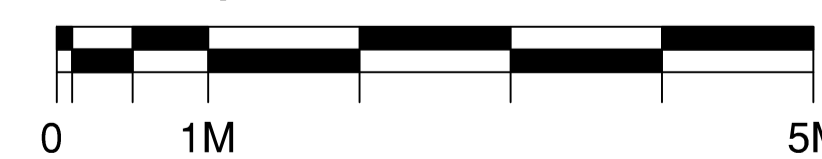

© Copyright is reserved by CantorMasters Ltd.
This drawing is the property of CantorMasters Ltd and is issued on condition that it is not copied in any manner or issued to third parties without the written consent from CantorMasters Ltd. CantorMasters Ltd does not warrant the accuracy of the measurements or other information contained on the drawing and all parties using this drawing and the information contained within must check and verify and satisfy themselves as to the accuracy or otherwise of such measurements or other information.
Do not scale from this drawing. All figured measurements are indicated as a general guide only. All discrepancies or omissions must be reported to CantorMasters Ltd for their comments or approval prior to commencing work.
This drawing to be read in conjunction with all other consultants information and any anomalies reported to CantorMasters Ltd prior to commencement on site.
This drawing is subject to approval by statutory authorities and as such is subject to revision as required.

REVISION	DATE	DESCRIPTION
A	15.07.27	BUILDING REGS ON PLAN
B	15.10.09	GA PLAN UPDATED

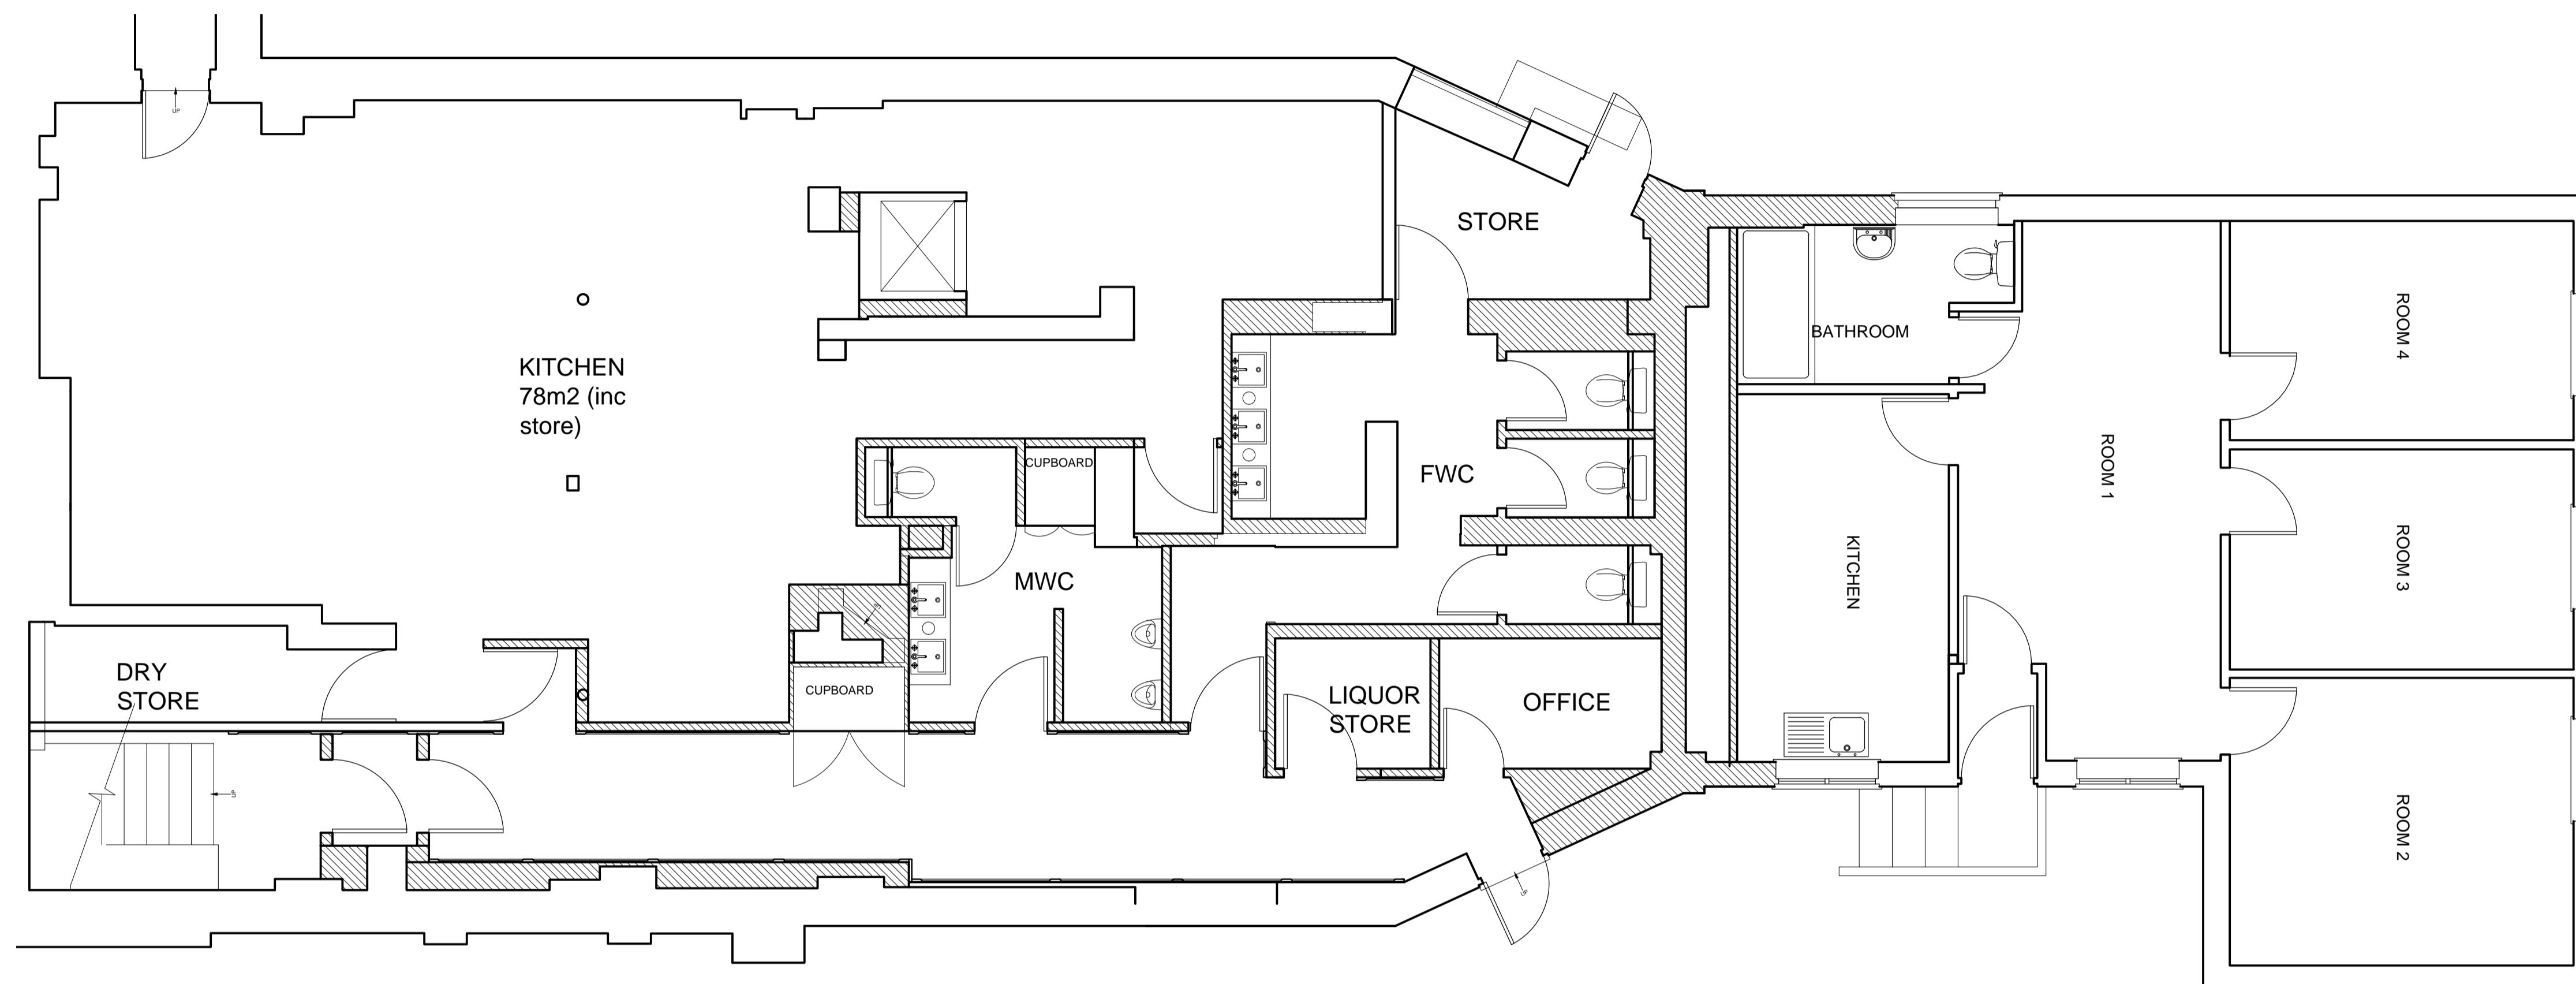

G BASEMENT FLOOR PLAN
SCALE 1:50@A1

CANTOR CM MASTERS

INTERIOR DESIGN

No1 The Colour House
7 Bell Yard Mews
London SE1 3UA
Tel: +44(0)20 7407 5434
e: info@cantormasters.com
www.cantormasters.com

CLIENT
COTE RESTAURANT


PROJECT
**HAYWARDS HEATH
59-61 THE BROADWAY
RH16 3AS**

TITLE
**BASEMENT FLOOR
GENERAL ARRANGEMENT PLAN**

JOB No	SCALE	DATE
9015	AS SHOWN	16.06.15
DRAWING No	REVISION	
GA.B.00	B	A1 SHEET

AS BUILT

SCALE @ 1:50

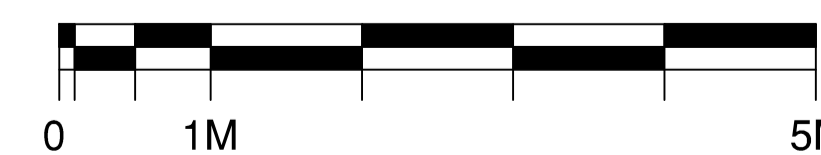

© Copyright is reserved by CantorMasters Ltd.
This drawing is the property of CantorMasters Ltd and is issued on condition that it is not copied in any manner or issued to third parties without the written consent from CantorMasters Ltd. CantorMasters Ltd does not warrant the accuracy of the measurements or other information contained on the drawing and all parties using this drawing and the information contained within must check and verify and satisfy themselves as to the accuracy or otherwise of such measurements or other information.
Do not scale from this drawing. All figured measurements are indicated as a general guide only. All discrepancies or omissions must be reported to CantorMasters Ltd for their comments or approval prior to commencing work.
This drawing to be read in conjunction with all other consultants information and any anomalies reported to CantorMasters Ltd prior to commencement on site.
This drawing is subject to approval by statutory authorities and as such is subject to revision as required.