


GA LEGEND

	NEW WORKSTATION 1200 x 800
	NEW DOOR
	EXISTING DOOR
	OUT OF SCOPE
XXXX •	ROOM/AREA NAME
XXXX •	ROOM/AREA SIZE
	NEW PARTITION
	EXISTING PARTITION / WALL
J10	JOINERY TAG

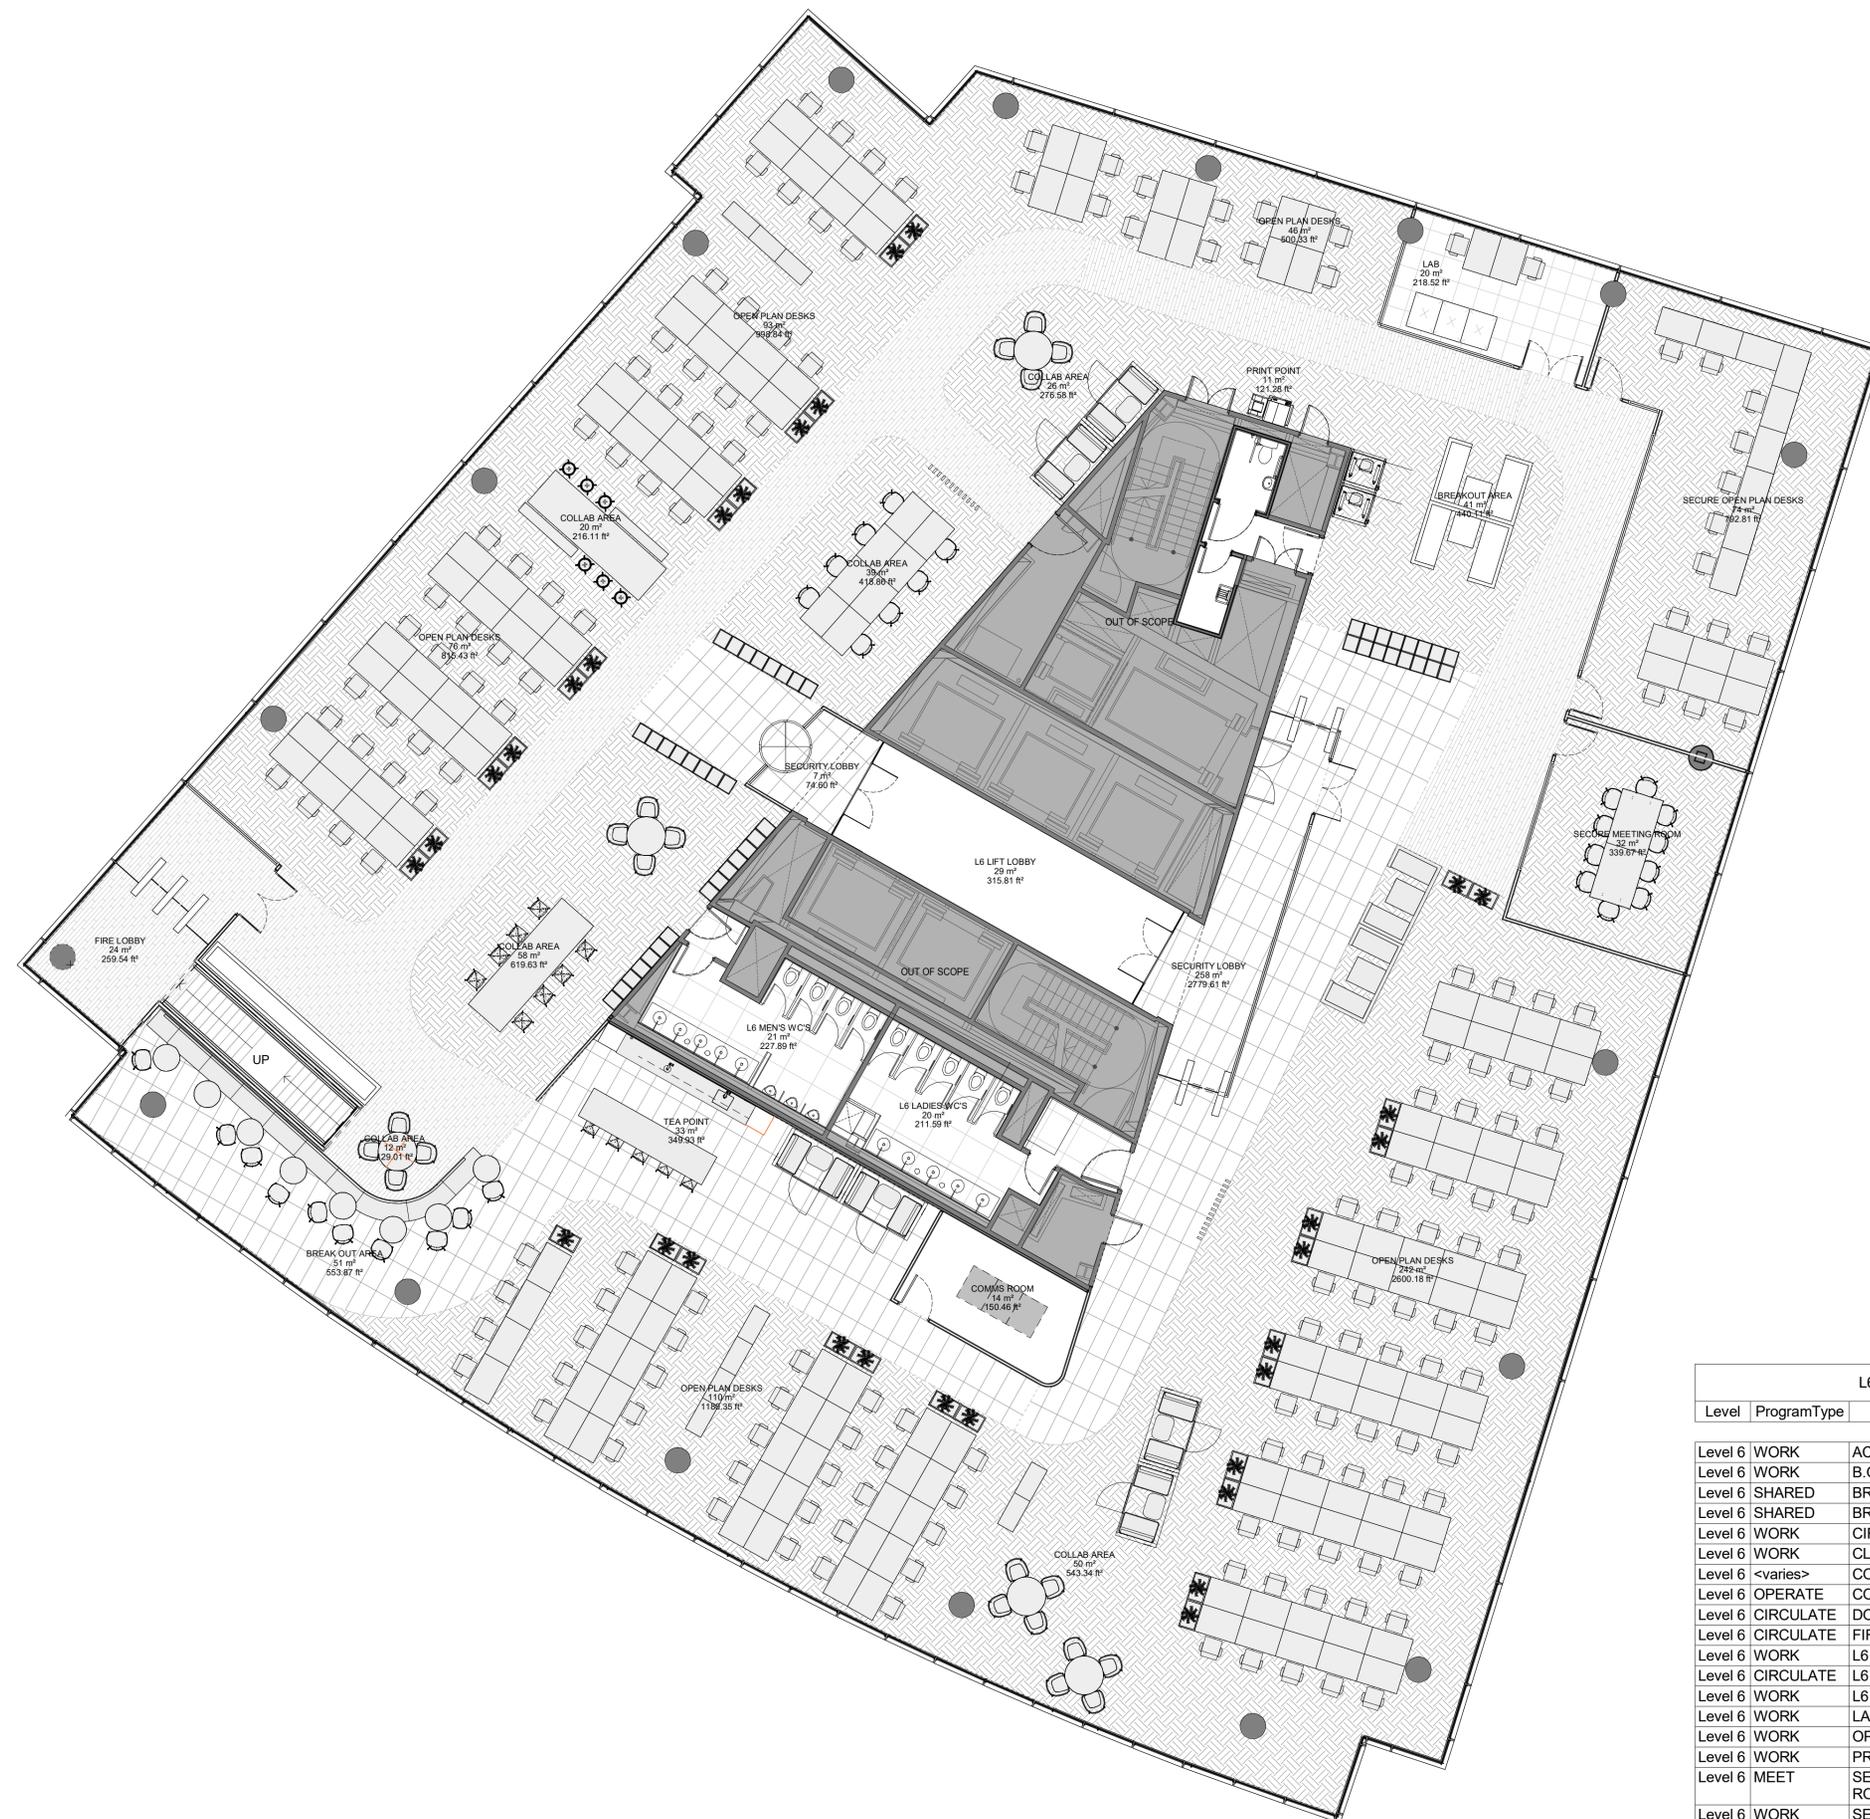

L6 Accomodation Schedule					
Level	ProgramType	Name	No.	Desks	Area
Level 6	WORK	ACCESSIBLE WC	1	0	3 m²
Level 6	WORK	B.O.H. CORRIDOR	1	0	4 m²
Level 6	SHARED	BREAK OUT AREA	1	0	51 m²
Level 6	SHARED	BREAKOUT AREA	1	0	41 m²
Level 6	WORK	CIRCULATION	1	0	0 m²
Level 6	WORK	CLEANERS CUPBOARD	1	0	3 m²
Level 6	<varies>	COLLAB AREA	6	0	205 m²
Level 6	OPERATE	COMMS ROOM	1	0	14 m²
Level 6	CIRCULATE	DOUBLE VOLUME	1	0	9 m²
Level 6	CIRCULATE	FIRE LOBBY	1	0	24 m²
Level 6	WORK	L6 LADIES W'C'S	1	0	20 m²
Level 6	CIRCULATE	L6 LIFT LOBBY	1	0	29 m²
Level 6	WORK	L6 MEN'S W'C'S	1	0	21 m²
Level 6	WORK	LAB	1	0	20 m²
Level 6	WORK	OPEN PLAN DESKS	5	150	566 m²
Level 6	WORK	PRINT POINT	1	0	11 m²
Level 6	MEET	SECURE MEETING ROOM	1	0	32 m²
Level 6	WORK	SECURE OPEN PLAN DESKS	1	13	74 m²
Level 6	OPERATE	SECURITY LOBBY	2	0	265 m²
Level 6	SHARED	TEA POINT	1	0	33 m²
Grand total				163	1424 m²

REVISION	DATE	DESCRIPTION
A1	29/04/2024	AS BUILT FIRST ISSUE
A2	29/04/2024	AS BUILT FINAL ISSUE

CLIENT  
**VORBOSS**

PROJECT  
**VORBOSS HQ**  
10, Exchange Square, Broadgate, London EC2A 2BR

QBRE PROJECT NUMBER  
**Q23244**

SCALE @ A1	DESIGNED BY <b>CF</b>	DRAWN BY <b>MP</b>
------------	--------------------------	-----------------------

STATUS  
**AS-BUILT DRAWINGS**

DRAWING  
**LEVEL 06 GA PLAN**

DRAWING NUMBER <b>Q23244-06-102</b>	ISSUE <b>A2</b>
--	--------------------