
A 3

Amendments

Revision | Comment | Date

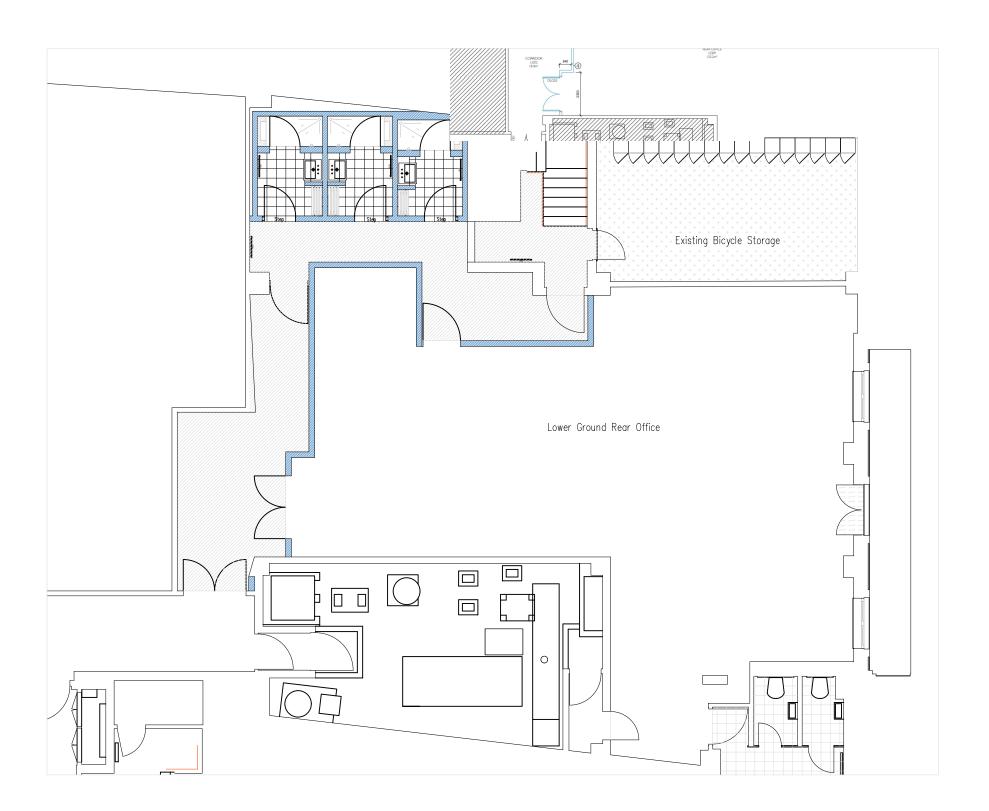

AS BUILT

M Risk Assessment Details

CDM File No. | Assessed by | Date

Figured dimensions are to be followed in preference to dimension scaled from drawing. All dimensions to be checked on site by Contractor, and such dimensions to be his responsibility. Drawing errors and omissions to be reported to Contract Administrator.

MDDUS PROPERTY LIMITED

oh title

Lower Ground Floor, Pemberton Row London EC4A

Drawing title

Lower Ground Floor Proposed Layout

End of Journey Facilities

Daniel Watney

BUILDING CONSULTANCY
165 FLEET STREET
LONDON EC4A 2DW
www.danielwatney.co.uk

© 020 3077 3400 Fax: 020 3077 3477

Job No: Dwg No: B37734 P101