

Notes:


This document is the property of ranne Ltd. Copyright is reserved by them and the drawing is issued on condition that it is not copied, reproduced or retained by, nor disclosed to any unauthorised person, either wholly or in part without the written consent of ranne Ltd.

DO NOT SCALE FROM THIS DRAWING
Drawings are for general arrangement only. Dimensions are to be checked on site by the contractor and any discrepancies are to be reported in writing prior to commencement of work. When a drawing is covered by different scales the larger scale is to be worked to. In all cases, Drawings are completed under client instruction and therefore submitted on the condition that the responsibility of compliance to all relevant authority and legal requirements, and of obtaining required approval, remains with the client.

1. Do not scale drawings
2. Site verify all dimensions prior to construction.
3. Report all discrepancies to ranne Ltd immediately.
4. This drawing is to be read in conjunction with all relevant documents and drawings.
5. Not for construction or for ordering.
6. No works to be carried out based on the information portrayed on this drawing.
7. Please refer to the construction drawing issued for this scheme.

Building Regulation Notes:

Revisions			
Rev	Description	Date	Zone
AB	2-4 Southwark Street - 4th floor GA	28/11/17	All

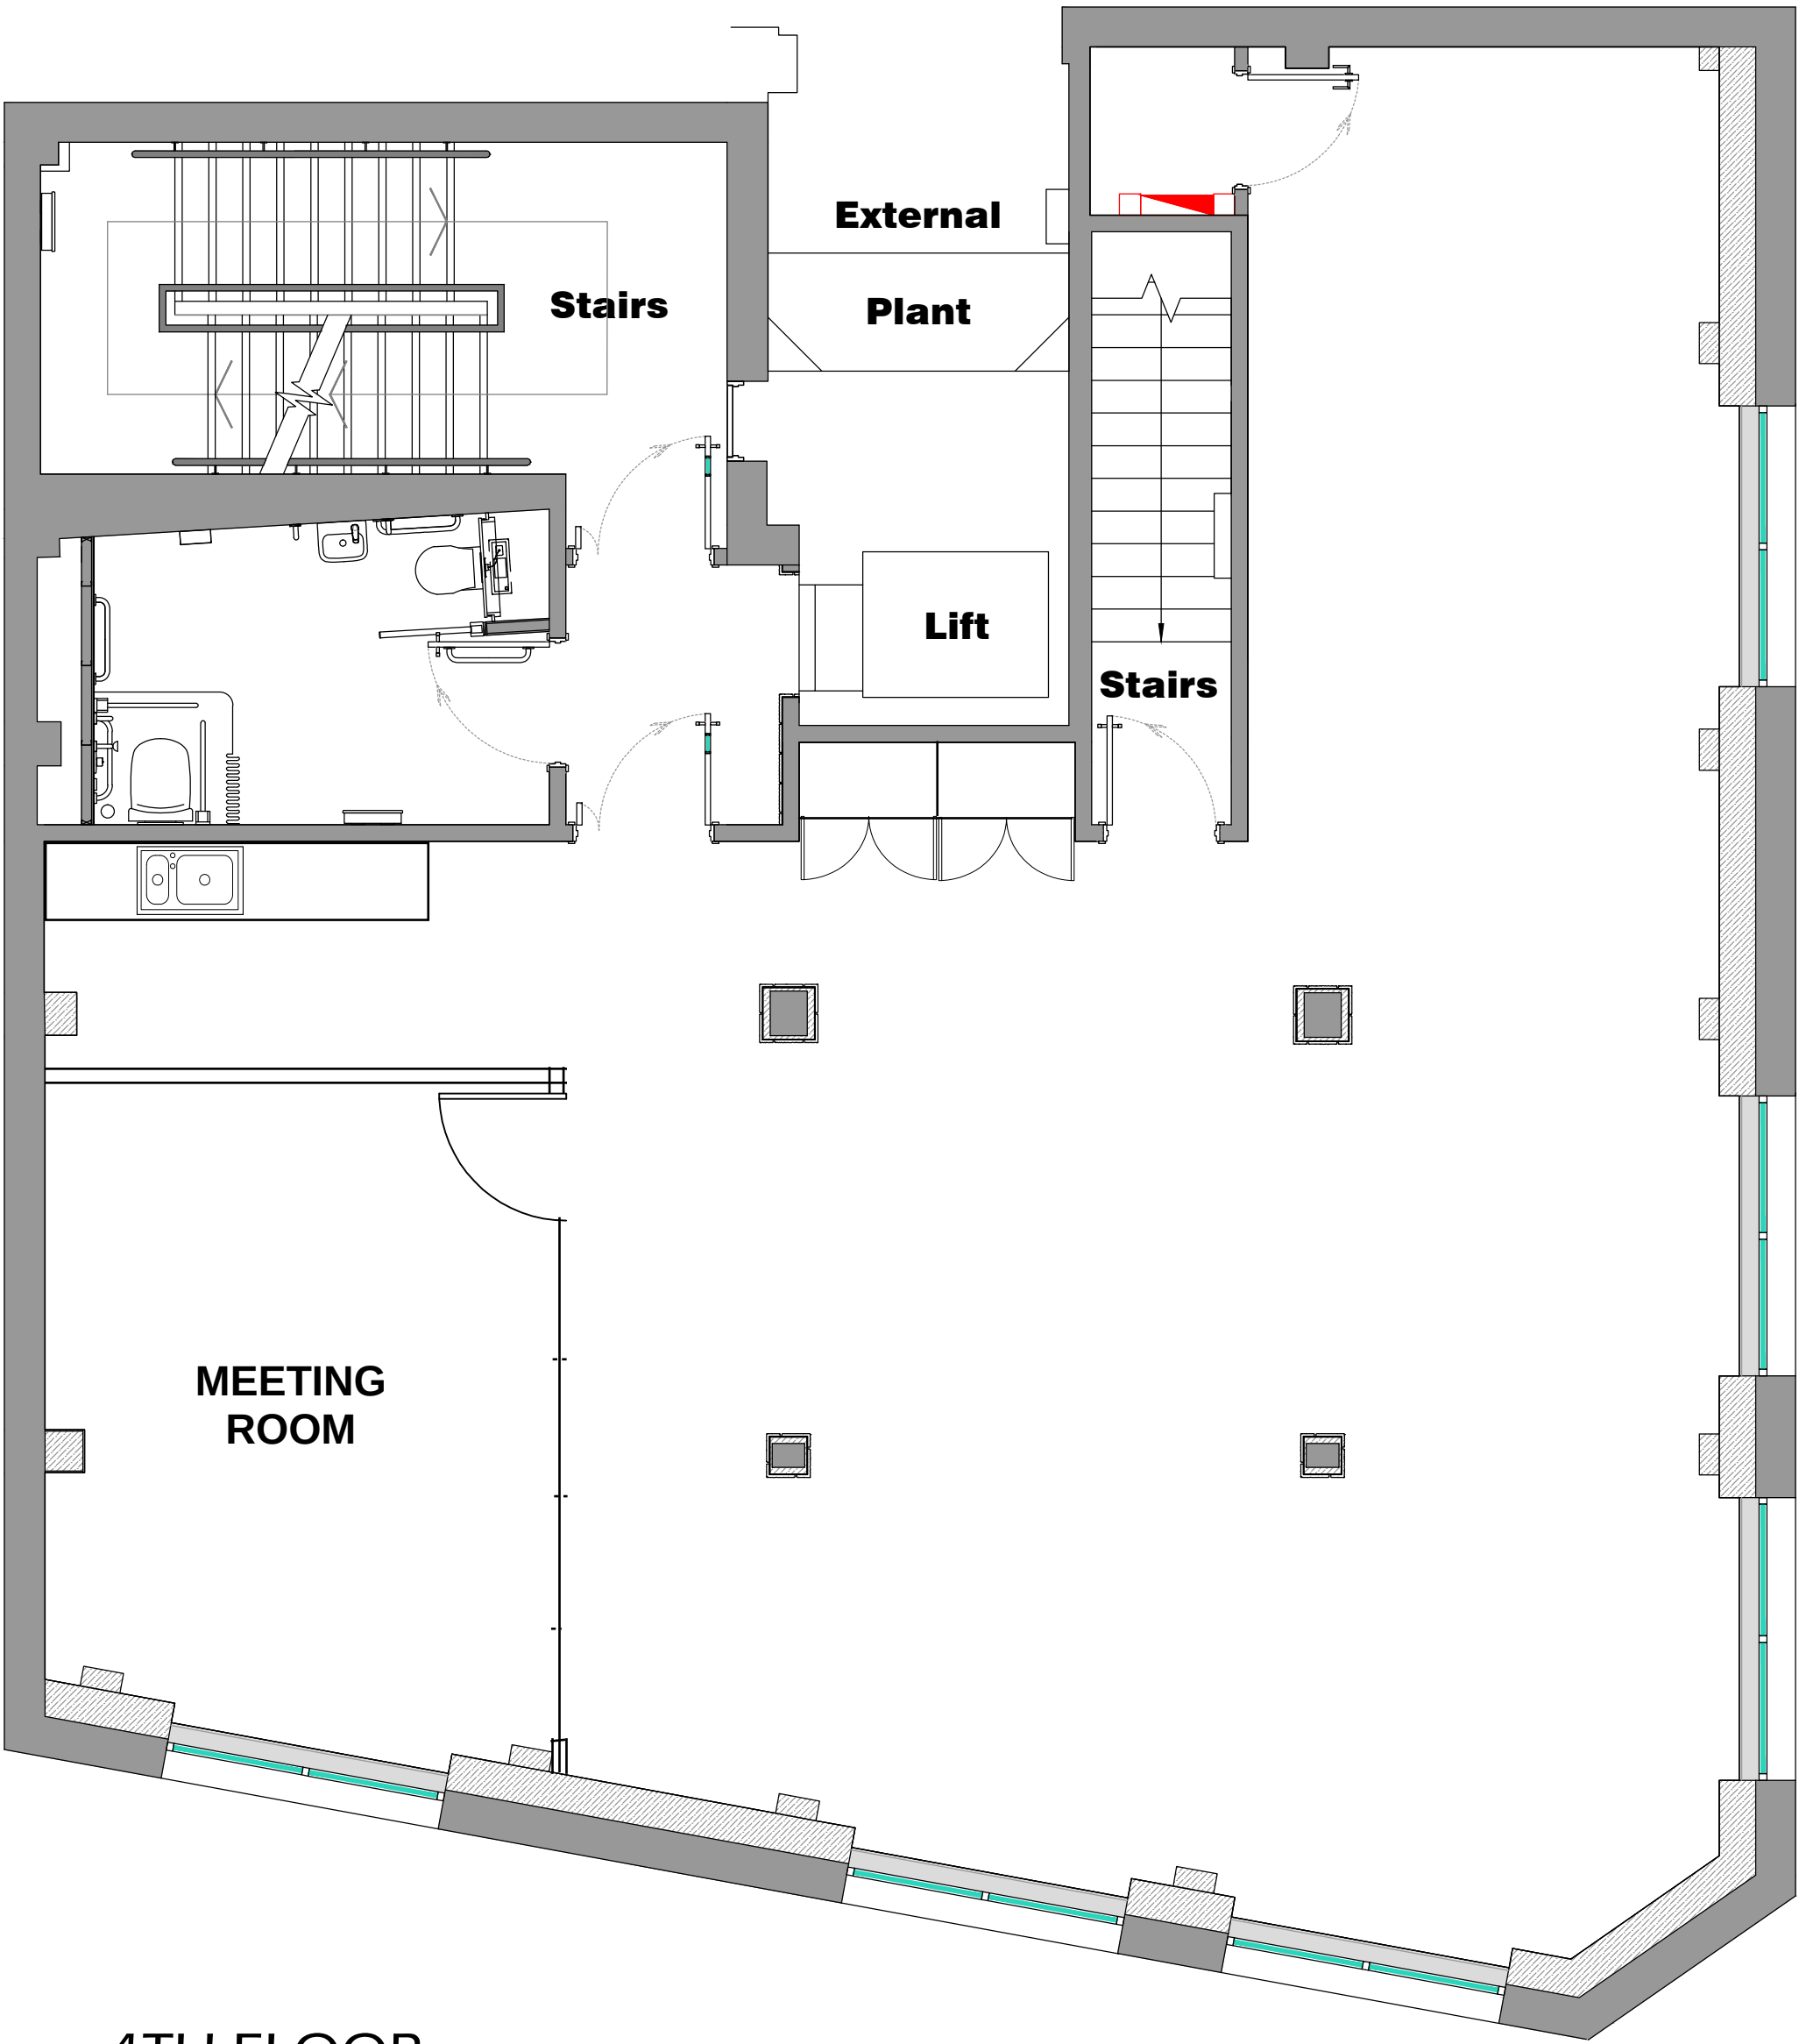

4TH FLOOR

AS-BUILT

Ranne Creative Interiors
Thremhall Park, The Priory
Thremhall Park, Start Hill
Bishop's Stortford, Herts
CM22 7WE
T: +44 (0) 1279 874 688
F: +44 (0) 1279 874 303
www.ranne.co.uk
Client:
Peer Group
Drawing Title:
GA Plan - 4th Floor
Location:
2-4 Southwark Street
Southwark
London
SE1 1TQ
Date Drawn:
28/11/17
Drawn by:
SF
Reviewed by:
KD
Paper sizes:
A1
Scale:
1:50
Drawing Number
RCI/1889/006
Revision
AB