


The information contained herein is classified "confidential". It is the sole property of British Land and any use there of and/or reproduction there of is expressly prohibited without the written consent of British Land.

It is the responsibility of Contractors and/or Clients to check measurements displayed on the drawings. British Land accepts no responsibility for errors brought about by incorrect measurements.



Notes:

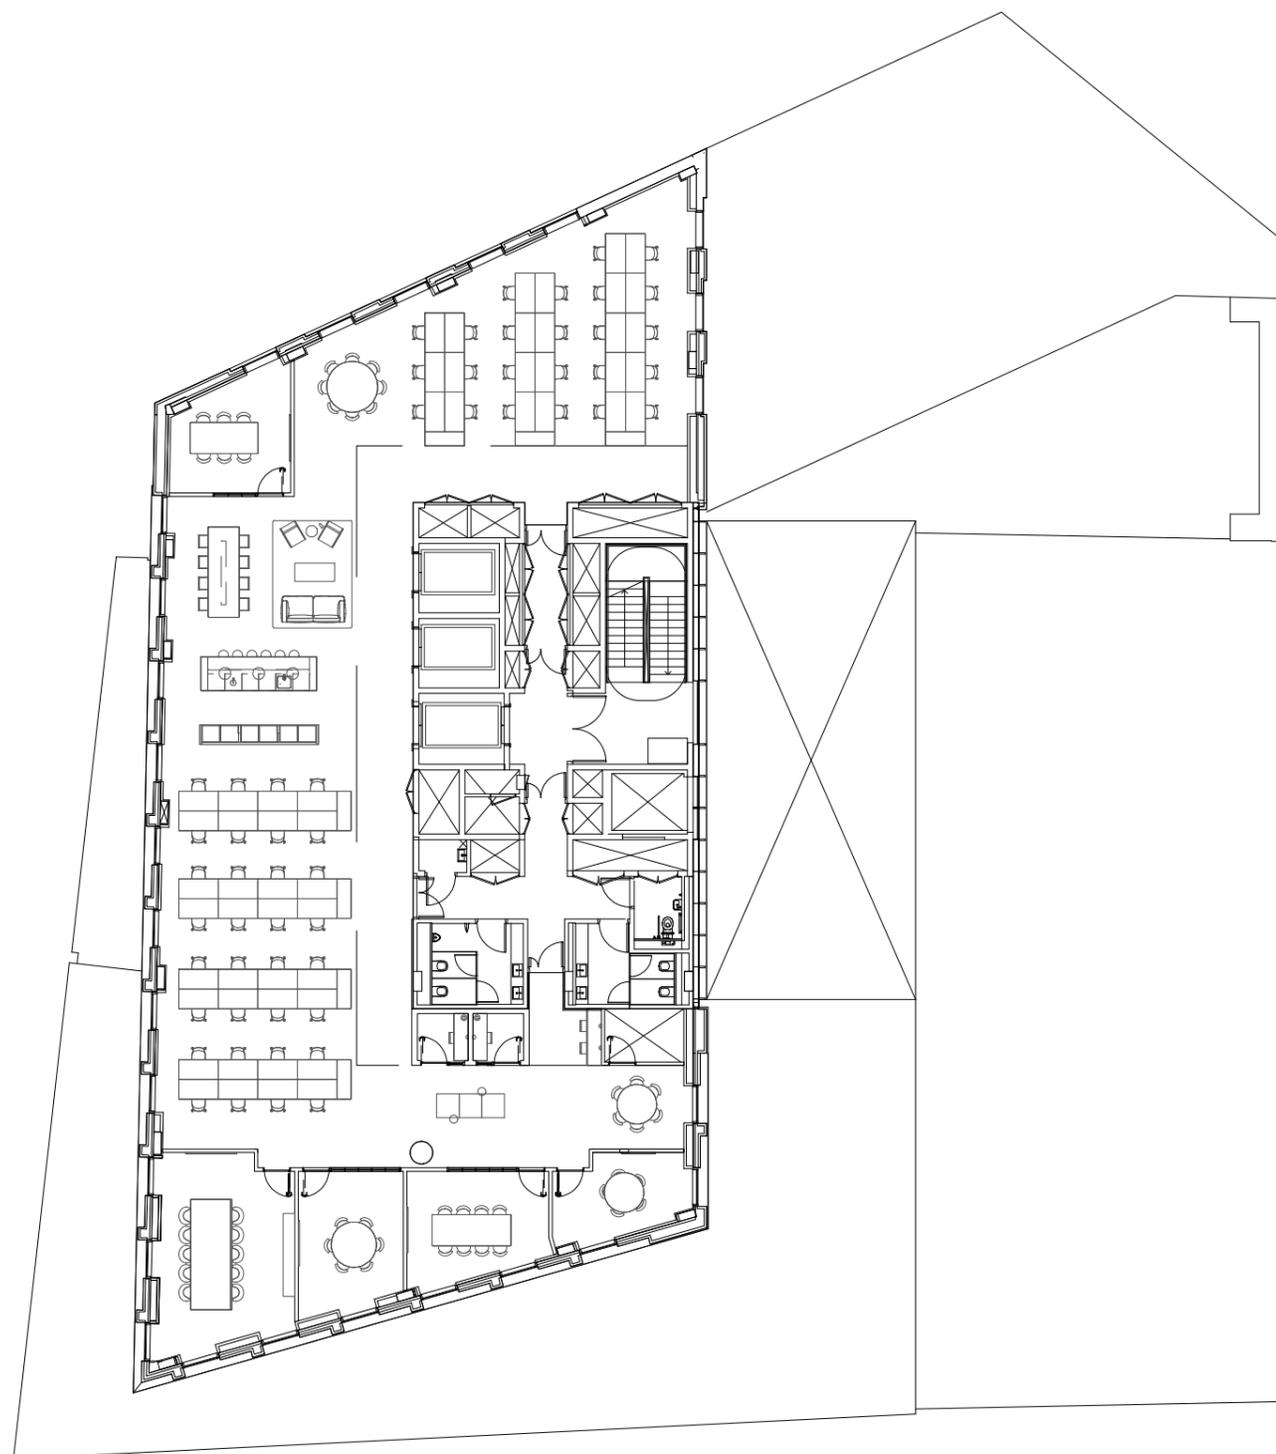

| Rev. | Description | Init. | Date |
|------|-------------|-------|------|
| | | | |
| | | | |
| | | | |

Work Ready

BY BRITISH LAND

Tel: 020 7467 3451
www.britishlandworkspace.com

Facility Address
**ELDER YARD
LONDON
E1 6DB**

Customer

Drawing Title
**LEVEL 7
AS INSTALLED**

| | | |
|-----------------------|-------------------------|----------------------------|
| Drawn By DJ | Scale | |
| Checked By | Date 25.11.25 | Scale 1:250 @ A3 |
| file name | | |