




Unit 9. West Elevation

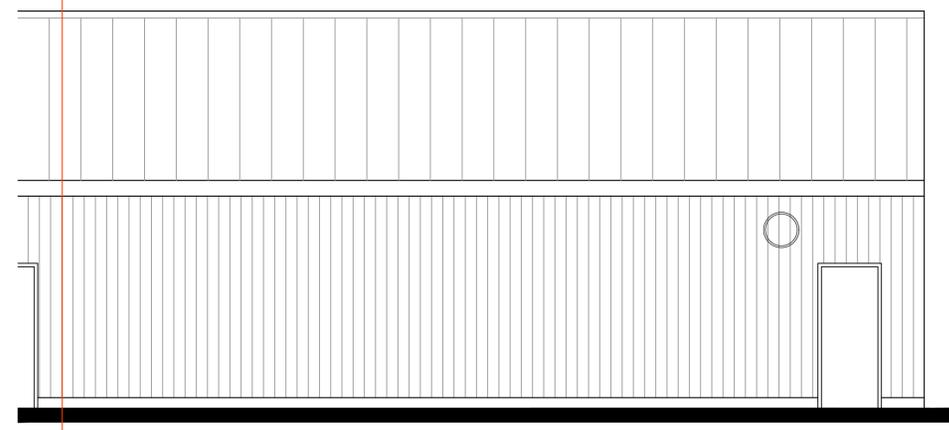

Unit 9. East Elevation

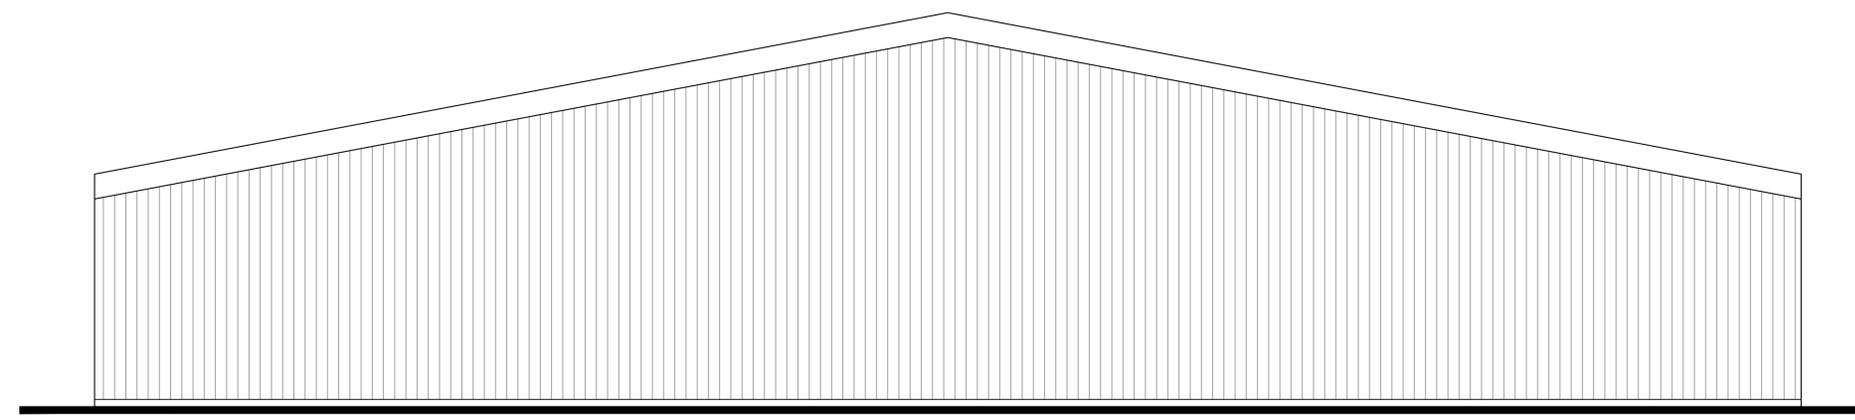

Units 9. North Elevation

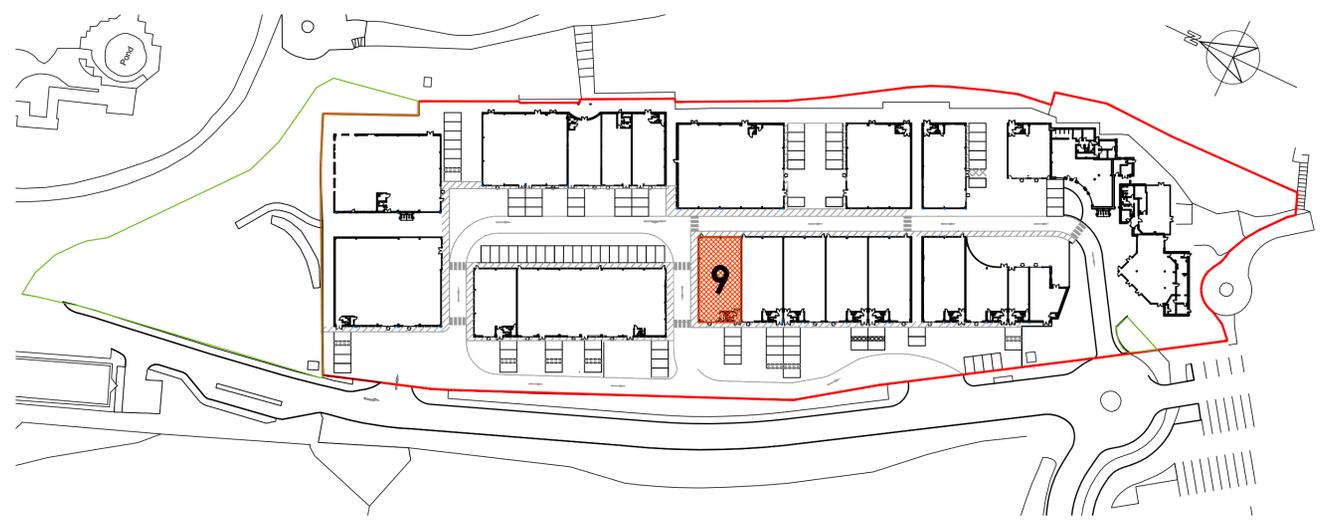

SITE PLAN 1:1000

UNIT:
UNIT 9
 NET INTERNAL FLOOR AREA = 283.8 Sq.M
 = 3054 Sq.Ft


Creation Design
 Creation Design - Wales
 Tel: 01495 616277 / 07508890294
 www.creationdesign-wales.com
 E-mail: info@creationdesign-wales.com

PROPOSED REDEVELOPMENT
 FORMER FESTIVAL PARK SITE
 QUEEN STREET
 VICTORIA, EBBW VALE
 NP23 6UN

UNIT 9. PLAN & ELEVATIONS

DATE: June 2024	DRAWN BY: P.P.
SCALE(S): 1:50 @ A1	DRAWING NO: 24-073/AB/9