


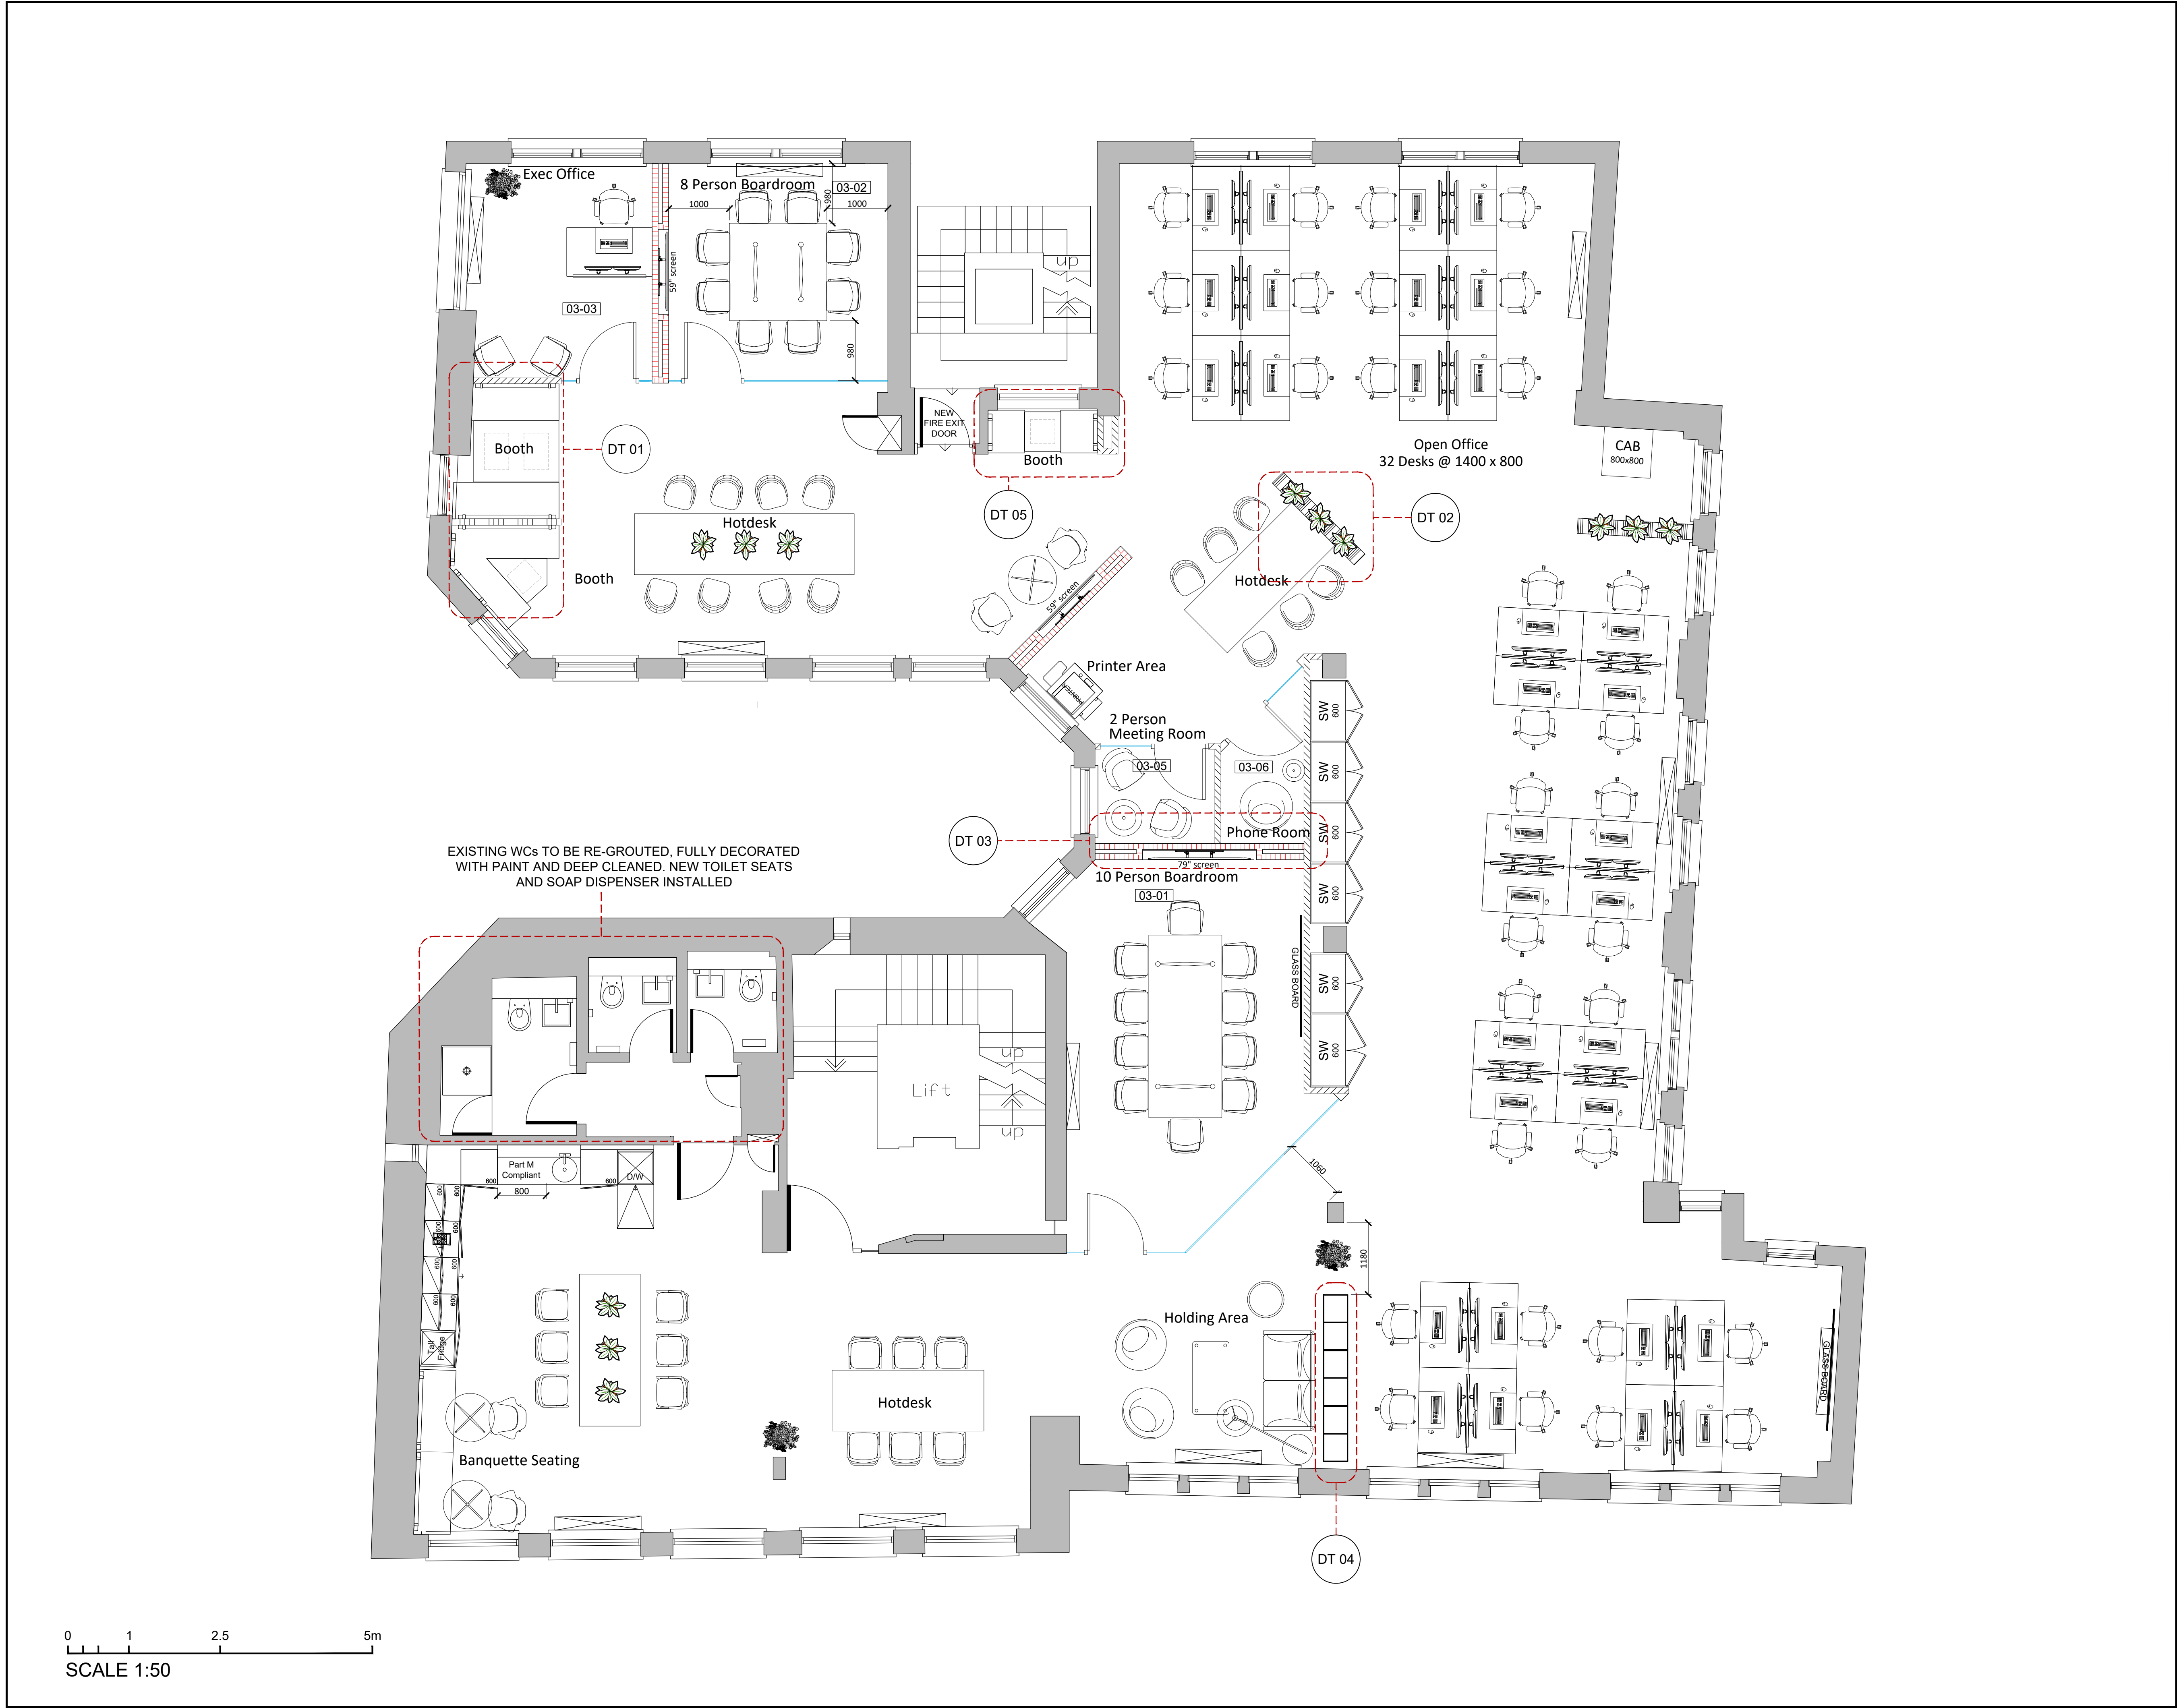

**NOTE**  
This drawing is not to be scaled.  
Appointed contractors are requested to notify Peldon Rose Limited of any discrepancies or variations relating to setting-out prior to manufacture and construction.  
All information is subject to statutory approval and site survey.  
The general contractor is to carry out a check site survey to confirm that the design intent can be met and that it is appropriate for the environment in which it is to be installed.  
The general contractor is to notify Peldon Rose Limited in writing of all preparation works that are required to be carried out prior of their works.

**DRAWING STATUS**  
**RECORD DRAWING**

**TOTAL SQUARE FEET**  
3630 FT<sup>2</sup>

| KEY   |                                                     |
|-------|-----------------------------------------------------|
| 03-04 | ROOM REFERENCE NUMBER                               |
|       | EXISTING SOLID CORE TIMBER DOOR (SEE DOOR SCHEDULE) |
|       | NEW SOLID CORE TIMBER DOOR (SEE DOOR SCHEDULE)      |
|       | NEW 100MM FULL HEIGHT PARTITION (FROM RAF)          |
|       | NEW FULL HEIGHT PARTITION WALL WIDTH TBC (FROM RAF) |
|       | NEW 250MM HALF HEIGHT PARTITION (FROM RAF)          |
|       | NEW 100MM HALF HEIGHT PARTITION (FROM RAF)          |
|       | NEW 30MM FULL HEIGHT GLASS PARTITION (FROM RAF)     |

| REVISIONS |      |             |     |     |
|-----------|------|-------------|-----|-----|
| REV       | DATE | DESCRIPTION | INI | CHK |
|           |      |             |     |     |
|           |      |             |     |     |
|           |      |             |     |     |

**CLIENT**  
SCHRODERS

**PROJECT ADDRESS**  
**THIRD FLOOR**  
53 PARKER STREET  
LONDON WC2B 5PT

**DRAWING TITLE**  
**GENERAL ARRANGEMENT**  
**RECORD DRAWING**

**Creating a Work/Love Balance**

**Peldon Rose**

**Peldon Rose Limited**  
Sterling House, 42 Worpole Road  
London SW18 4EQ

Telephone: 020 8971 7777      web: [peldonrose.com](http://peldonrose.com)

|                        |           |            |
|------------------------|-----------|------------|
| DATE                   | SHEET     | DRAWN BY   |
| 24.09.2020             | A1        | GH         |
| SCALE                  | FILE REF. | CHECKED BY |
| 1:50 @ A1 - 1:100 @ A3 | GA        | TV         |

| DRAWING NUMBER |            |        |          |
|----------------|------------|--------|----------|
| PROJECT NUMBER | FLOOR/TYPE | NUMBER | REVISION |
| EN2615         | 03         | 01     | RD       |

This drawing is protected under copyright and at no time should this drawing be reproduced in whole or in part without the permission of Peldon Rose Limited.

© COPYRIGHT  
0 1 2 3 4 5 6 7 8 9