


The information contained herein is classified "confidential". It is the sole property of British Land and any use there of and/or reproduction there of is expressly prohibited without the written consent of British Land.

It is the responsibility of Contractors and/or Clients to check measurements displayed on the drawings. British Land accepts no responsibility for errors brought about by incorrect measurements.



Notes:

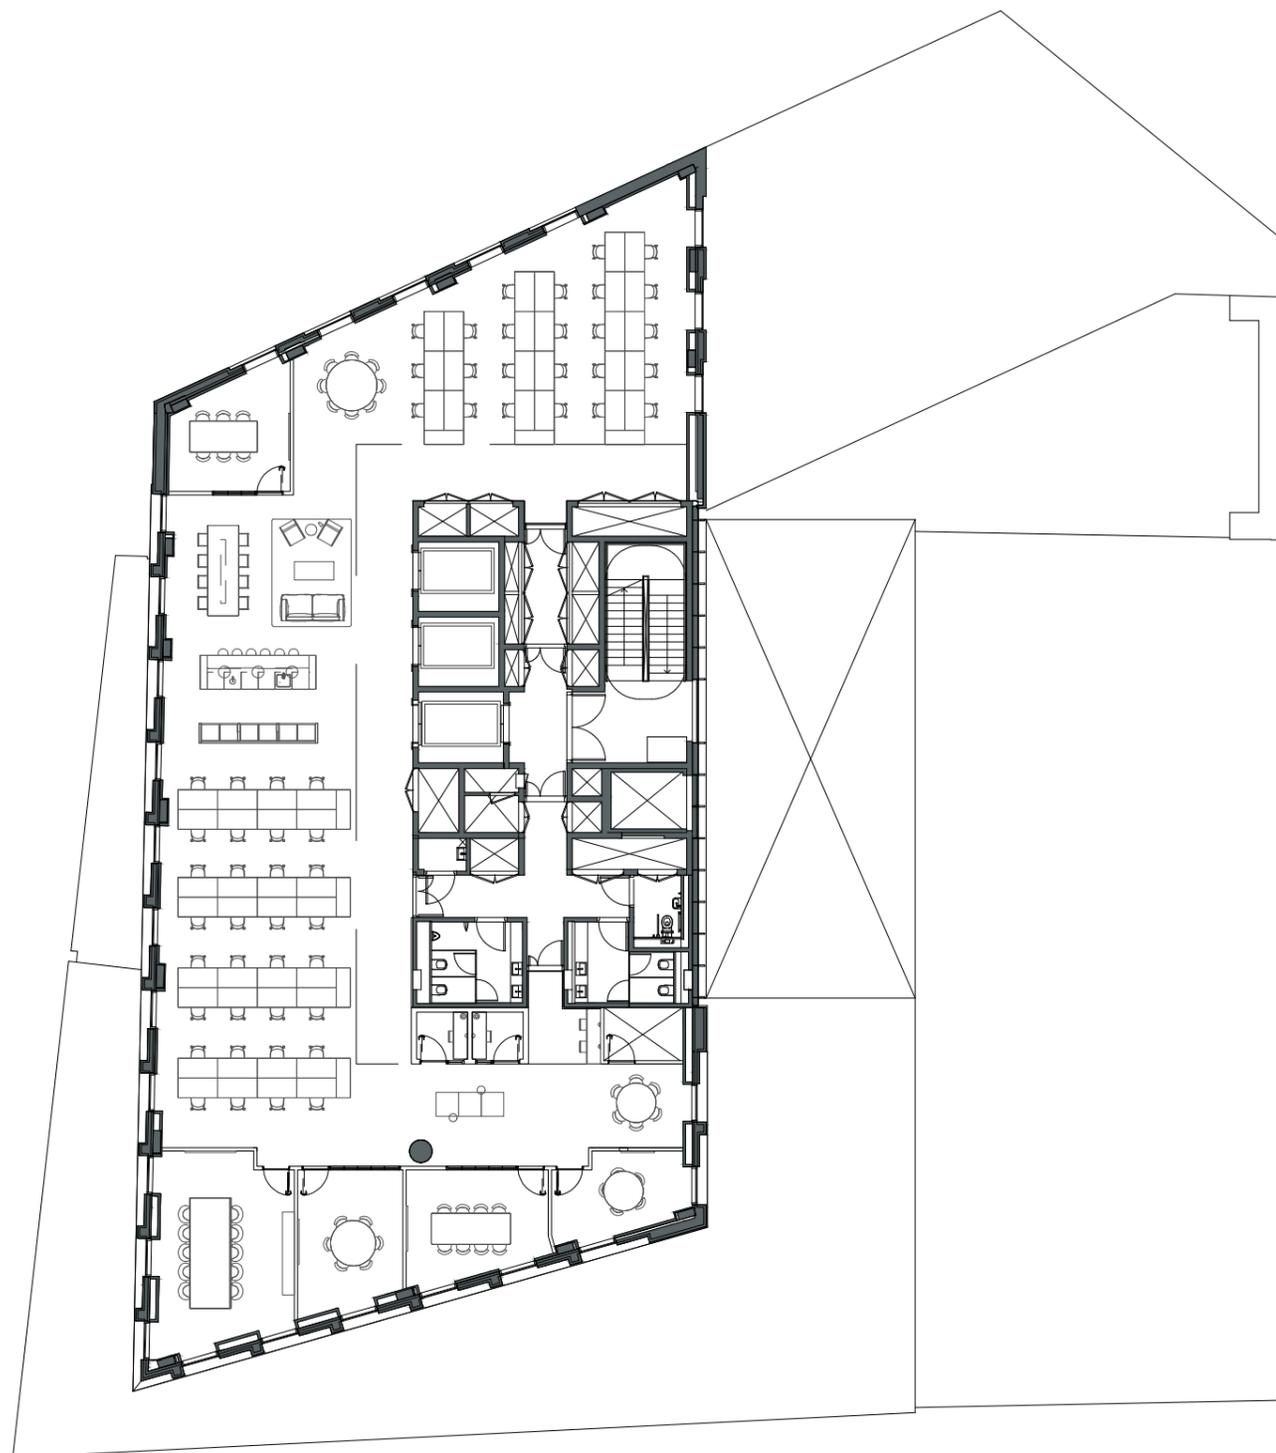

Rev.	Description	Init.	Date

Work Ready BY BRITISH LAND	
Tel: 020 7467 3451 www.britishlandworkspace.com	
Facility Address ELDER YARD LONDON E1 6DB	
Customer	
Drawing Title LEVEL 8 AS INSTALLED	
Drawn By DJ	
Checked By	Date 25.11.25
	Scale 1:250 @ A3
file name	