


This drawing is Copyright © of W1 Contracts Limited.
Drawing provided by a 3rd Party.
Do not scale this drawing.
All dimensions to be checked on site.
Drawing to be read in conjunction with any specifications,
schedules and Consultants drawings and details.

KEY:

-  LIGHT FITTING
E = Emergency Light
-  SMOKE DETECTOR
-  ACCESSIBLE W/C
ALARM PULL CORD
-  EV CHARGING POINT
-  EMERGENCY
FIRE EXIT

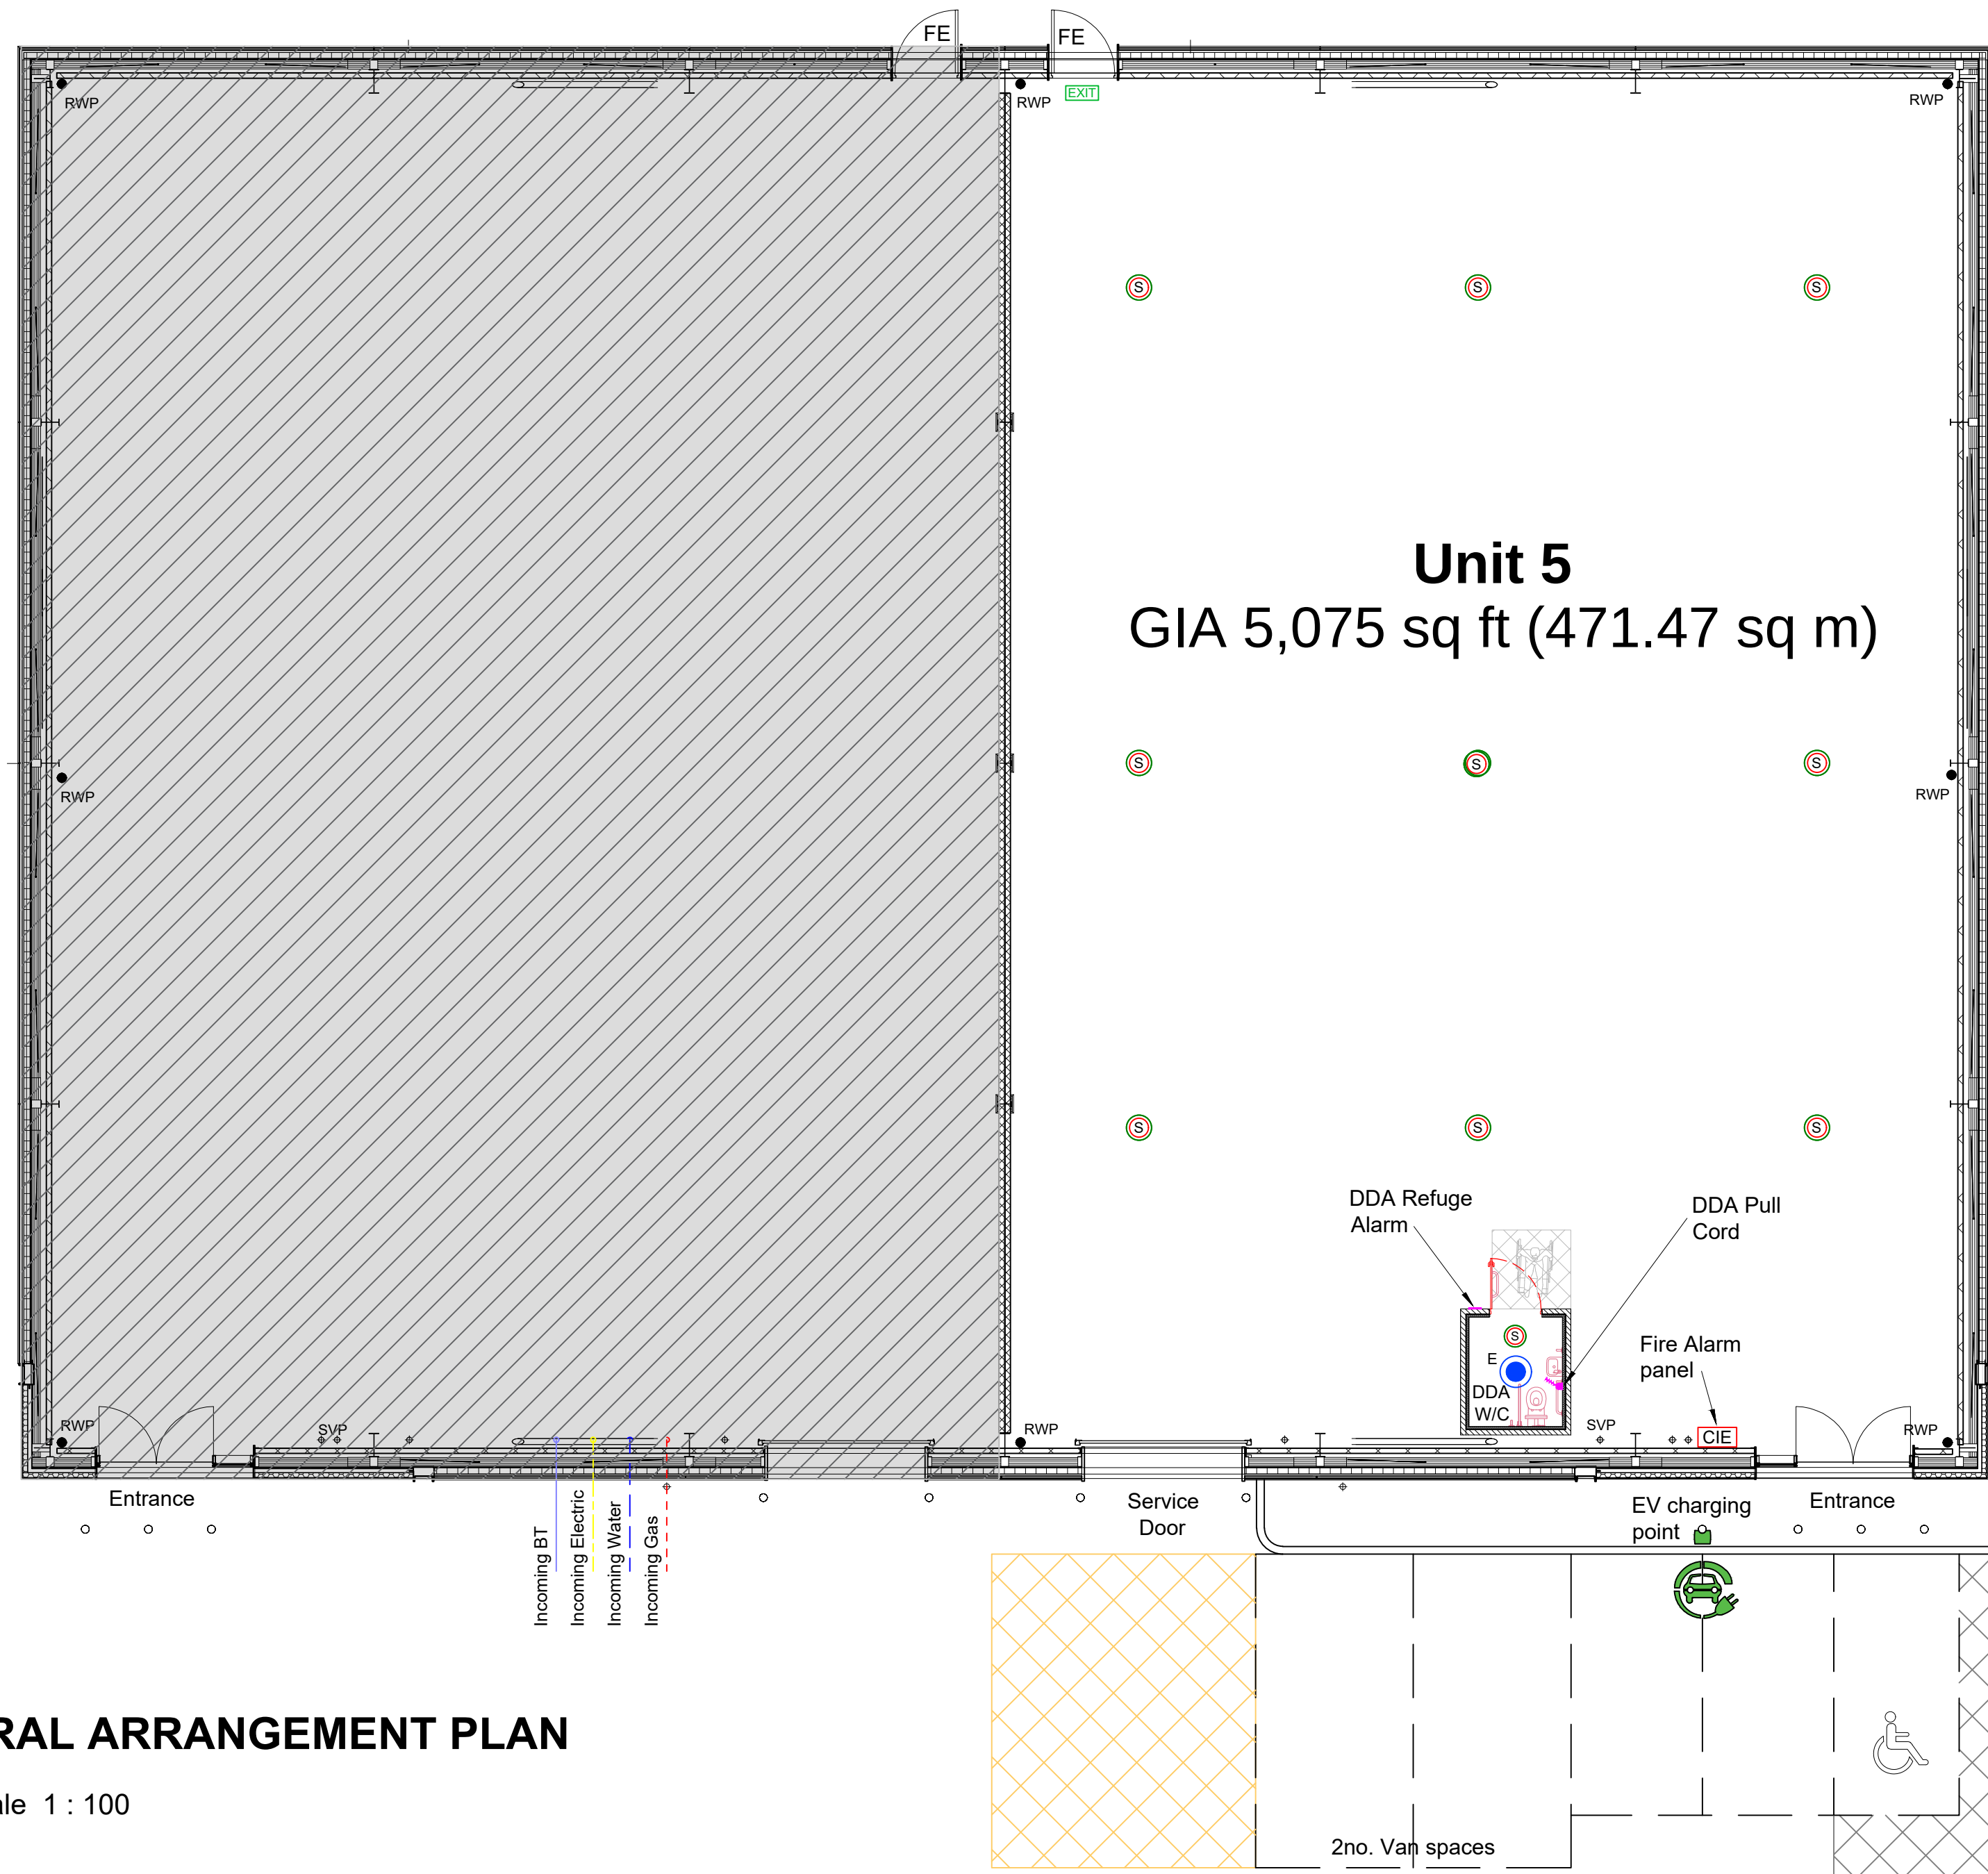

BLOCK C - GENERAL ARRANGEMENT PLAN

0 1 2 5m

Scale 1 : 100

A As-Built issue GML - 13.11.25

Rev Comments Drawn Chk'd Date



T: 0203 300 0134
E: info@w1td.co.uk
W: www.w1td.co.uk
Berkeley Sq. House, London, W1J 6BD.

Project
TRADE UNIT - Unit 5, Deltic Trade Park,
Deltic Avenue, Milton Keynes, MK13 8LD

Client
DTZ Investors

Drawing Title
GENERAL ARRANGEMENT PLAN
AS-BUILT

Drawn By Chk'd By Scale @ A2 Date
SS/GL C.B 1:100 13/11/2025

Project No. Drawing No. Revision
14235 W1-E101 A

AS-BUILT

A2