


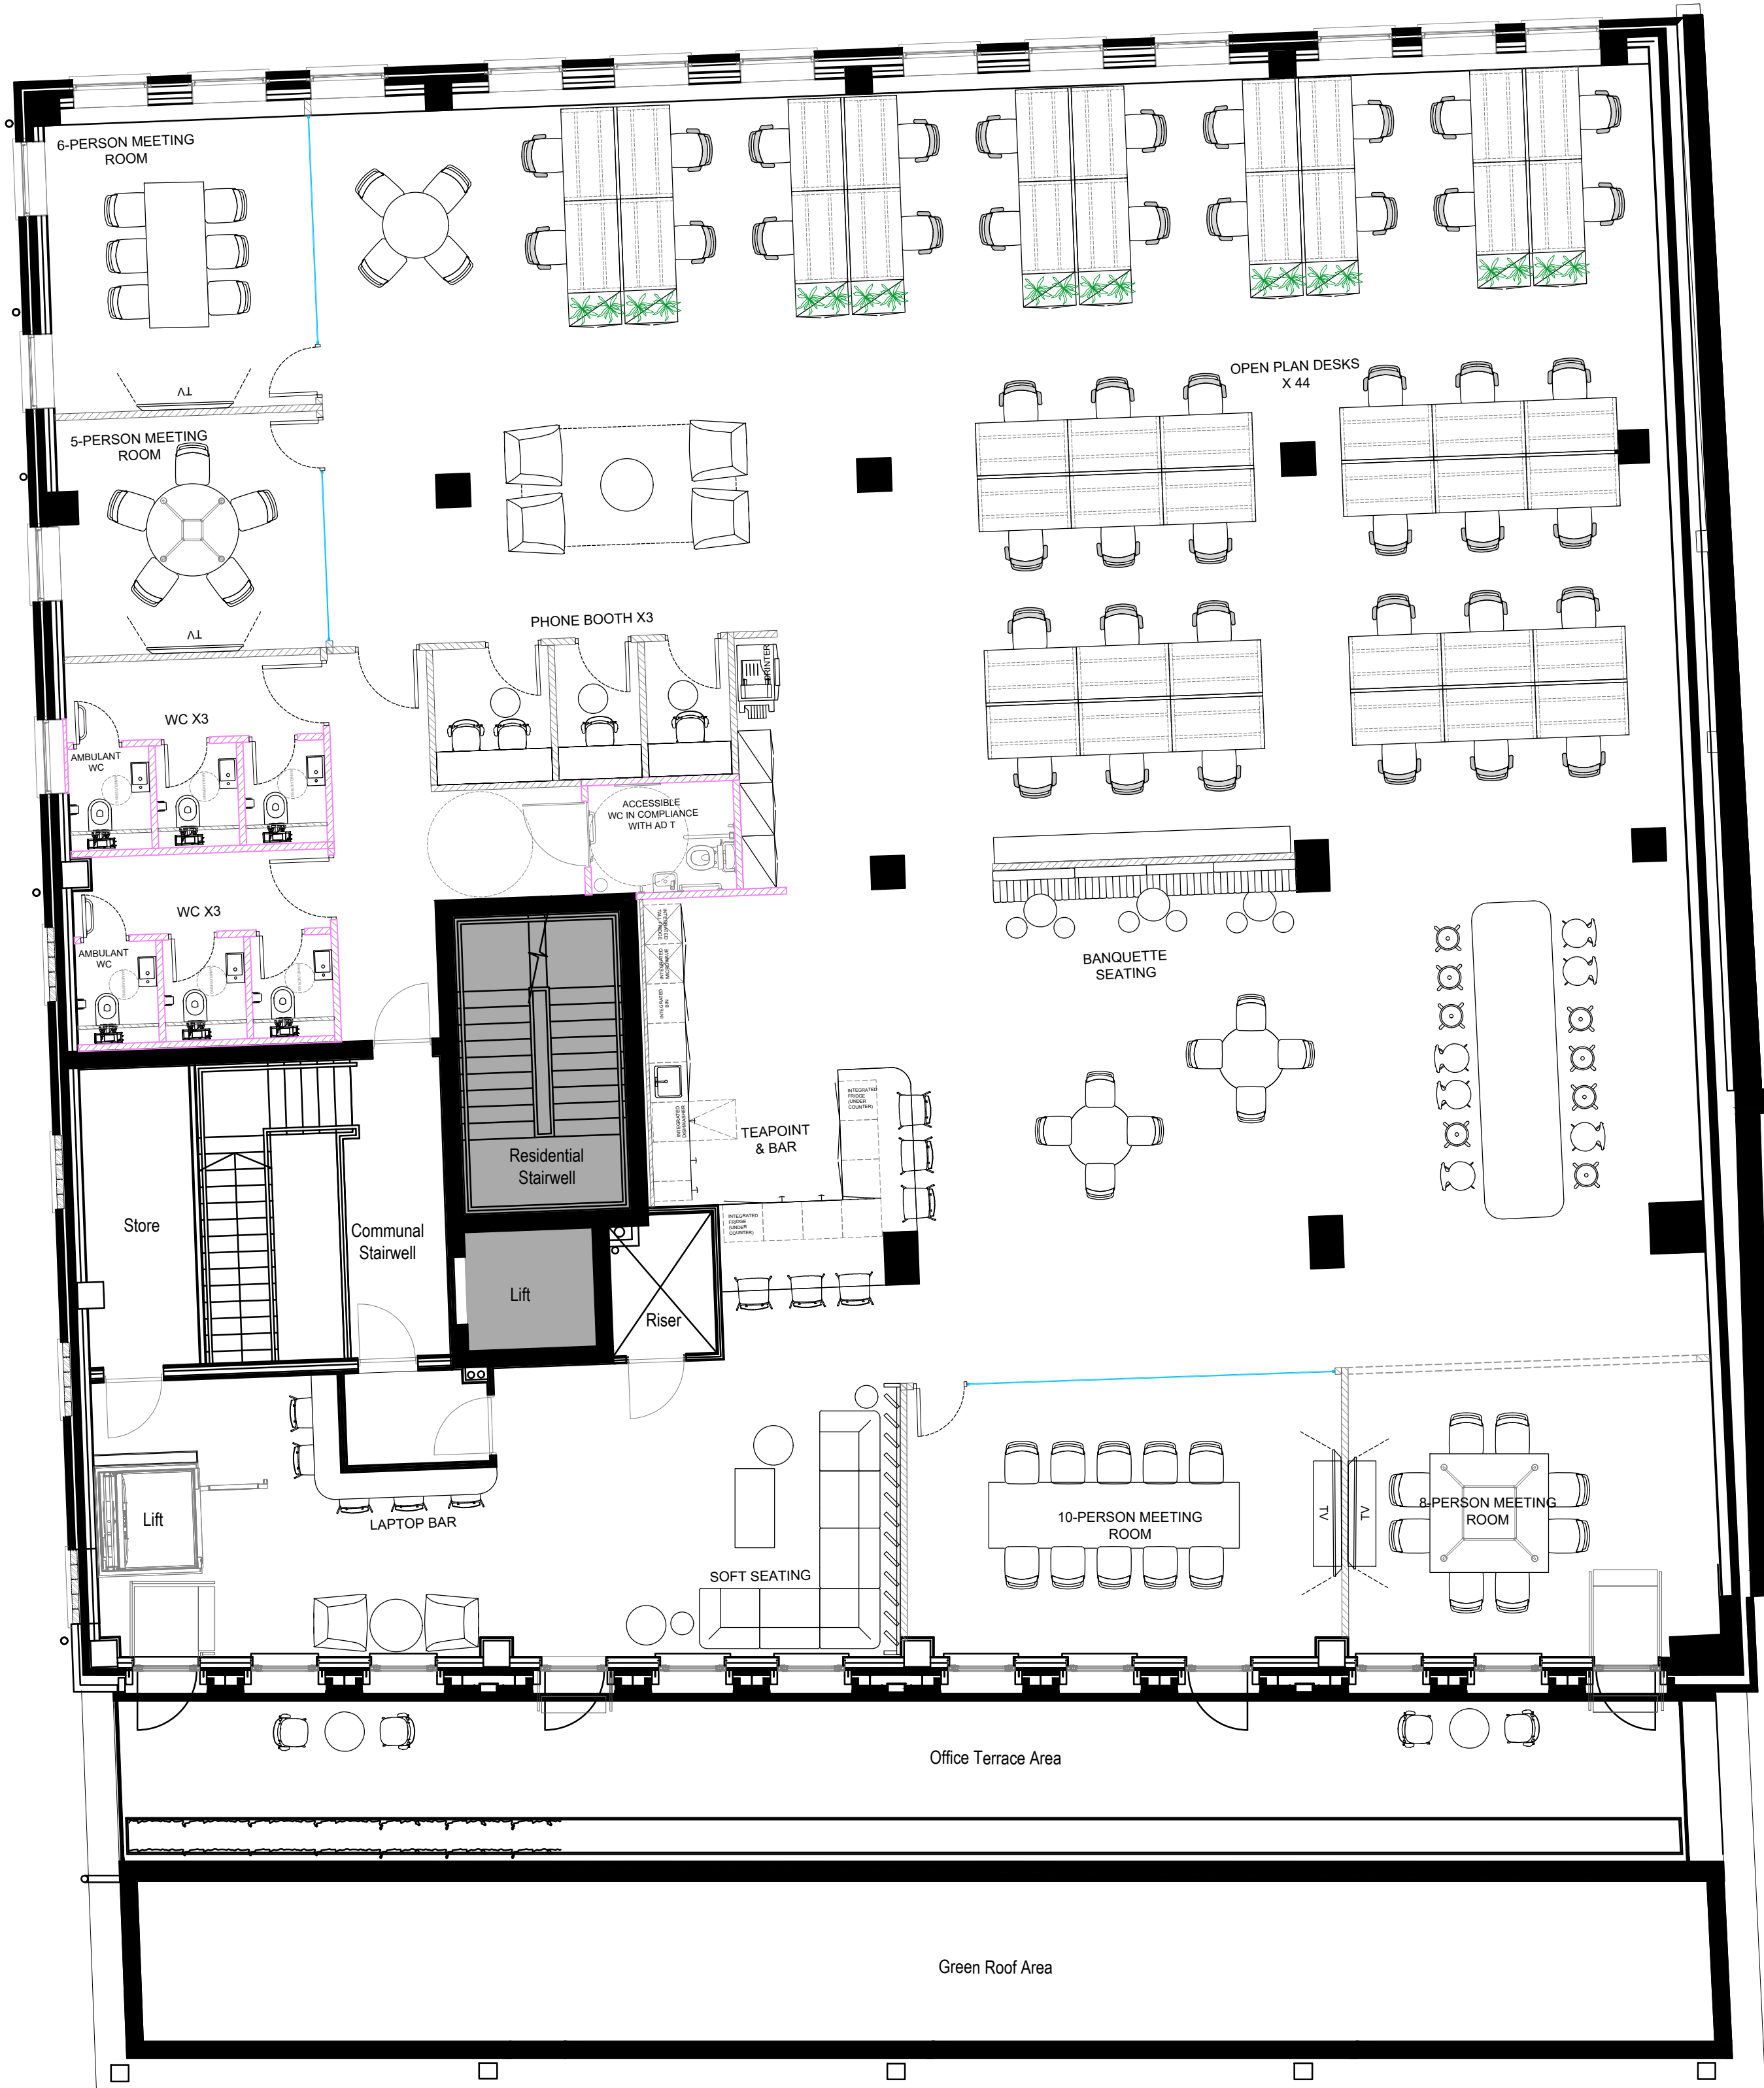

Floor

01

KEY TO GENERAL ARRANGEMENT

Some symbols shown may not appear in drawing, and may not be to scale. Drawing must be printed in colour.

Existing fit-out & basebuild

Existing basebuild wall or partitioning

Existing glazing

Existing solid single door

Existing glass single door

Existing solid double door

NO WORKS to landlord areas

New partitioning, glazing and doors

New partitioning

New glazing

Refer to PSO drawing for specification

New solid single door

New glass single door

New solid double door

Refer to door schedule for specification

Furniture

New furniture

Existing furniture

Expansion furniture

Low height storage unit

Medium height storage unit

Tall height storage unit

(double doors)

(drawers)

(tambour door)

Joinery, Tea Points, Storage Wall etc. Examples shown below only. Refer to scope of works, detail drawings & finishes schedule.

Reception Desk

Tea Point

Full height integrated storage cupboards

Full height integrated coat cupboards

REV	DESCRIPTION	BY	DATE
DRAWING STATUS			
AS BUILT			
Frasers Group			
Address 152-156 Kentish Town Road London NW1 9QB			
Project Number	WP274	Floor	01
		Detail	GA
Drawing Title			
First Floor			
General Arrangement			
Produced by	Scale	Date Created	Rev
MT/AJ	1:75@A1	19/09/2024	AB
WHITEPAPER 7-10 Bateman's Row London, EC2A 3HH			
hello@whitepaperco.com +44 203 859 4444			