


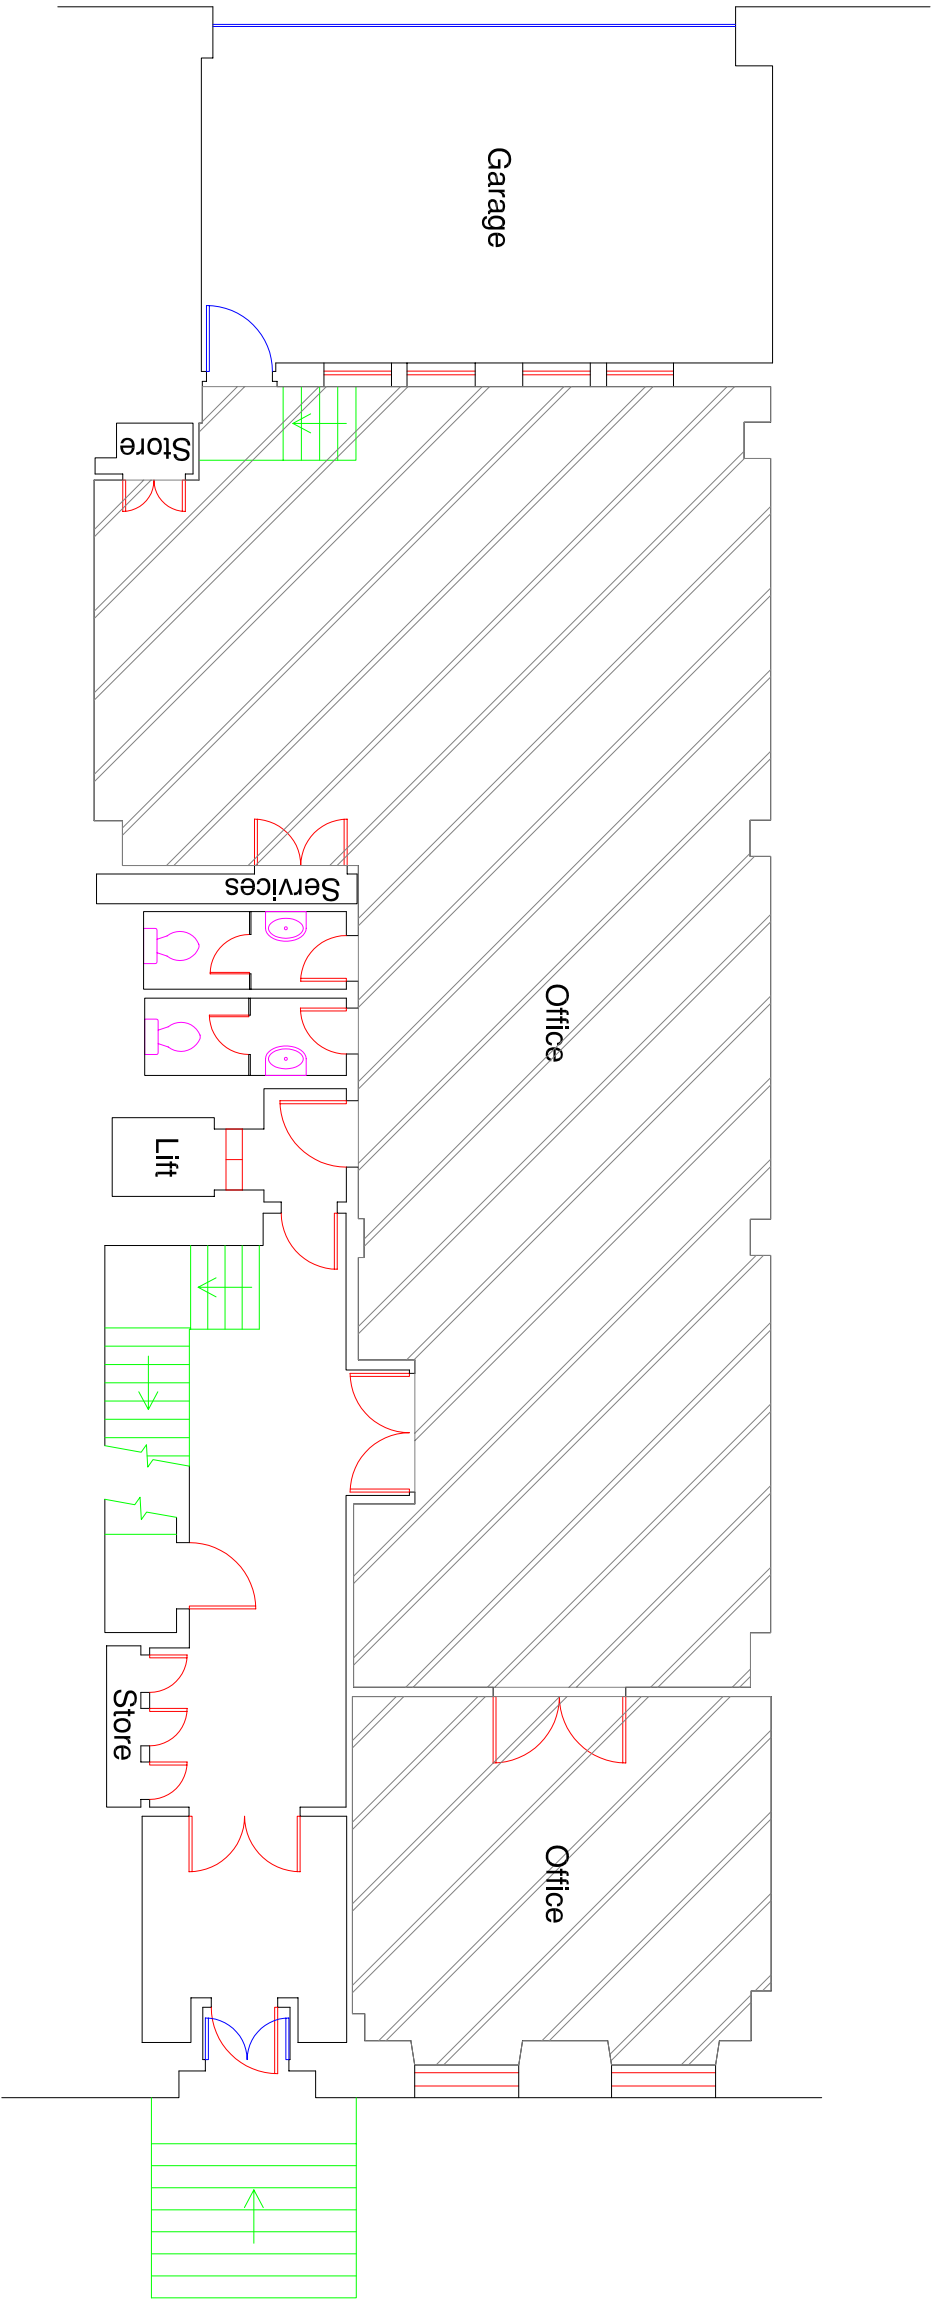


Ground Floor
NIA - 144.00sqm (1550sqft)

Project/Location	146 West Regent Street, Glasgow		Drawn By	MW	Date	Nov 2010	Rev
			Checked By	BG	Scale	1:50	
Drawing Title	GROUND FLOOR AS BUILT SURVEY		Dwg No	01-04			




CADmeleon House, Castle St Ind Est
Aloa ~ FK10 1EU ~ SCOTLAND
www.cadmeleon.co.uk t. 01259 211456
www.assethunter.co.uk f. 01259 219909

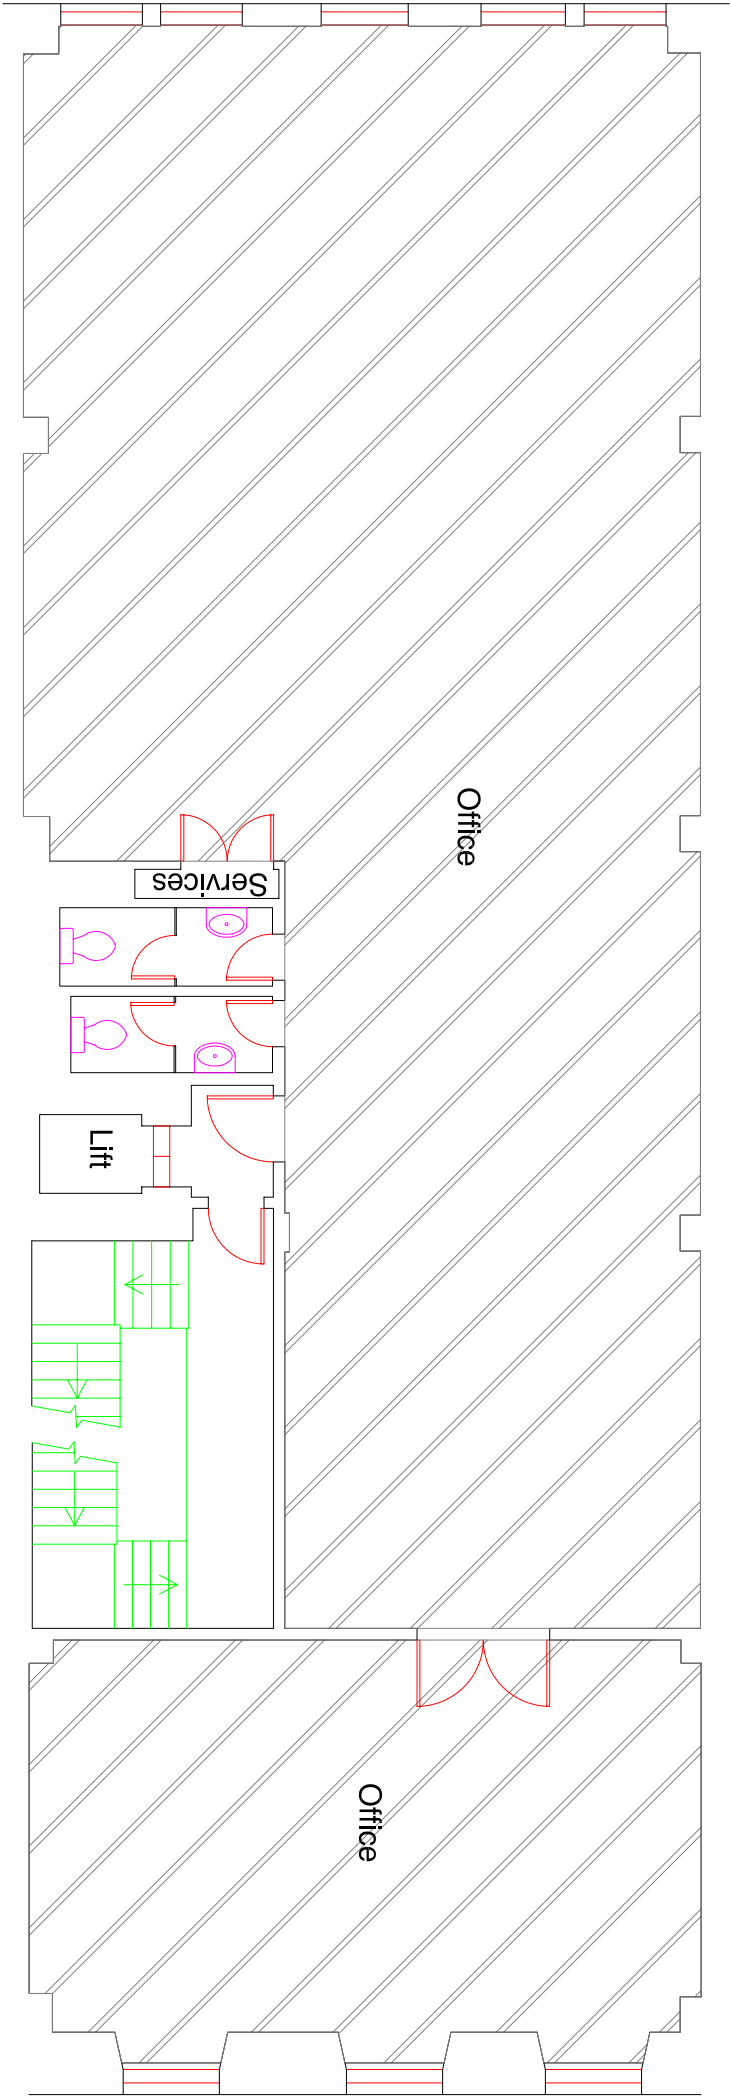

 **First Floor**
NIA - 209.82sqm (2258sqft)

Project/Location	146 West Regent Street, Glasgow			Rev		
	Drawn By	MW	Date			Nov 2010
	Checked By	BG	Scale			1:50
Drawing Title	FIRST FLOOR AS BUILT SURVEY			Dwg No	02-04	
CADmeleon House, Castle St Ind Est Alloa ~ FK10 1EU ~ SCOTLAND www.cadmeeleon.co.uk t. 01259 211456 www.assethunter.co.uk f. 01259 219909						



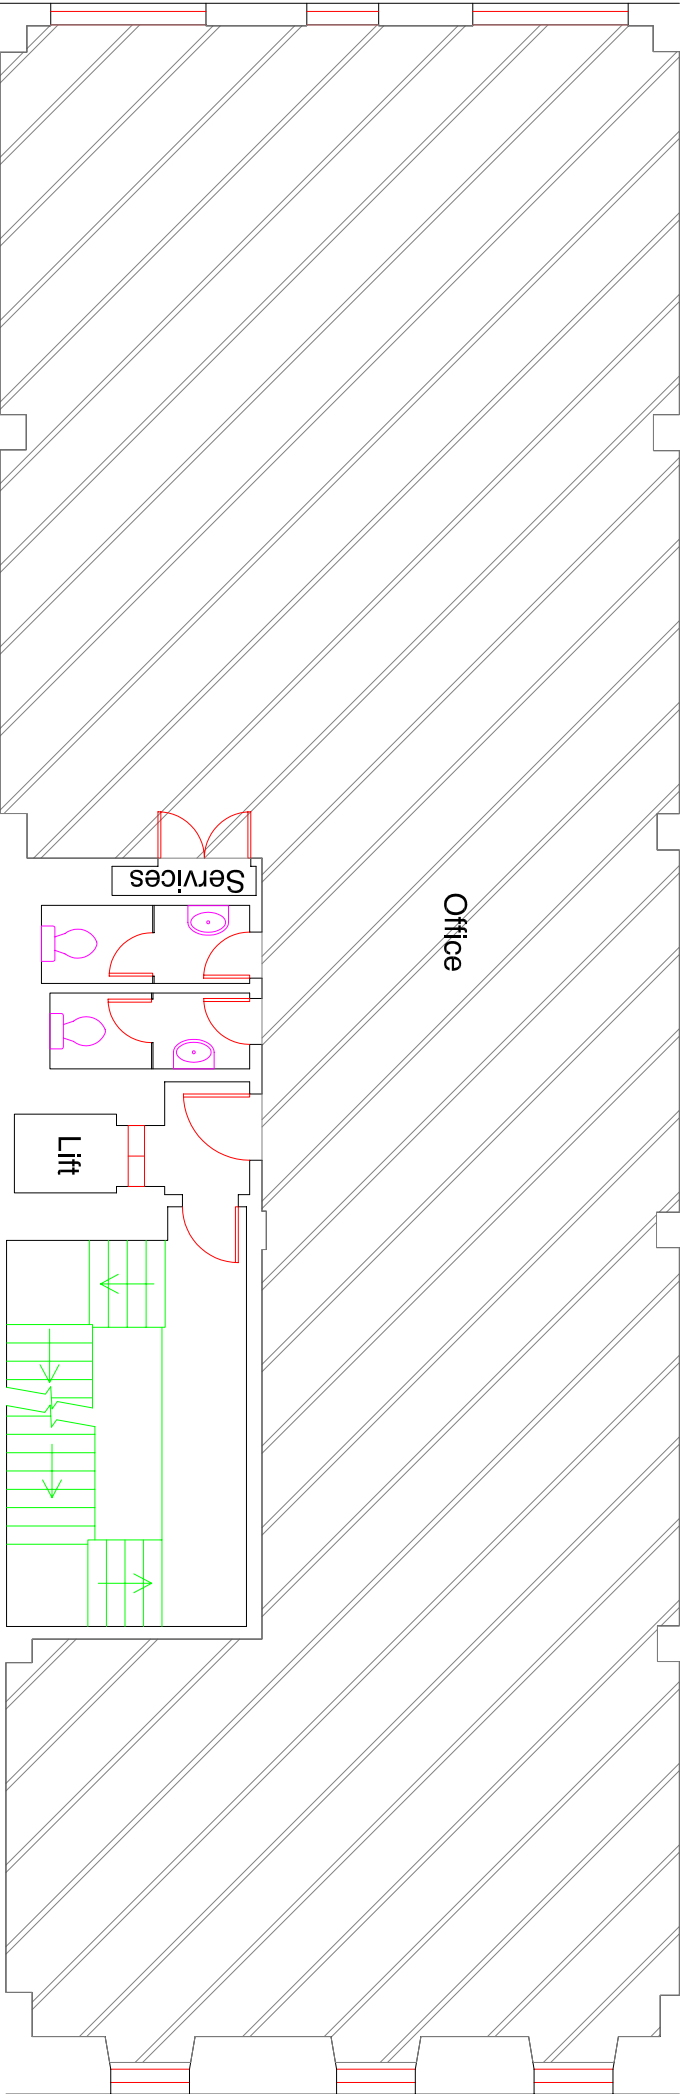


Second Floor



NIA - 211.22sqm (2274sqft)

Project/Location	146 West Regent Street, Glasgow			Drawn By	MW	Date	Nov 2010	Rev
Drawing Title	SECOND FLOOR AS BUILT SURVEY			Checked By	BG	Scale	1:50	
				Dwg No	03-04			

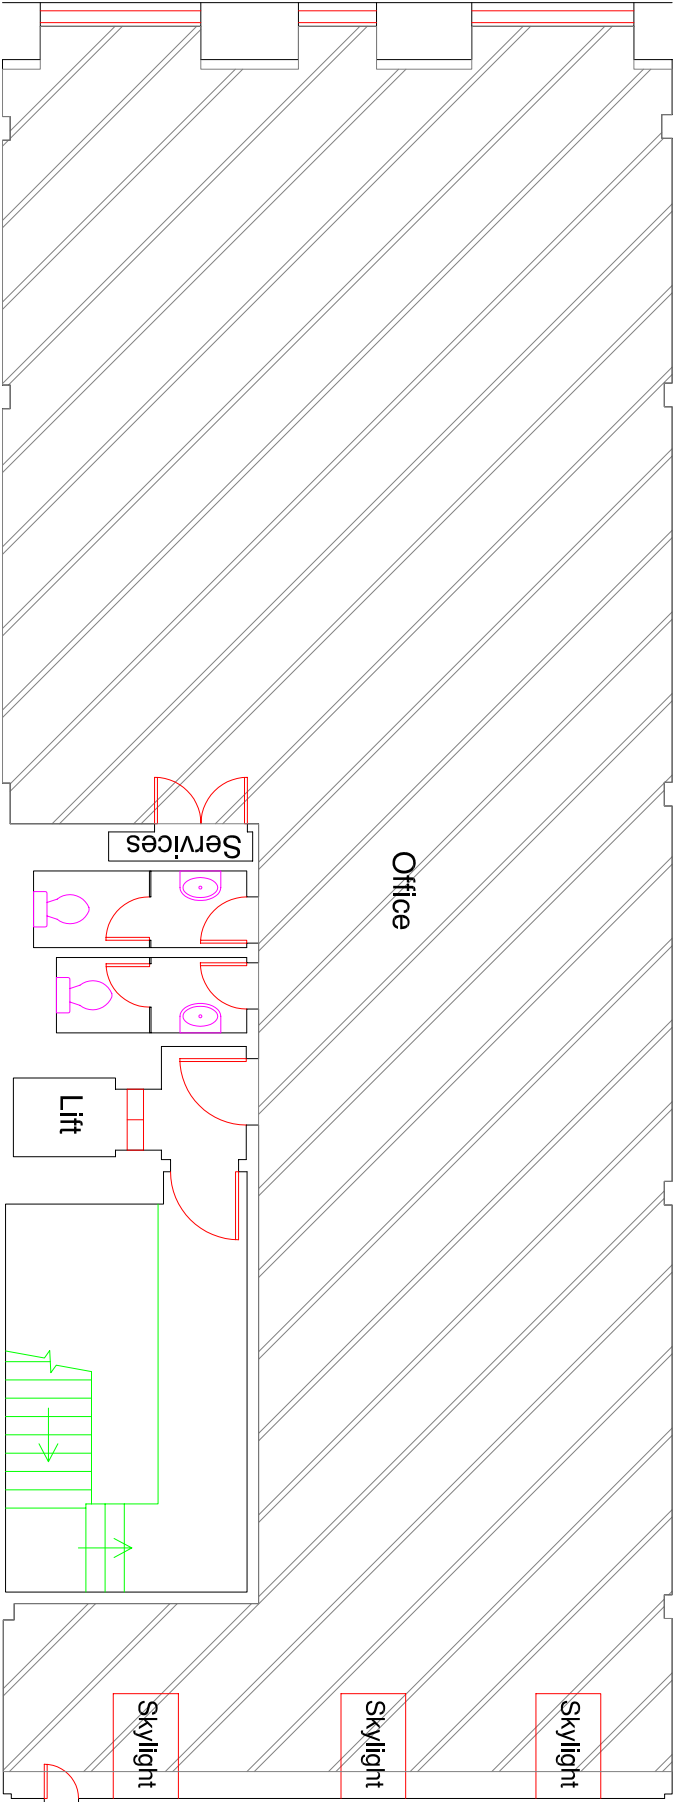

Third Floor

 NIA - 174.49sqm (1878sqft)

Project/Location	146 West Regent Street, Glasgow		Rev
	Drawn By	Date	
	MW	Nov 2010	
Drawing Title	Checked By	Scale	
	BG	1:50	
	Dwg No		
THIRD FLOOR AS BUILT SURVEY		04-04	



CADmeleon House, Castle St Ind Est
Aloa ~ FK10 1EU ~ SCOTLAND
www.cadmeleon.co.uk t. 01259 211456
www.assethunter.co.uk f. 01259 219909