




DRAWING STATUS	
AS FITTED	
Rev.	Description
A	ADDED DATA
B	REVISED TO WIECH GROUP MARK UP
Done / Initial	10.08.15 jpw
	13.08.15 jpw

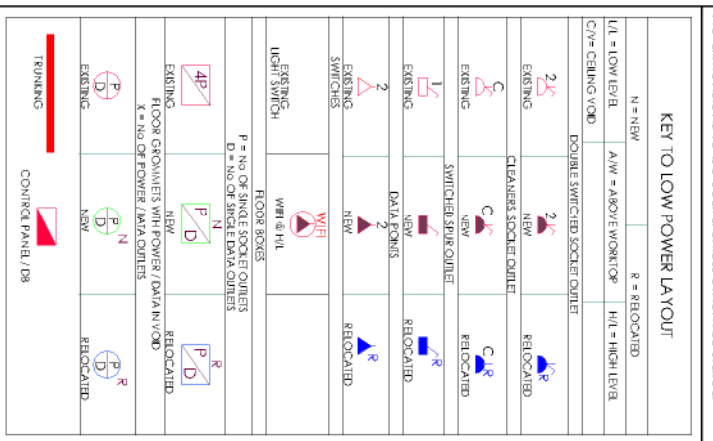

The Workplace
Zebra Court
Greenside Way
Manchester
M24 1JN

T 0161 655 0290
F 0161 655 0291
E info@adtlworkplace.com
W www.adtlworkplace.com

Development
KIM JONES

Design	Drawn By
Infinel	JPW
Scale @A1	1:50

02.10.15

BIRD HALL LANE
STOCKPORT
SK3

C947 1FAFD	B
------------	---

IF AS FITTED DATA LAYOUT