


NOTE:-
ALL DIMENSIONS ARE IN MILLIMETRES UNLESS OTHERWISE SPECIFIED.

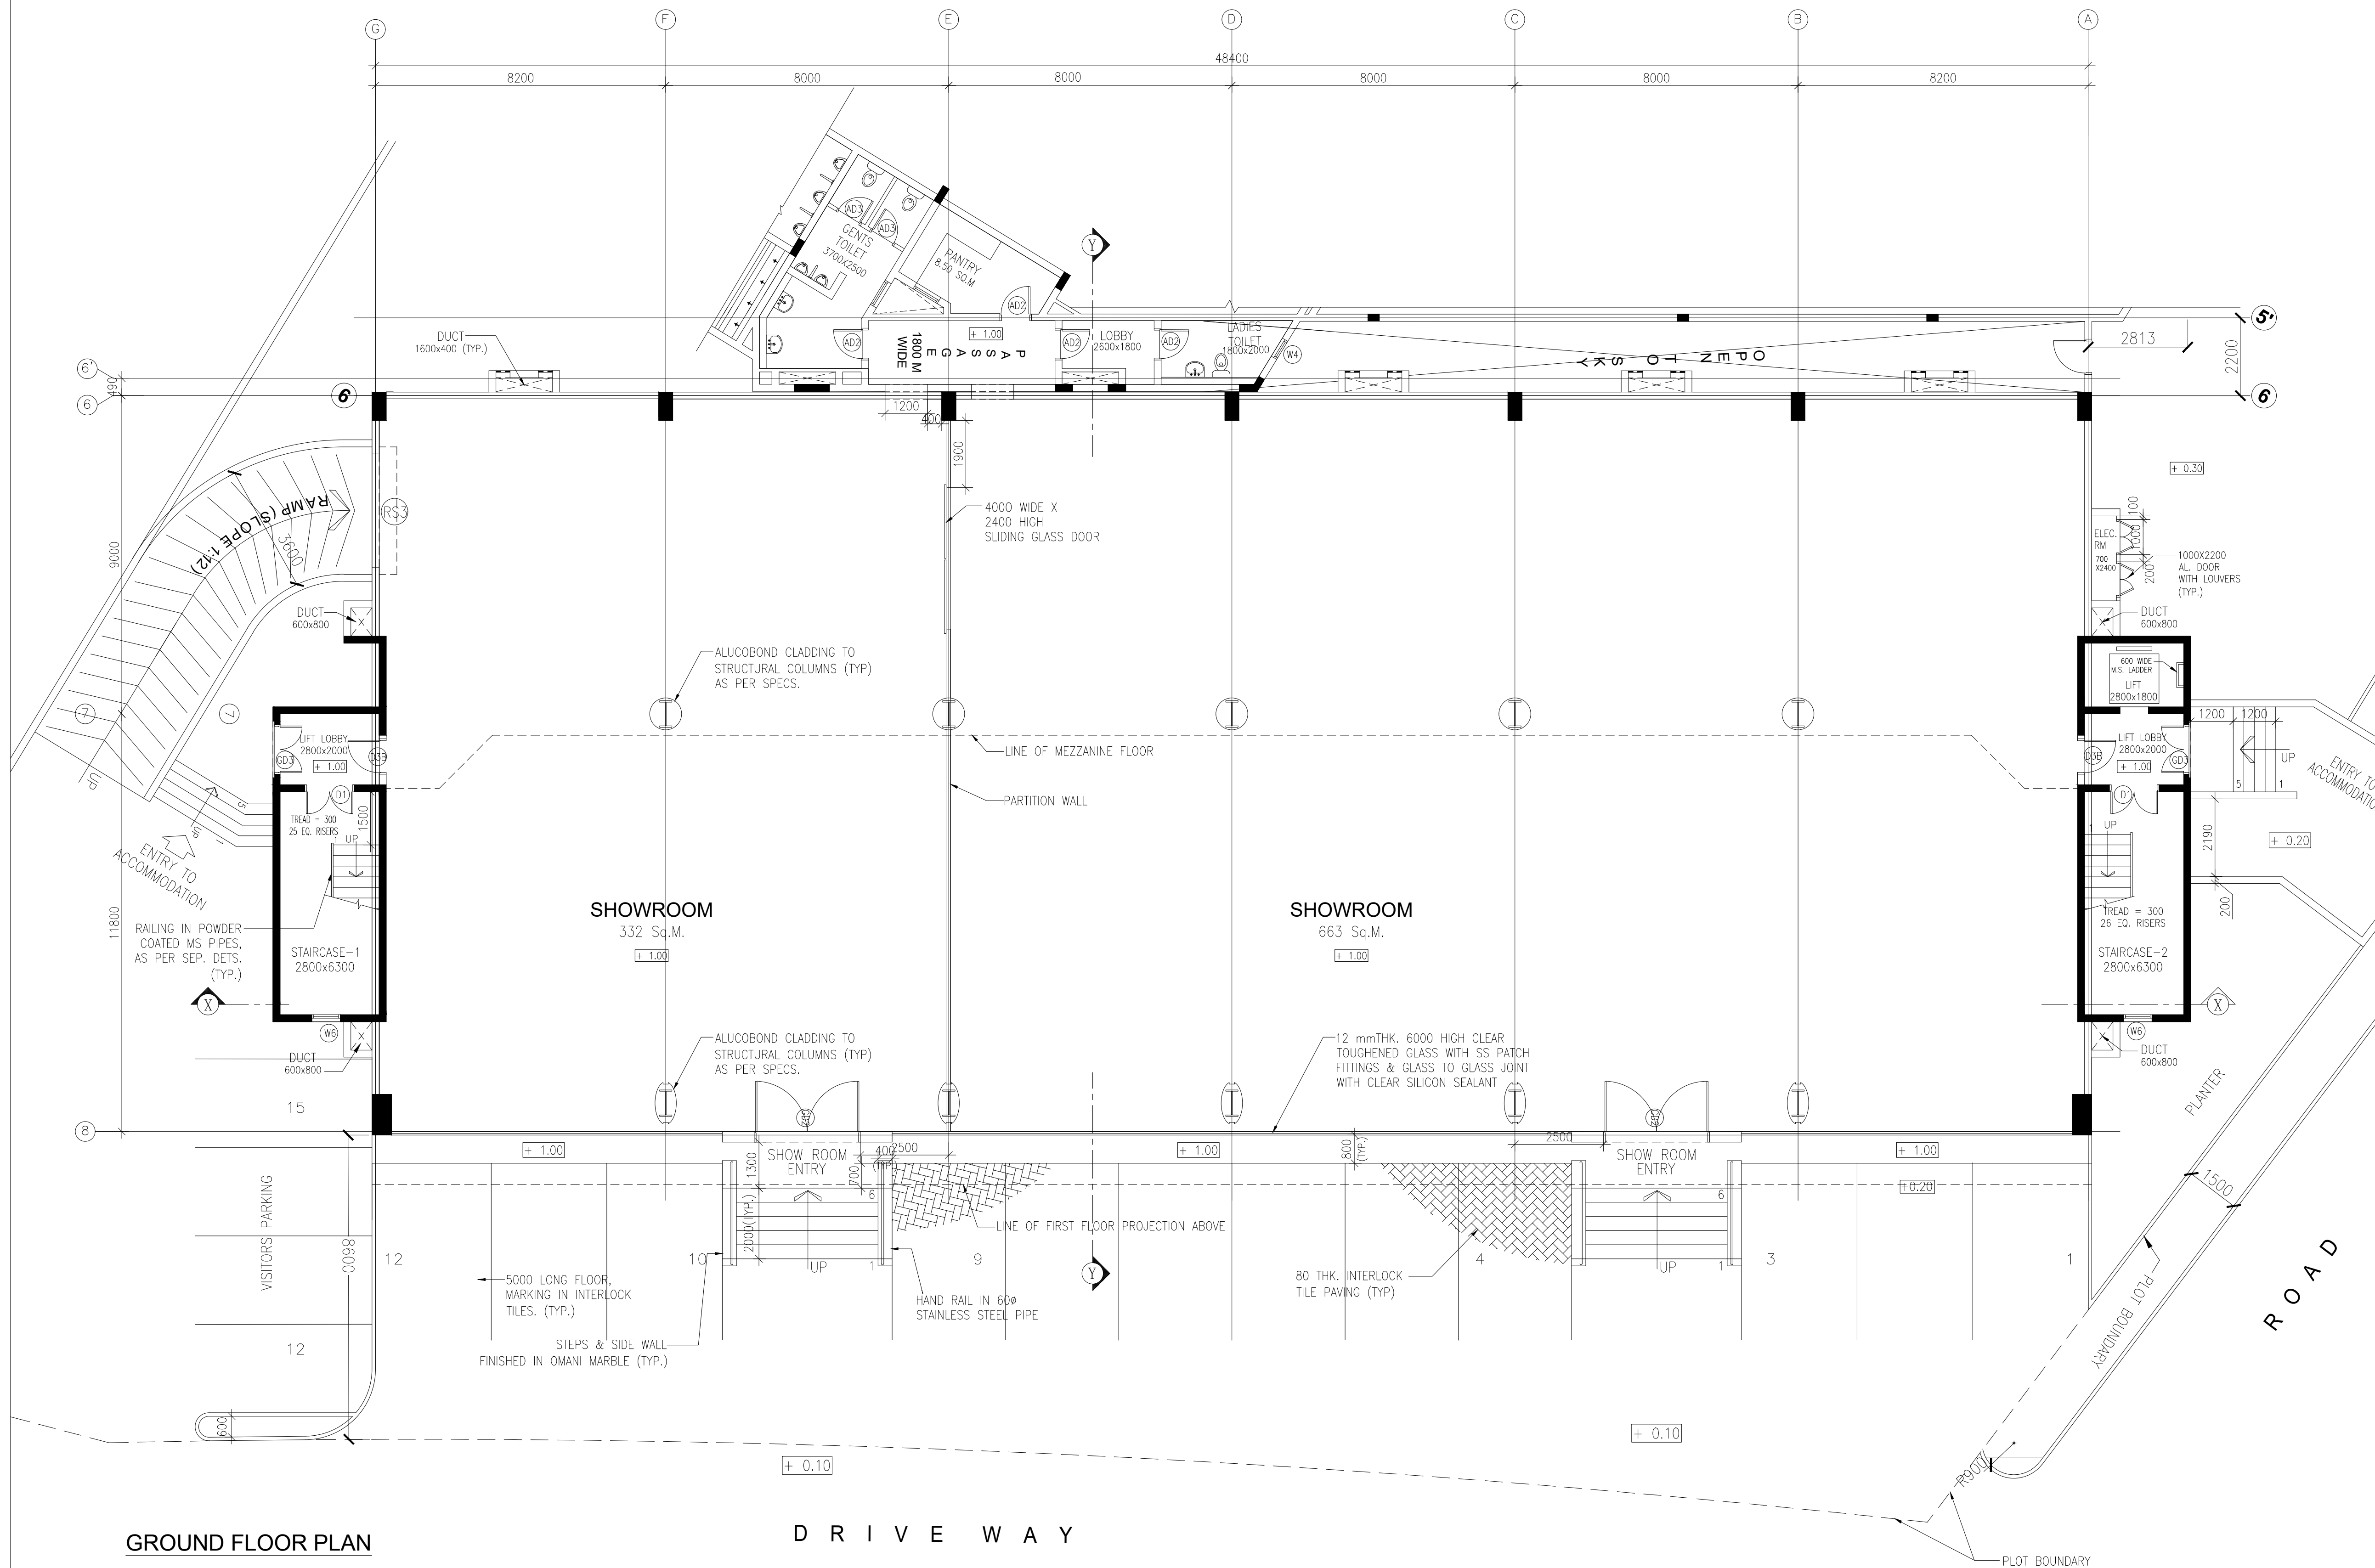

GROUND FLOOR PLAN

D R I V E W A Y

AS BUILT DRAWING

استشارات قادري

KADRI CONSULTANTS
P.O. BOX 1604, JIBROO, POSTAL CODE 114, SULTANATE OF OMAN, TEL:795632 FAX:796091
FLAT NO. 301, BLDG. NO. 701, WAY NO. 2911, AL FARSAN STREET, RUWI

CLIENT	SUHAIL BIN SALEM ABDULLAH BAHWAN AL-MUKHEINY
--------	---

PROJECT	PROPOSED SHOWROOM PARTS STORE / WORKSHOP / ACCOMMODATION
---------	--

TITLE	GROUND FLOOR PLAN (SHOWROOM/ ACCOMMODATION BUILDING)
-------	---

SCALE	DATE	DRAWN	APPROVED	CHECKED	PROJECT NO.
1:100	MAR'04	VINOD	M.B	R.B	P-0303

ALL THE DRAWINGS ARE THE PROPERTY OF KADRI CONSULTANTS L.L.C. AND CANNOT BE USED WITHOUT THEIR WRITTEN PERMISSION. ALL THE PRINTS, SPECIFICATIONS AND THEIR COPY RIGHTS ARE THE PROPERTY OF KADRI CONSULTANTS L.L.C. & SHALL BE RETURNED AFTER THE COMPLETION OF WORK.	DRG.NO. 10.02
CAD DWG No. -	

