

GENERAL KEY	
	DOOR REFERENCE NUMBER
	ROOM REFERENCE NUMBER
	P1 1 NEW 1000mm FULL HEIGHT PARTITION
	P2 2 EXISTING
	NEW GLAZED DOOR



HELLO@DTHREESTUDIO.CO.UK
DTHREESTUDIO.CO.UK
020 7096 9520

NOTES

DTHREE STUDIO DO NOT ACCEPT LIABILITY FOR ANY ERRORS AND OMISSIONS ARISING FROM THE PREPARATION OF BASE BUILD DRAWINGS WHICH ARE DERIVED FROM ORIGINAL MATERIAL PROVIDED BY OTHERS.
ALL DISCREPANCIES ARE TO BE REPORTED TO DTHREE STUDIO.
GRID LINES ARE FOR REFERENCE PURPOSES ONLY. ALL DIMENSIONS TO BE VERIFIED BY CONTRACTOR ON SITE PRIOR TO ANY WORKS COMMENCING. DO NOT SCALE FROM THIS DRAWING.
THIS DOCUMENT IS THE PROPERTY OF DTHREE STUDIO.
COPYRIGHT IS RESERVED BY THEM, AND THE DRAWING IS ISSUED ON THE CONDITION THAT IT IS NOT COPIED, REPRODUCED OR RETAINED BY, NOR DISCLOSED TO ANY UNAUTHORISED PERSON, EITHER WHOLLY OR IN PART, WITHOUT THE CONSENT IN WRITING FROM DTHREE STUDIO.

© DTHREE STUDIO



STATUS

- Approval / Comment
- Building Control
- Contract
- Construction
- As-Built

REVISION DETAIL

REV	DETAIL	BY	DATE
SK01	INITIAL TEST FIT	HM	01/10
P1	REVISED PLAN	HM	26/11
C1	CONSTRUCTION ISSUE	HM	8/12
AB	AS BUILT ISSUE	HM	14/1

CLIENT

BRUNSWICK PROPERTY PARTNERS

PROJECT ADDRESS

114 POWER ROAD
STUDIO 3
CHISWICK
LONDON
W4 5PY

DRAWING TITLE

MEWS UNIT 3.1
GENERAL ARRANGEMENT
AS-BUILT

DWG NO: 34278-3.1-GA



REVISION: AB

SCALE @A1: 1:50 @ A3: 1:100


DATE: 14.1.20

DRAWN BY: HM

CHECKED BY: -

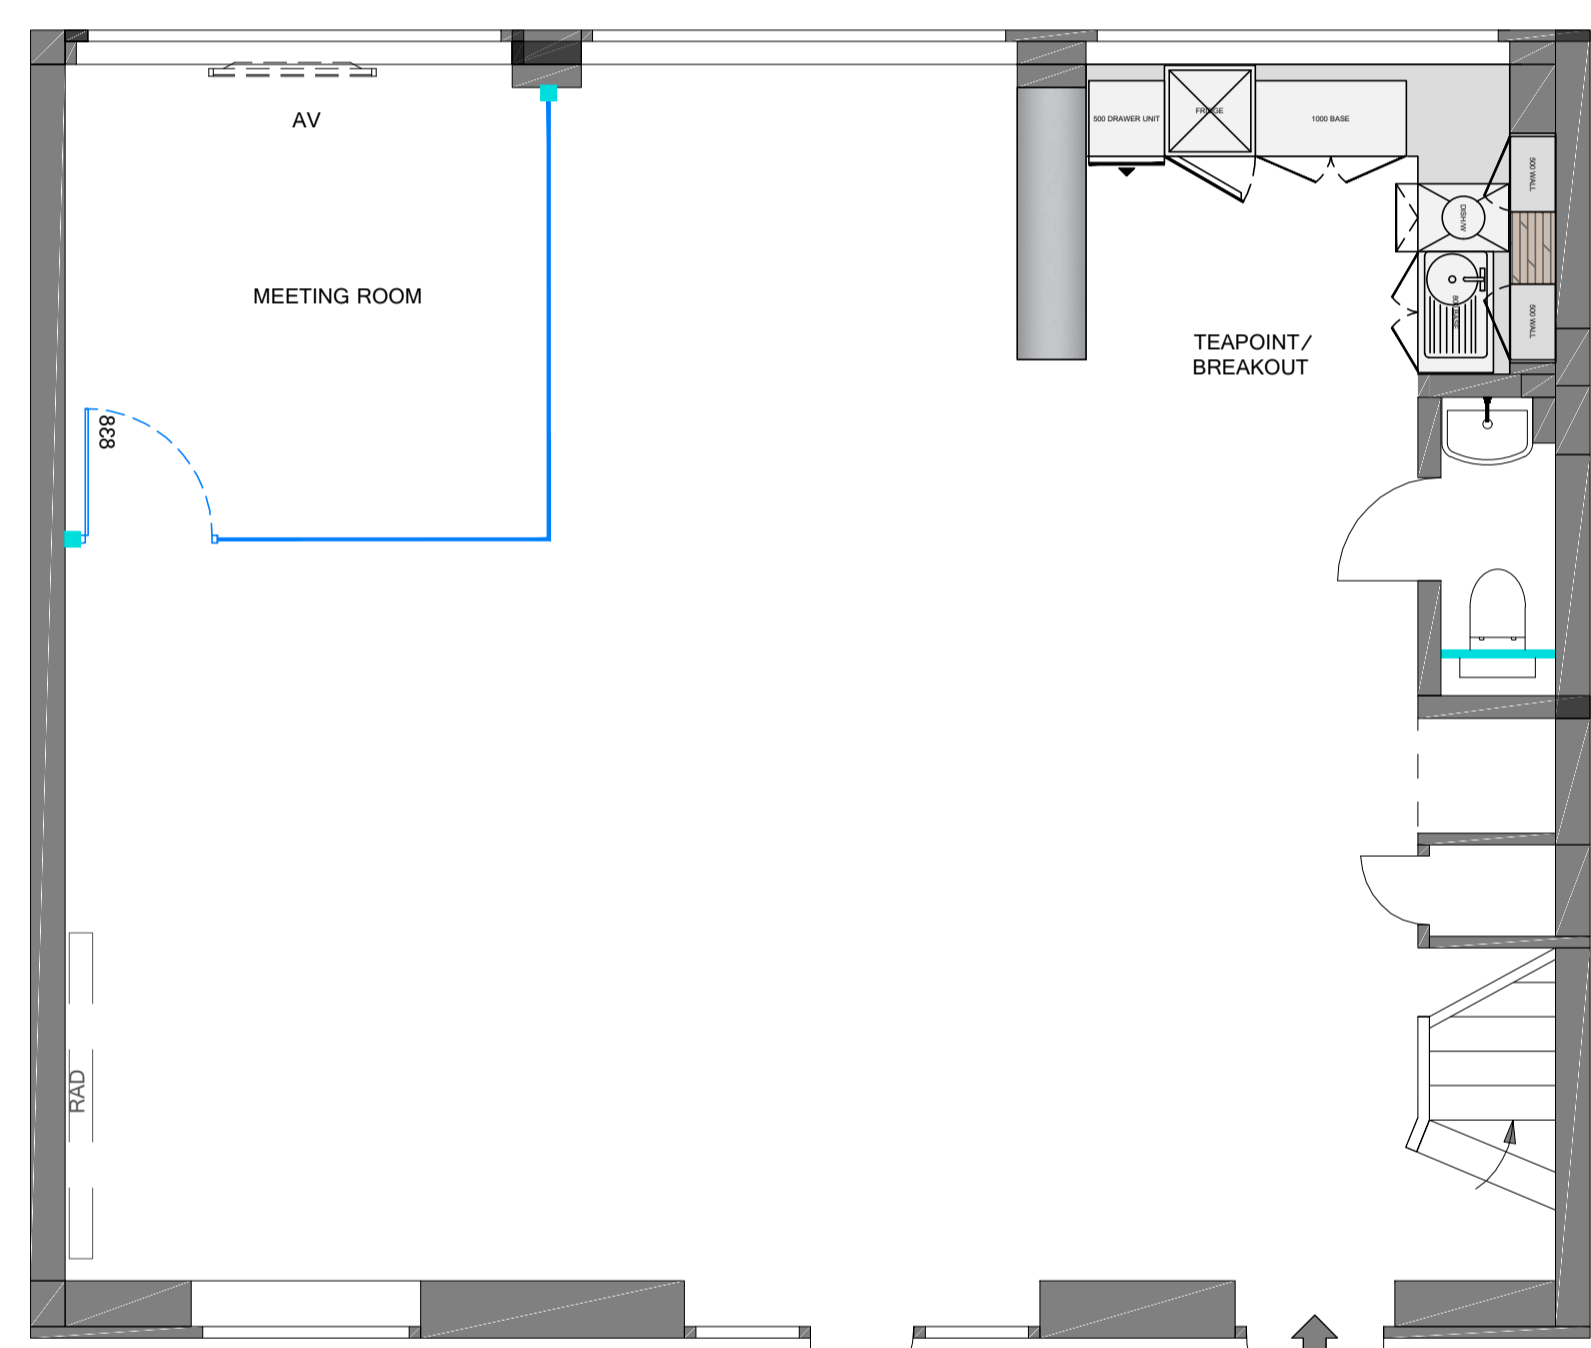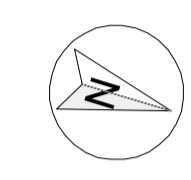

GROUND FLOOR
76.7 SQM / 824.5 SQFT

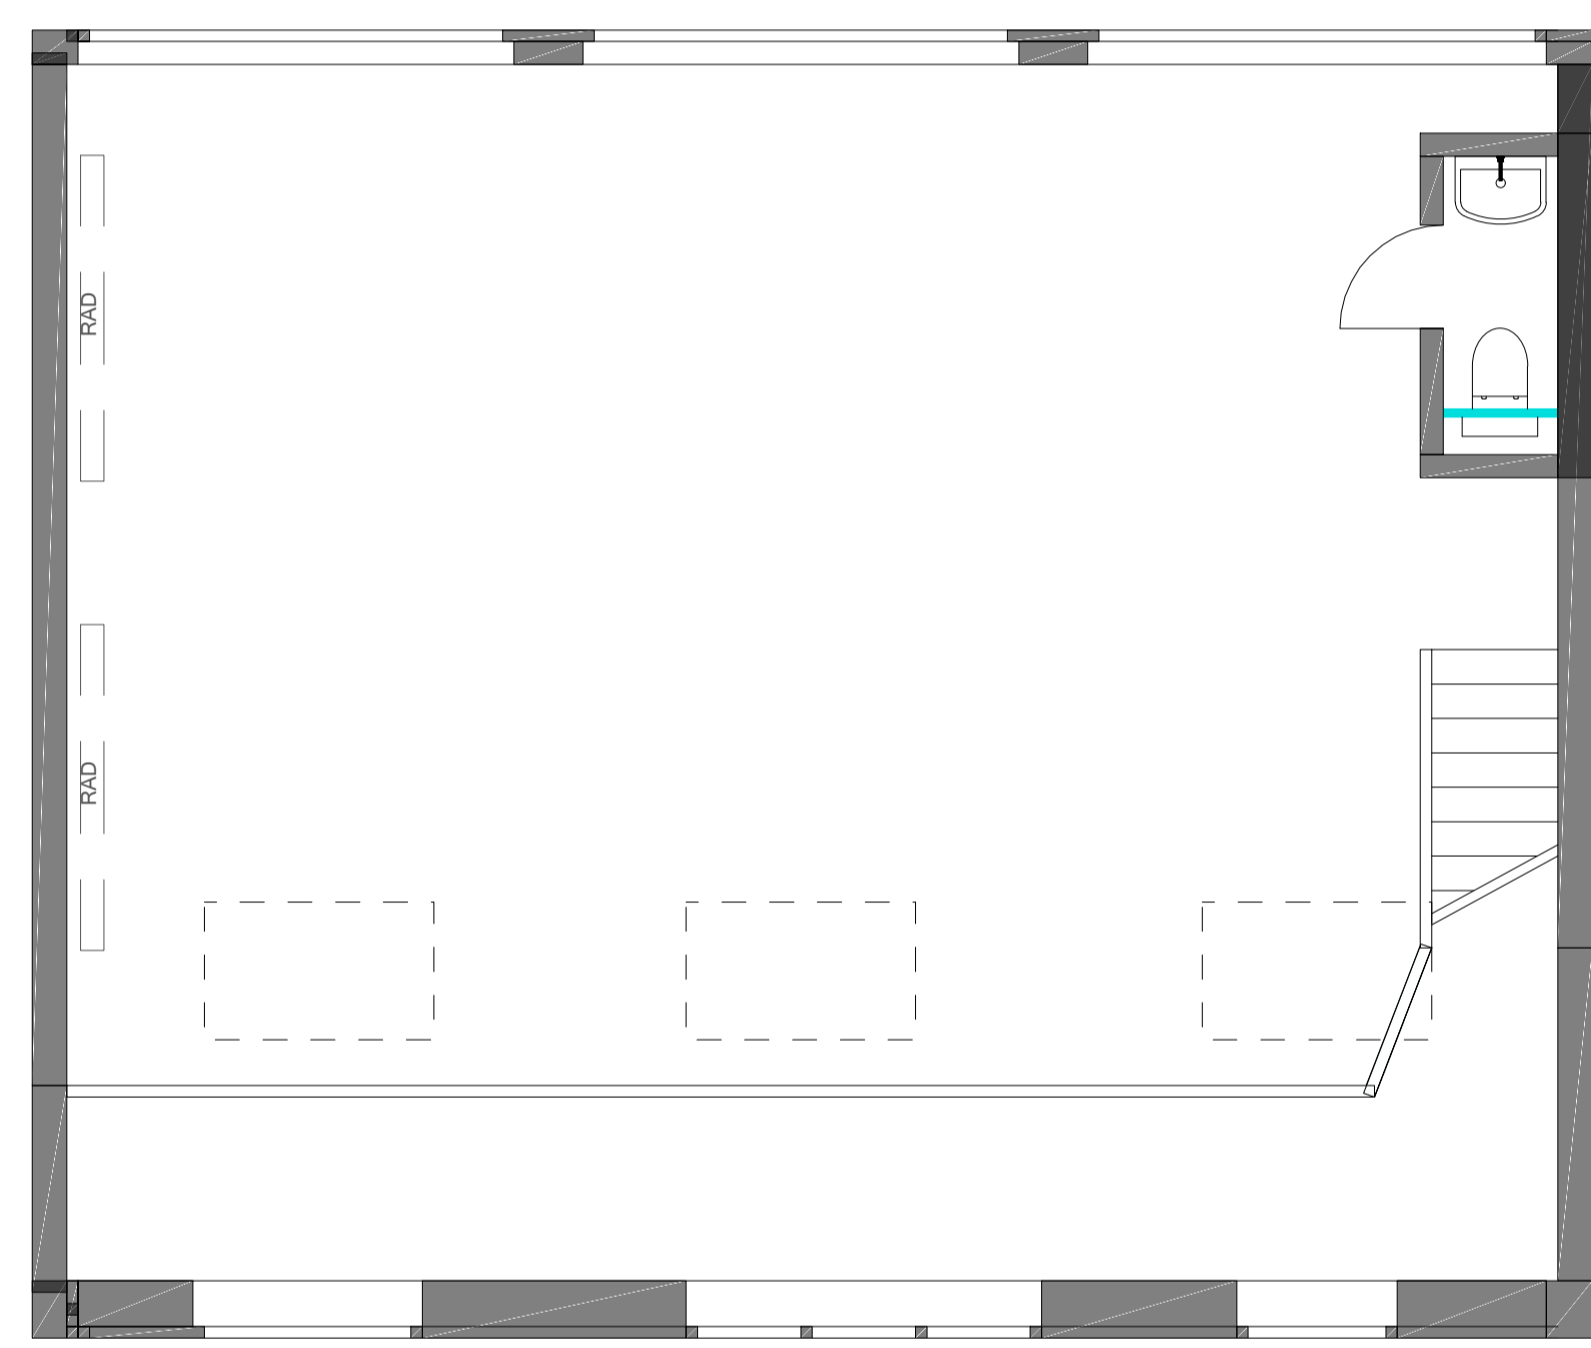

MEZZANINE
61.2SQM / 658.75 SQFT

