


**DO NOT SCALE THIS DRAWING**

Contractors are to check all dimensions prior to commencement on site and notify the architect of any errors, omissions, or discrepancies.

TateHindle Limited retain copyright of this drawing. It may not be copied, altered or reproduced in any way without their written authority.

**AS BUILT**

THE TERM 'AS BUILT' MEANS AS INTENDED FOR CONSTRUCTION. THEY ARE THE LATEST DRAWINGS ISSUED FOR CONSTRUCTION. THE BUILDING HAS NOT BEEN RE-SURVEYED TO CONFIRM IT HAS BEEN CONSTRUCTED EXACTLY AS THE CONSTRUCTION DRAWINGS.

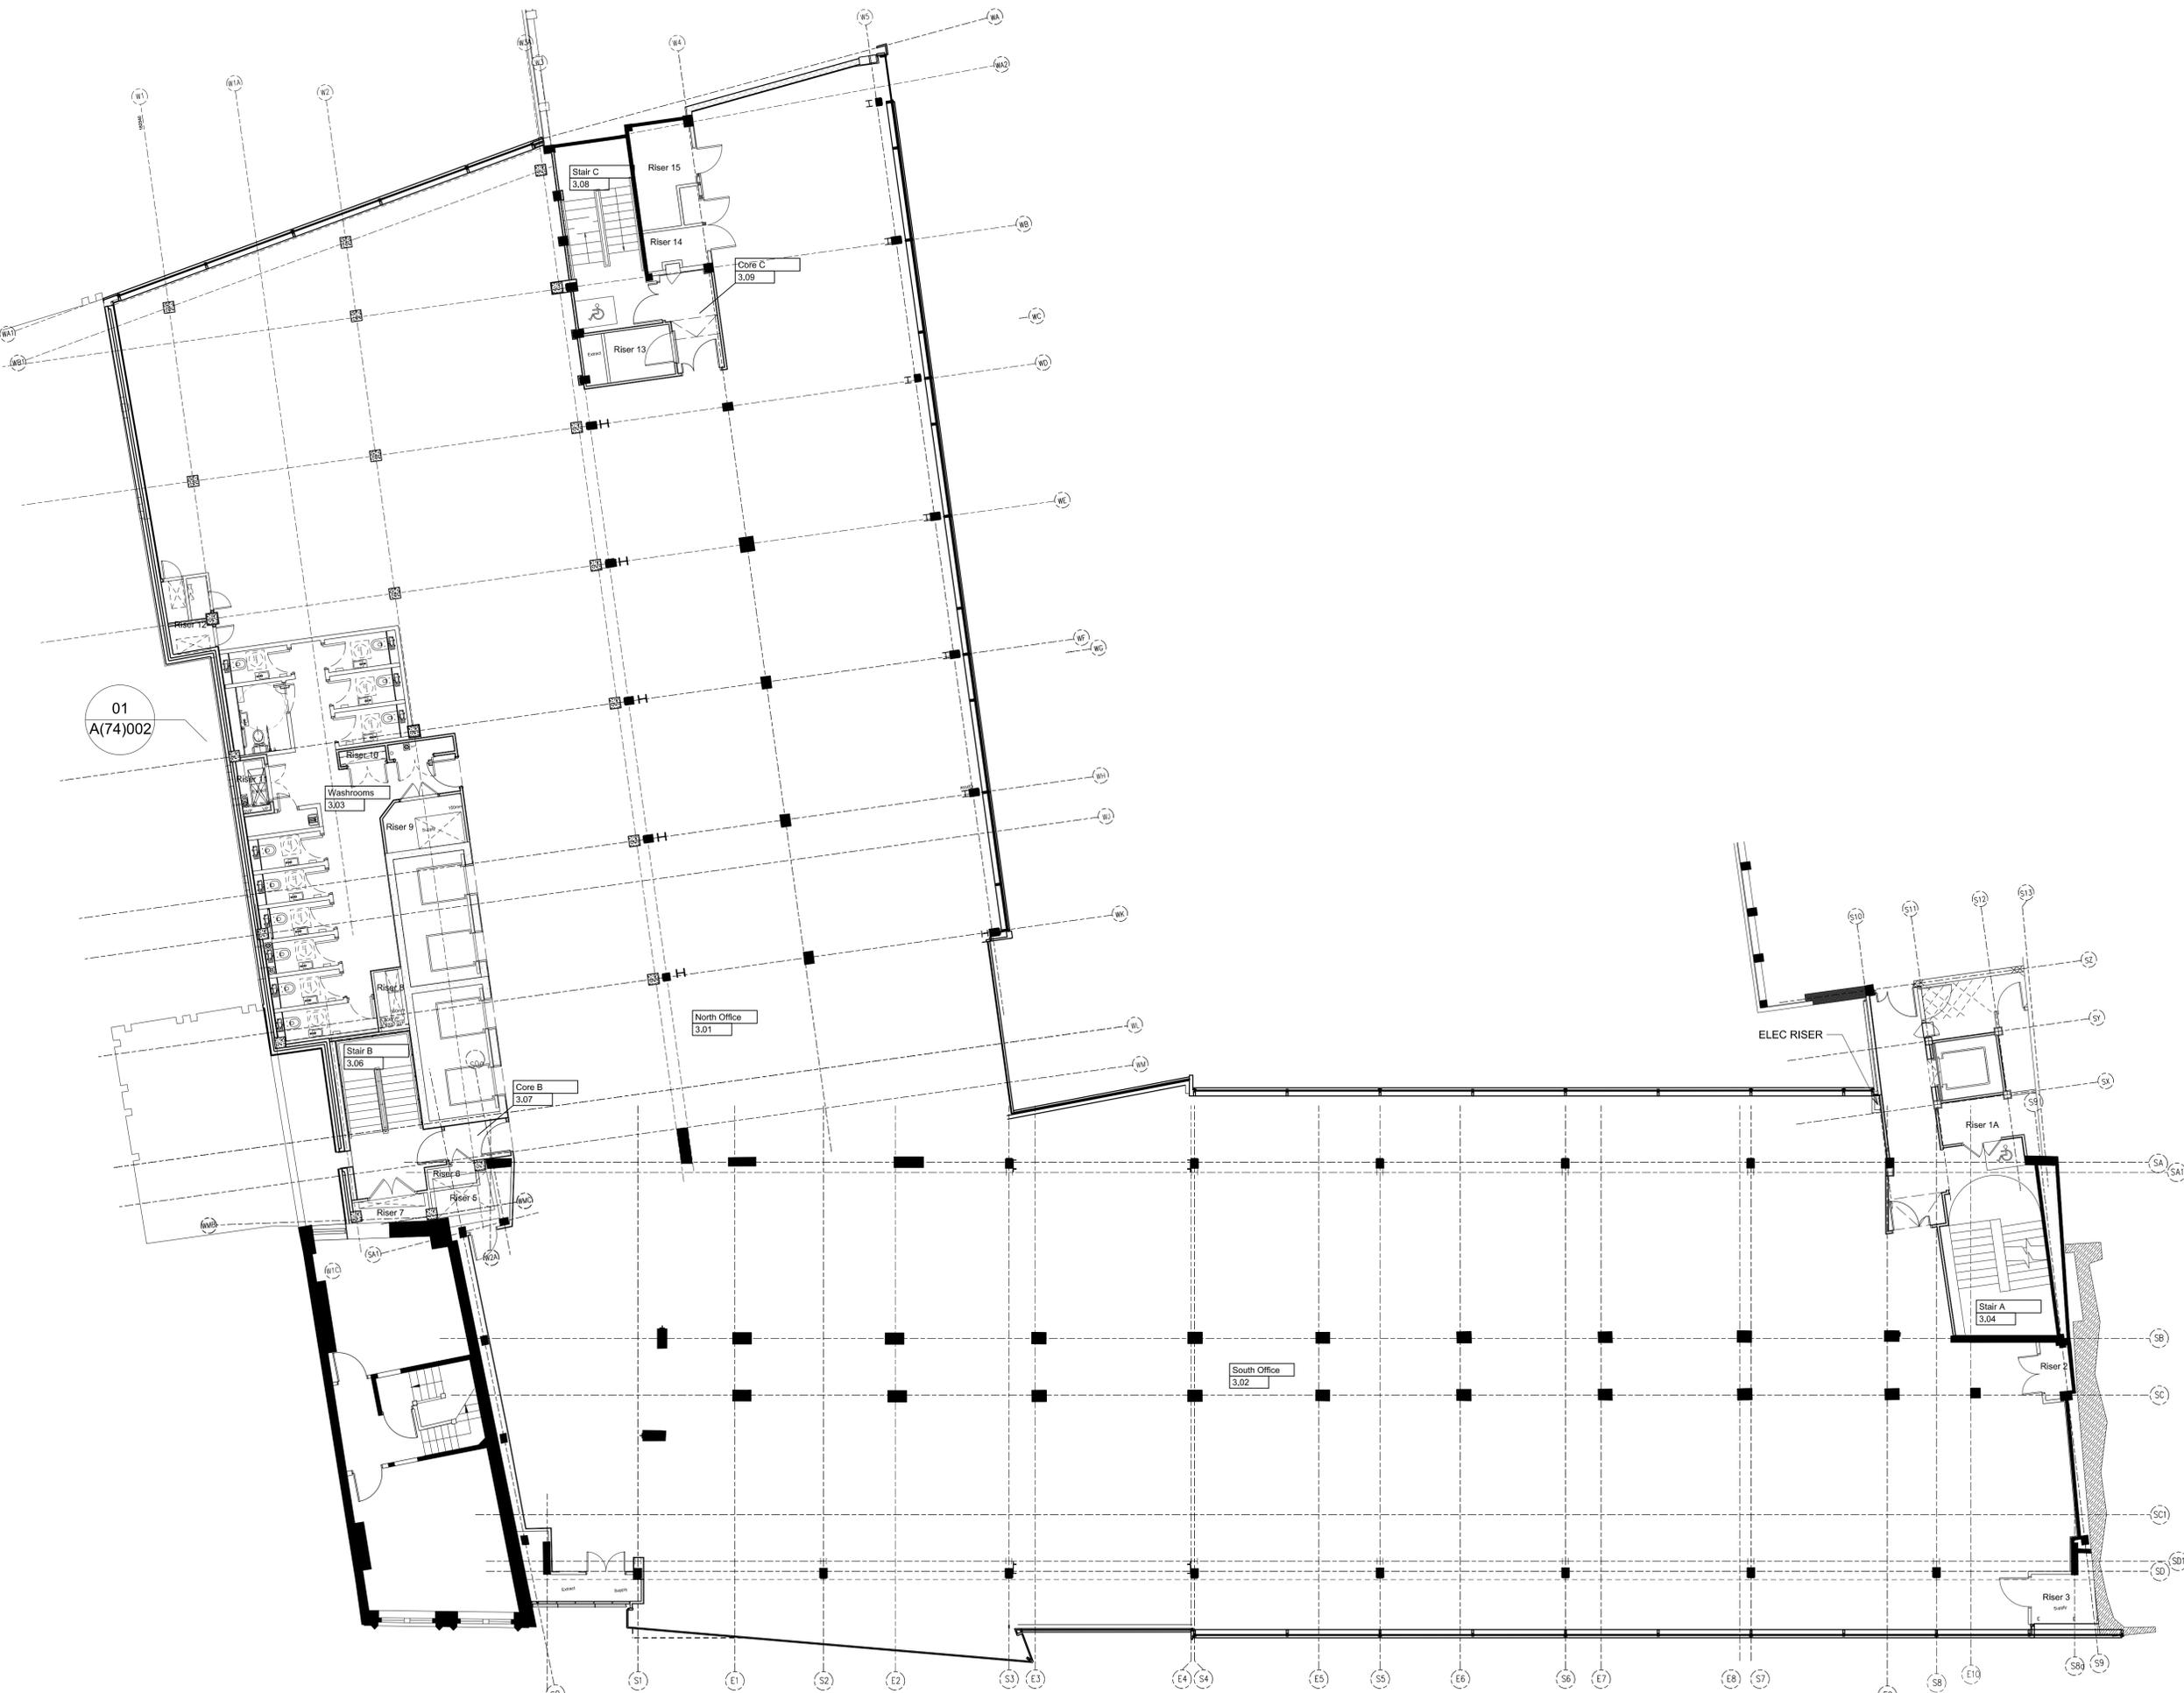

Rev	Description	Date	Drawn	Checked
AB1	AS BUILT	16-10-19	HD	JP

**RECORD DRAWING**

Client  
Success Venture Property Investments Ltd  
c/o Helix Property Advisors Ltd

Project  
110 High Holborn

Drawing  
**THIRD FLOOR PLAN  
AS BUILT**

Scale	Drawn	Date	Checked
1:100@A1	HD	16-10-19	JP

Project no.	Dwg	Revision
15289	A-03-013	AB1

**tatehindle**

TateHindle Limited  
1 Lindsey Street  
Smithfield  
London EC1A 9HP  
T 020 7332 4850  
mail@tatehindle.co.uk  
www.tatehindle.co.uk