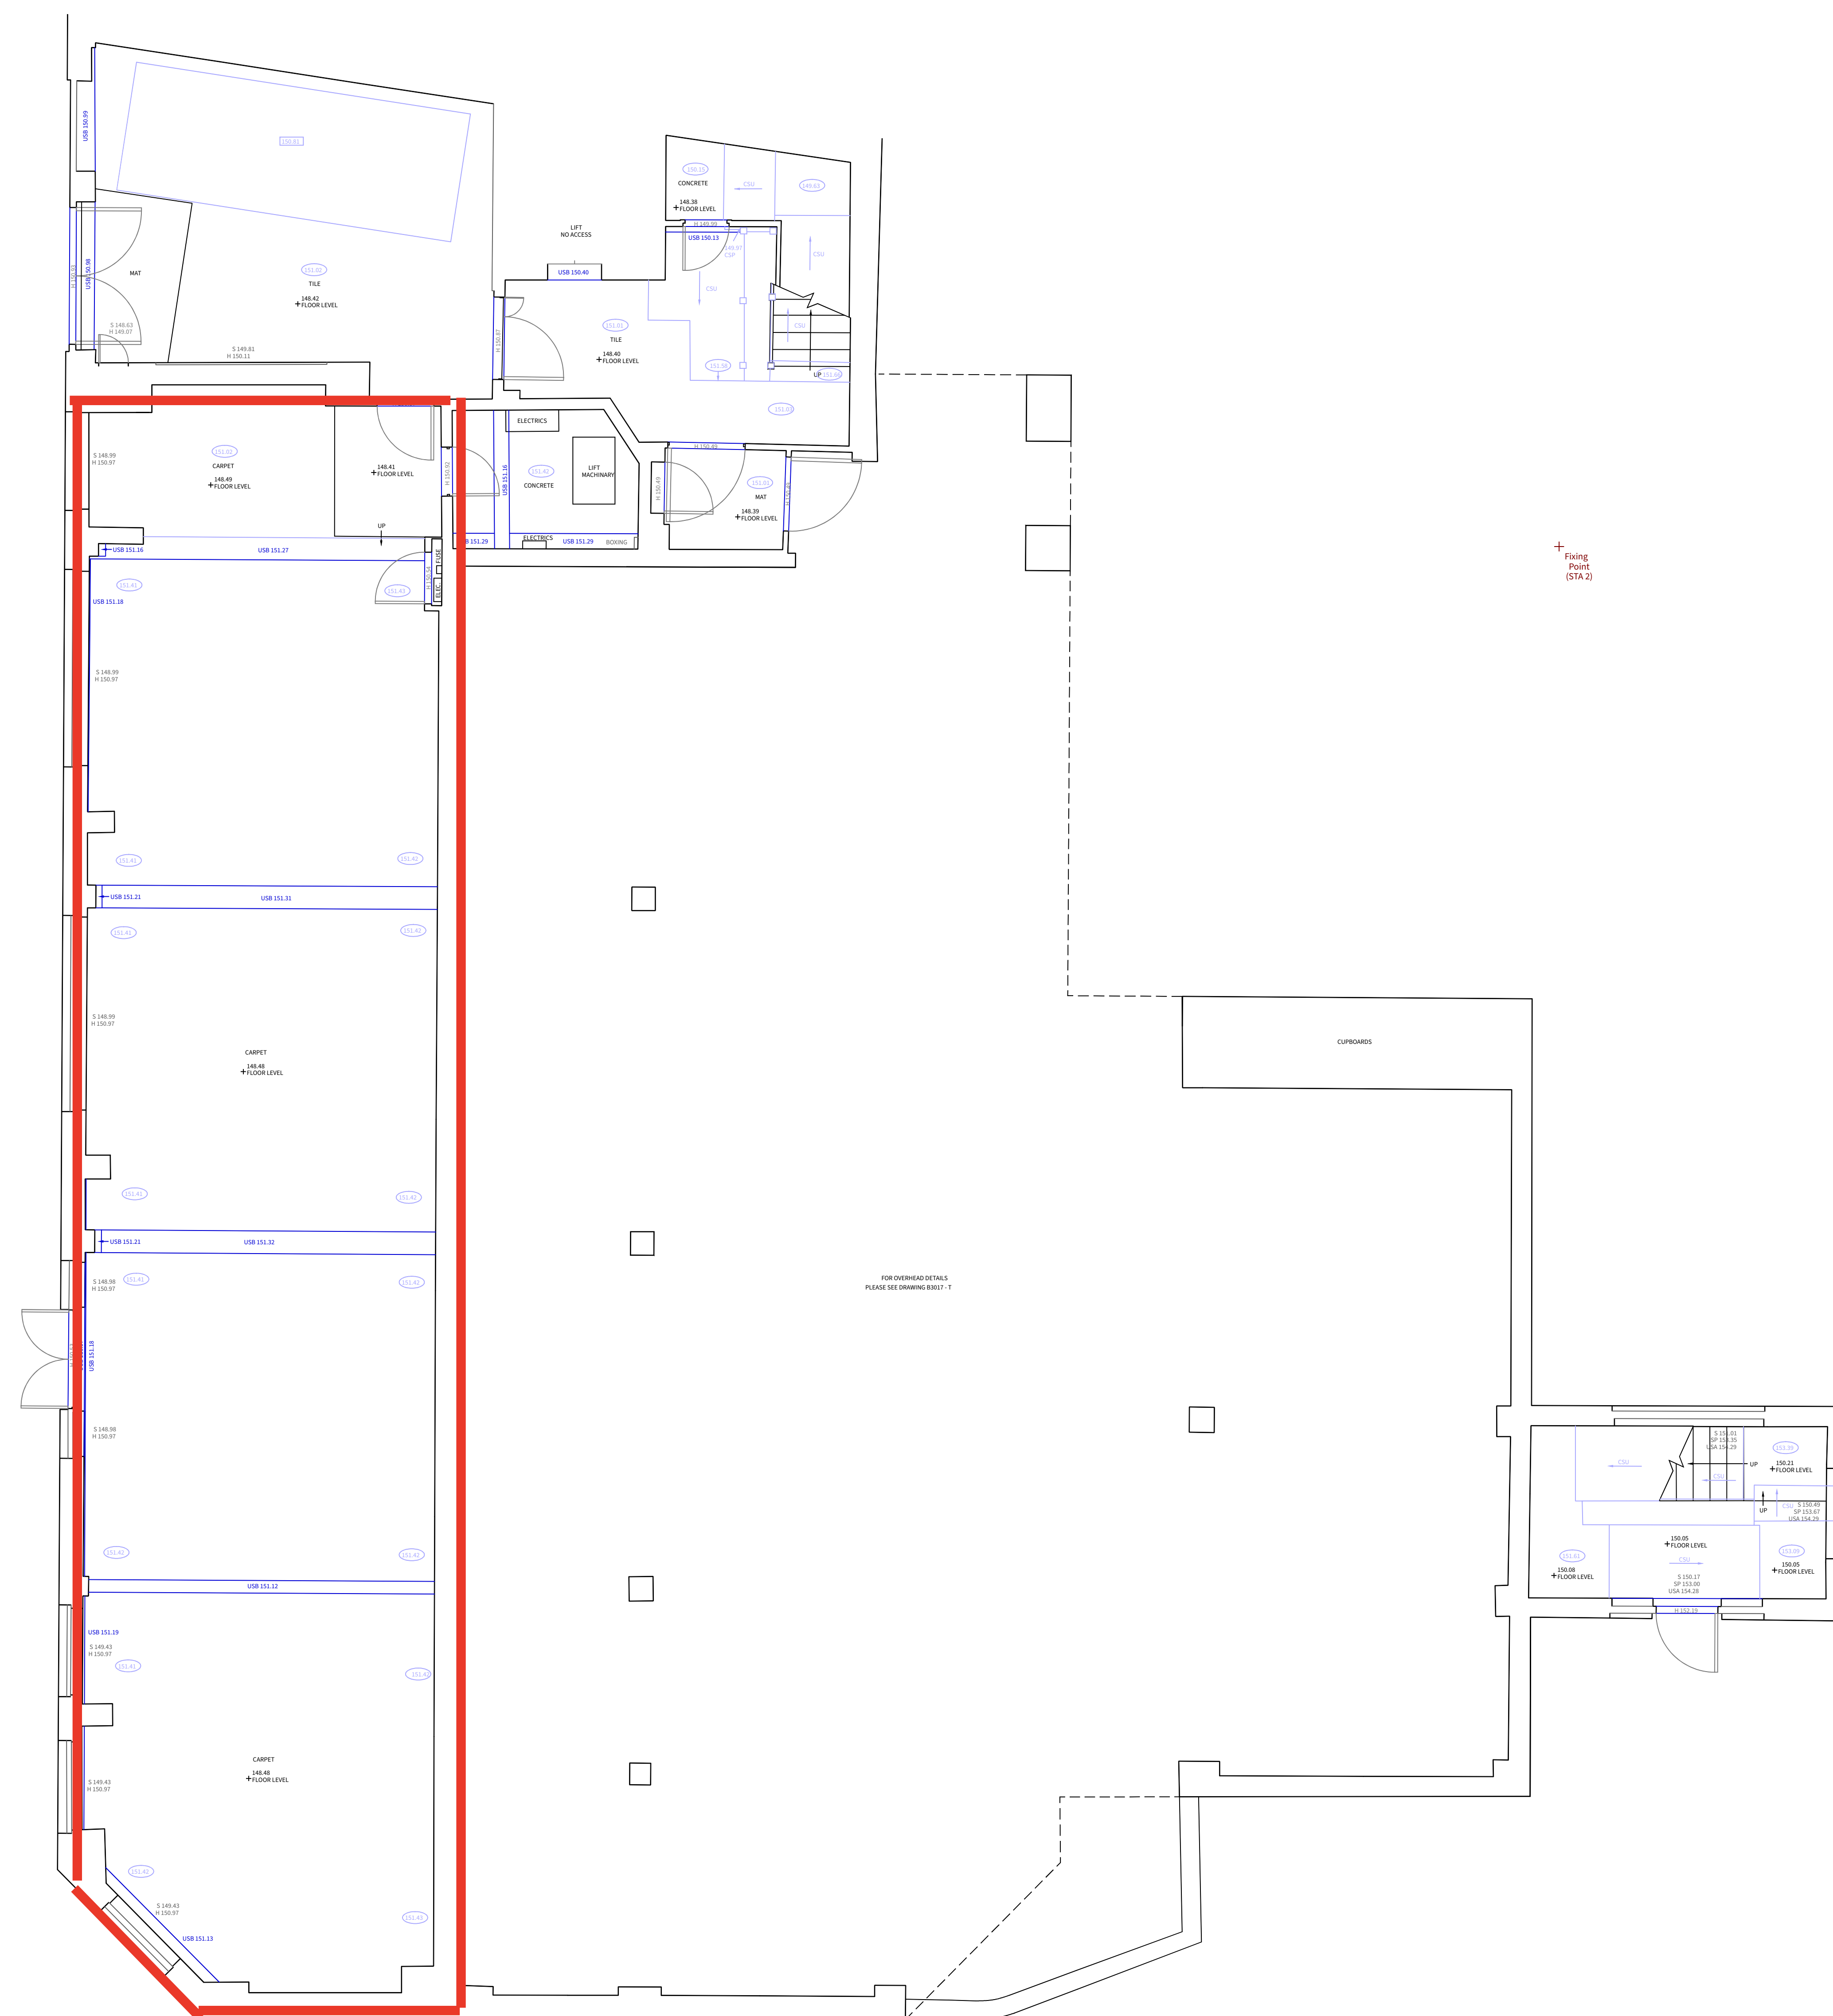


- 1 LEVELS ARE RELATED TO ORDNANCE SURVEY BY GPS OBSERVATION.
- 2 SURVEY HAS BEEN CARRIED OUT TO AN ACCURACY COMMENSURATE WITH A 1:50 SCALE DRAWING.

ABBREVIATION LIST

[illegible]

NO.	DATE	DETAILS

REVISIONS



Tel: 01494 718453
Fax: 01494 717576
e-mail: enquiries@kindsurveyors.com

CLIENT


MERRITTS PROPERTIES LTD
MERRITT HOUSE
HILL AVENUE
AMERSHAM
HP6 5BQ

JOB TITLE

CHALFONT COURT
AMERSHAM

DRAWING TITLE

GROUND FLOOR PLAN

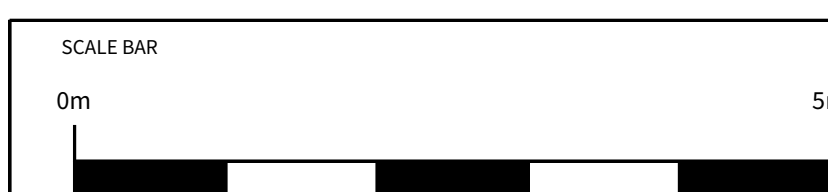

DRAWING No. B3017 - G	DRAWN BY JJF	DATE 27 FEB 2017
SURVEYED BY JJF		SCALE 1:50