


NOTE:
THIS LAYOUT IS PRODUCED ON THE BASIS OF
AN INTERNAL DIMENSION CHECK SURVEY.
ALL DIMENSIONS MUST BE CHECKED AND
VERIFIED ON SITE BY THE MAIN CONTRACTOR
PRIOR TO COMENCEMENT OF ANY WORK OR
SHOP DRAWINGS.

REVISIONS

Rev.	Details.	Date.
	QA 11128 WR11521 - Meeting Rooms QA SR13424 QA SR14564 ACR 24266 ACR31181	17.11.16 23.03.17 15.02.18 21.11.18 2020Jan27 2021Dec23

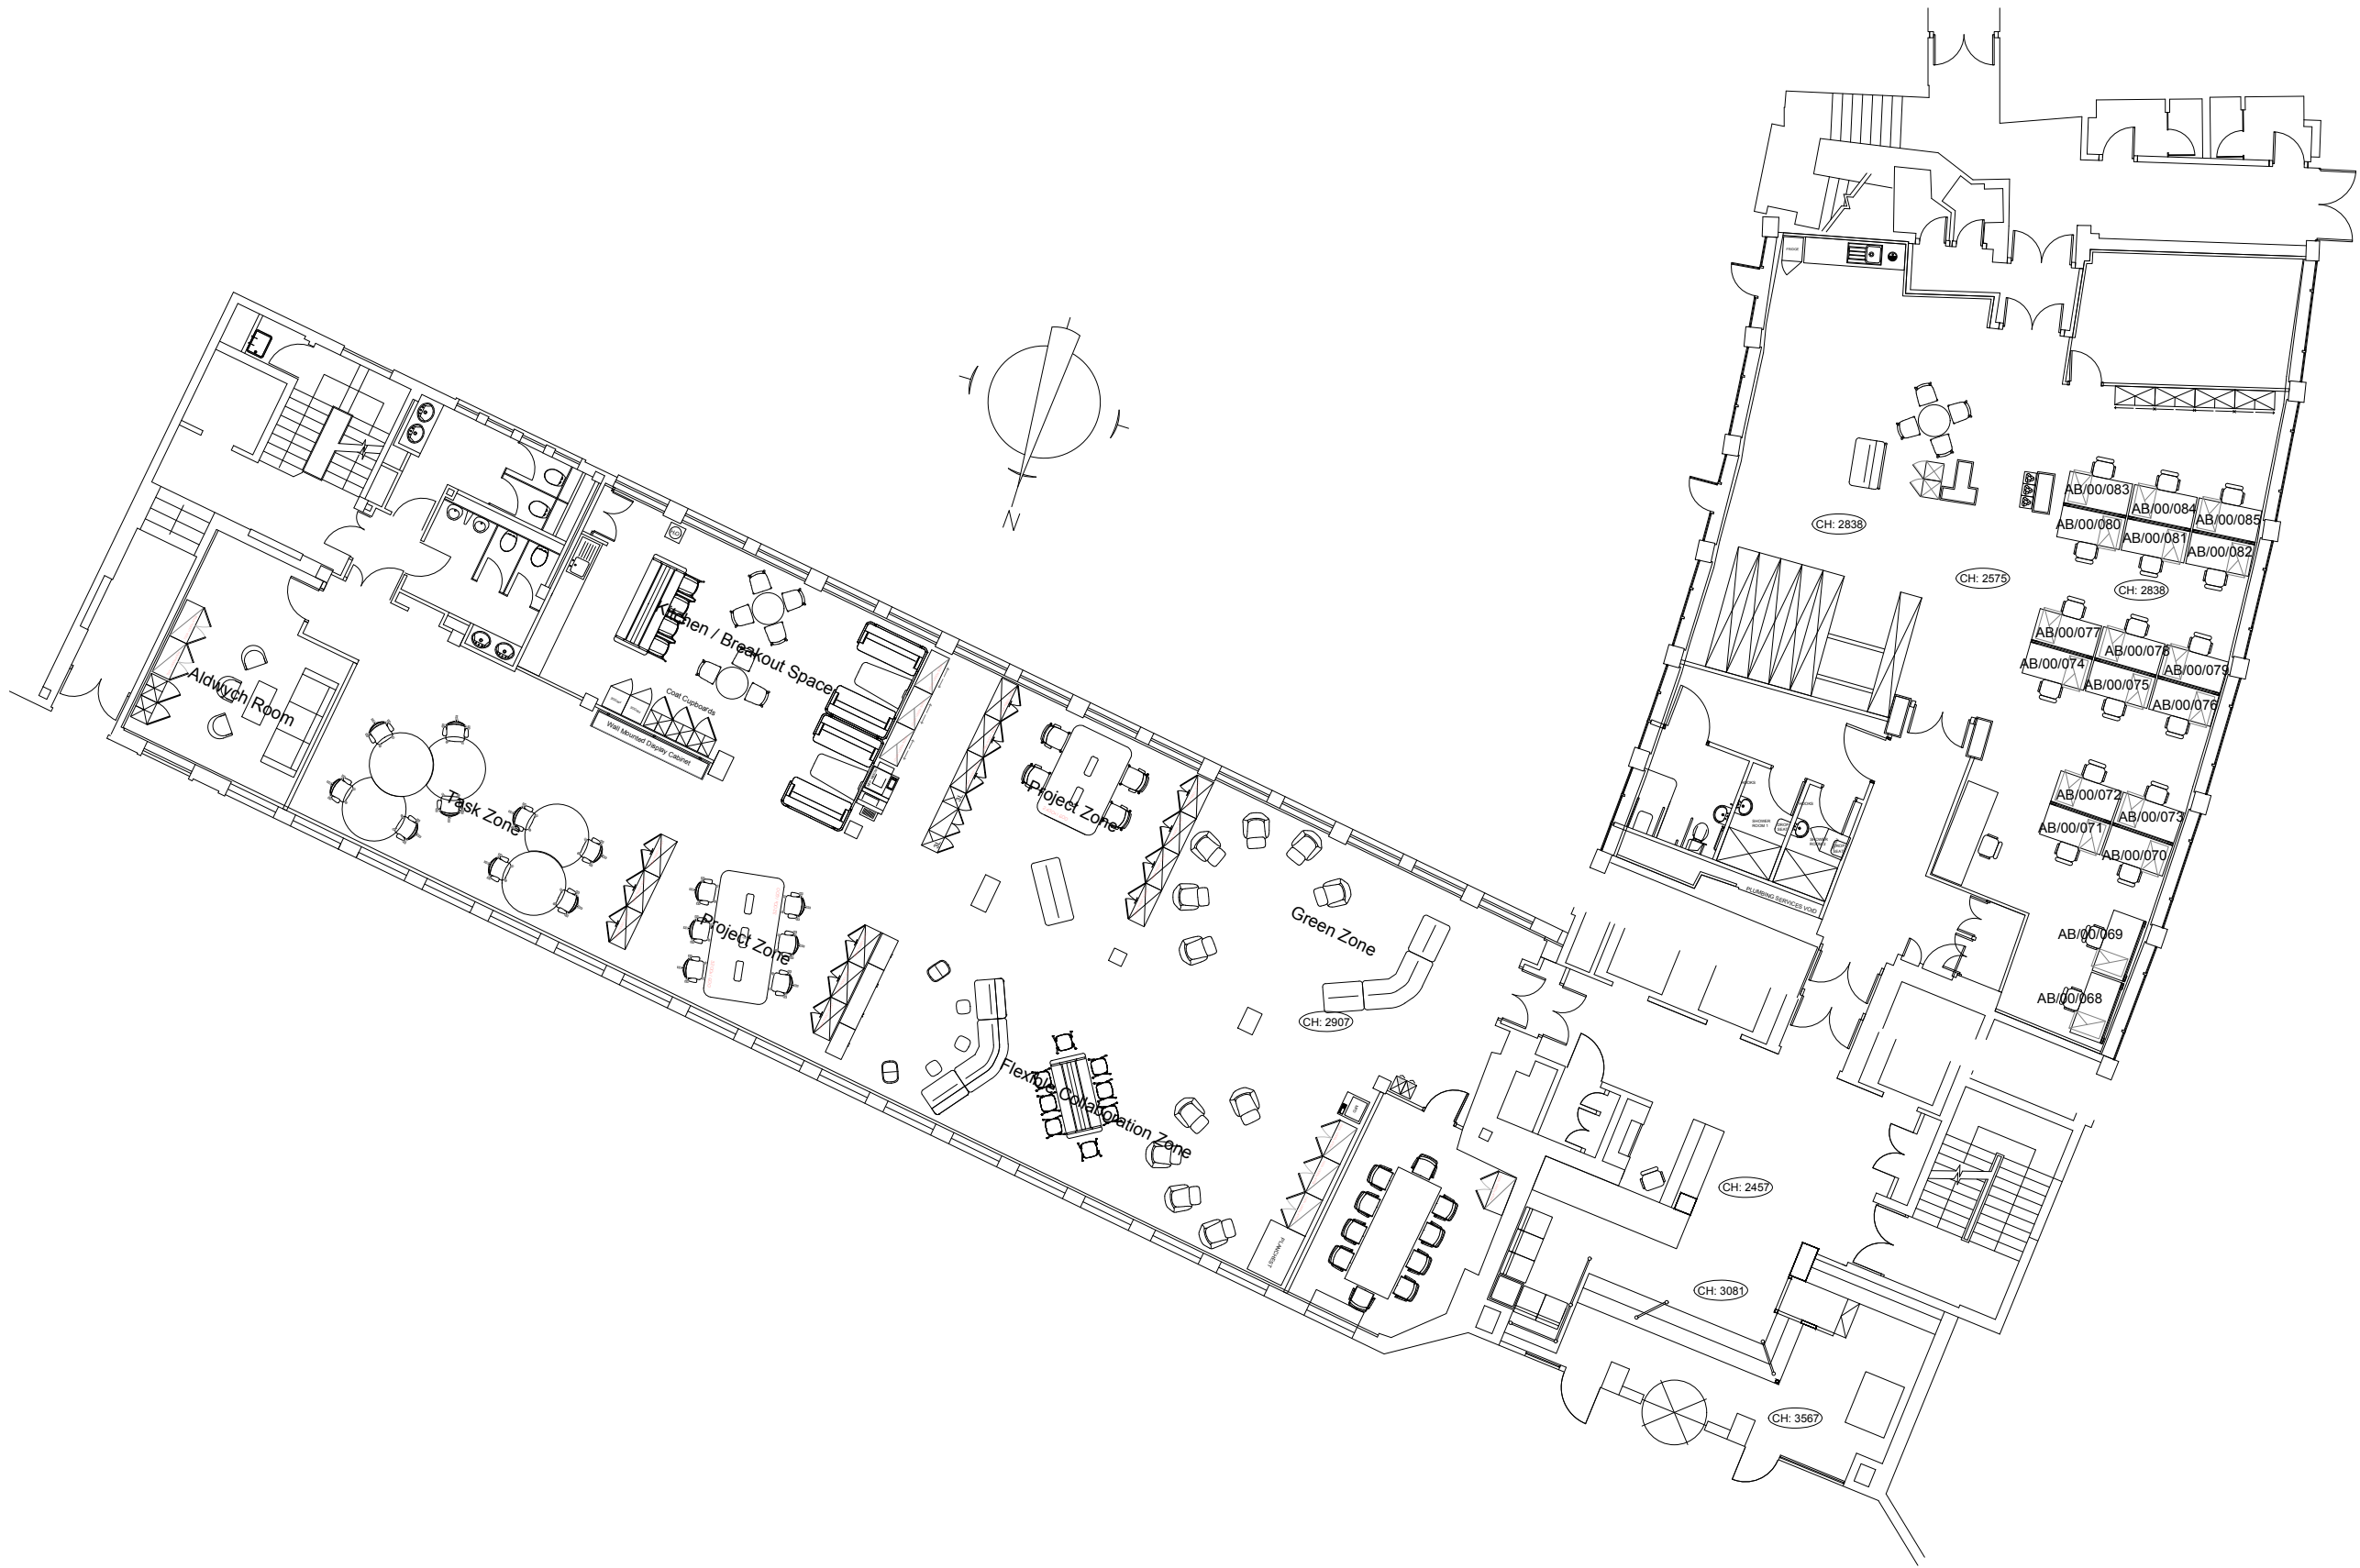

Transport for London

COMMERCIAL DEVELOPMENT
PROJECTS & ACCOMMODATION
PALESTRA
197 BLACKFRIARS ROAD LONDON SE1 8NJ

Drawing Title:
ALBANY HOUSE

Layout:
GROUND FLOOR
AS BUILT LAYOUT

Survey Date:	Surveyed By:	Date of Occu Survey:
Drawn By:	Date:	Scale:
Checked By:		NTS
Approved By:		Date:

Drg. No.	Rev.
AB_00 TRIRIGA	0