



OPTION 2

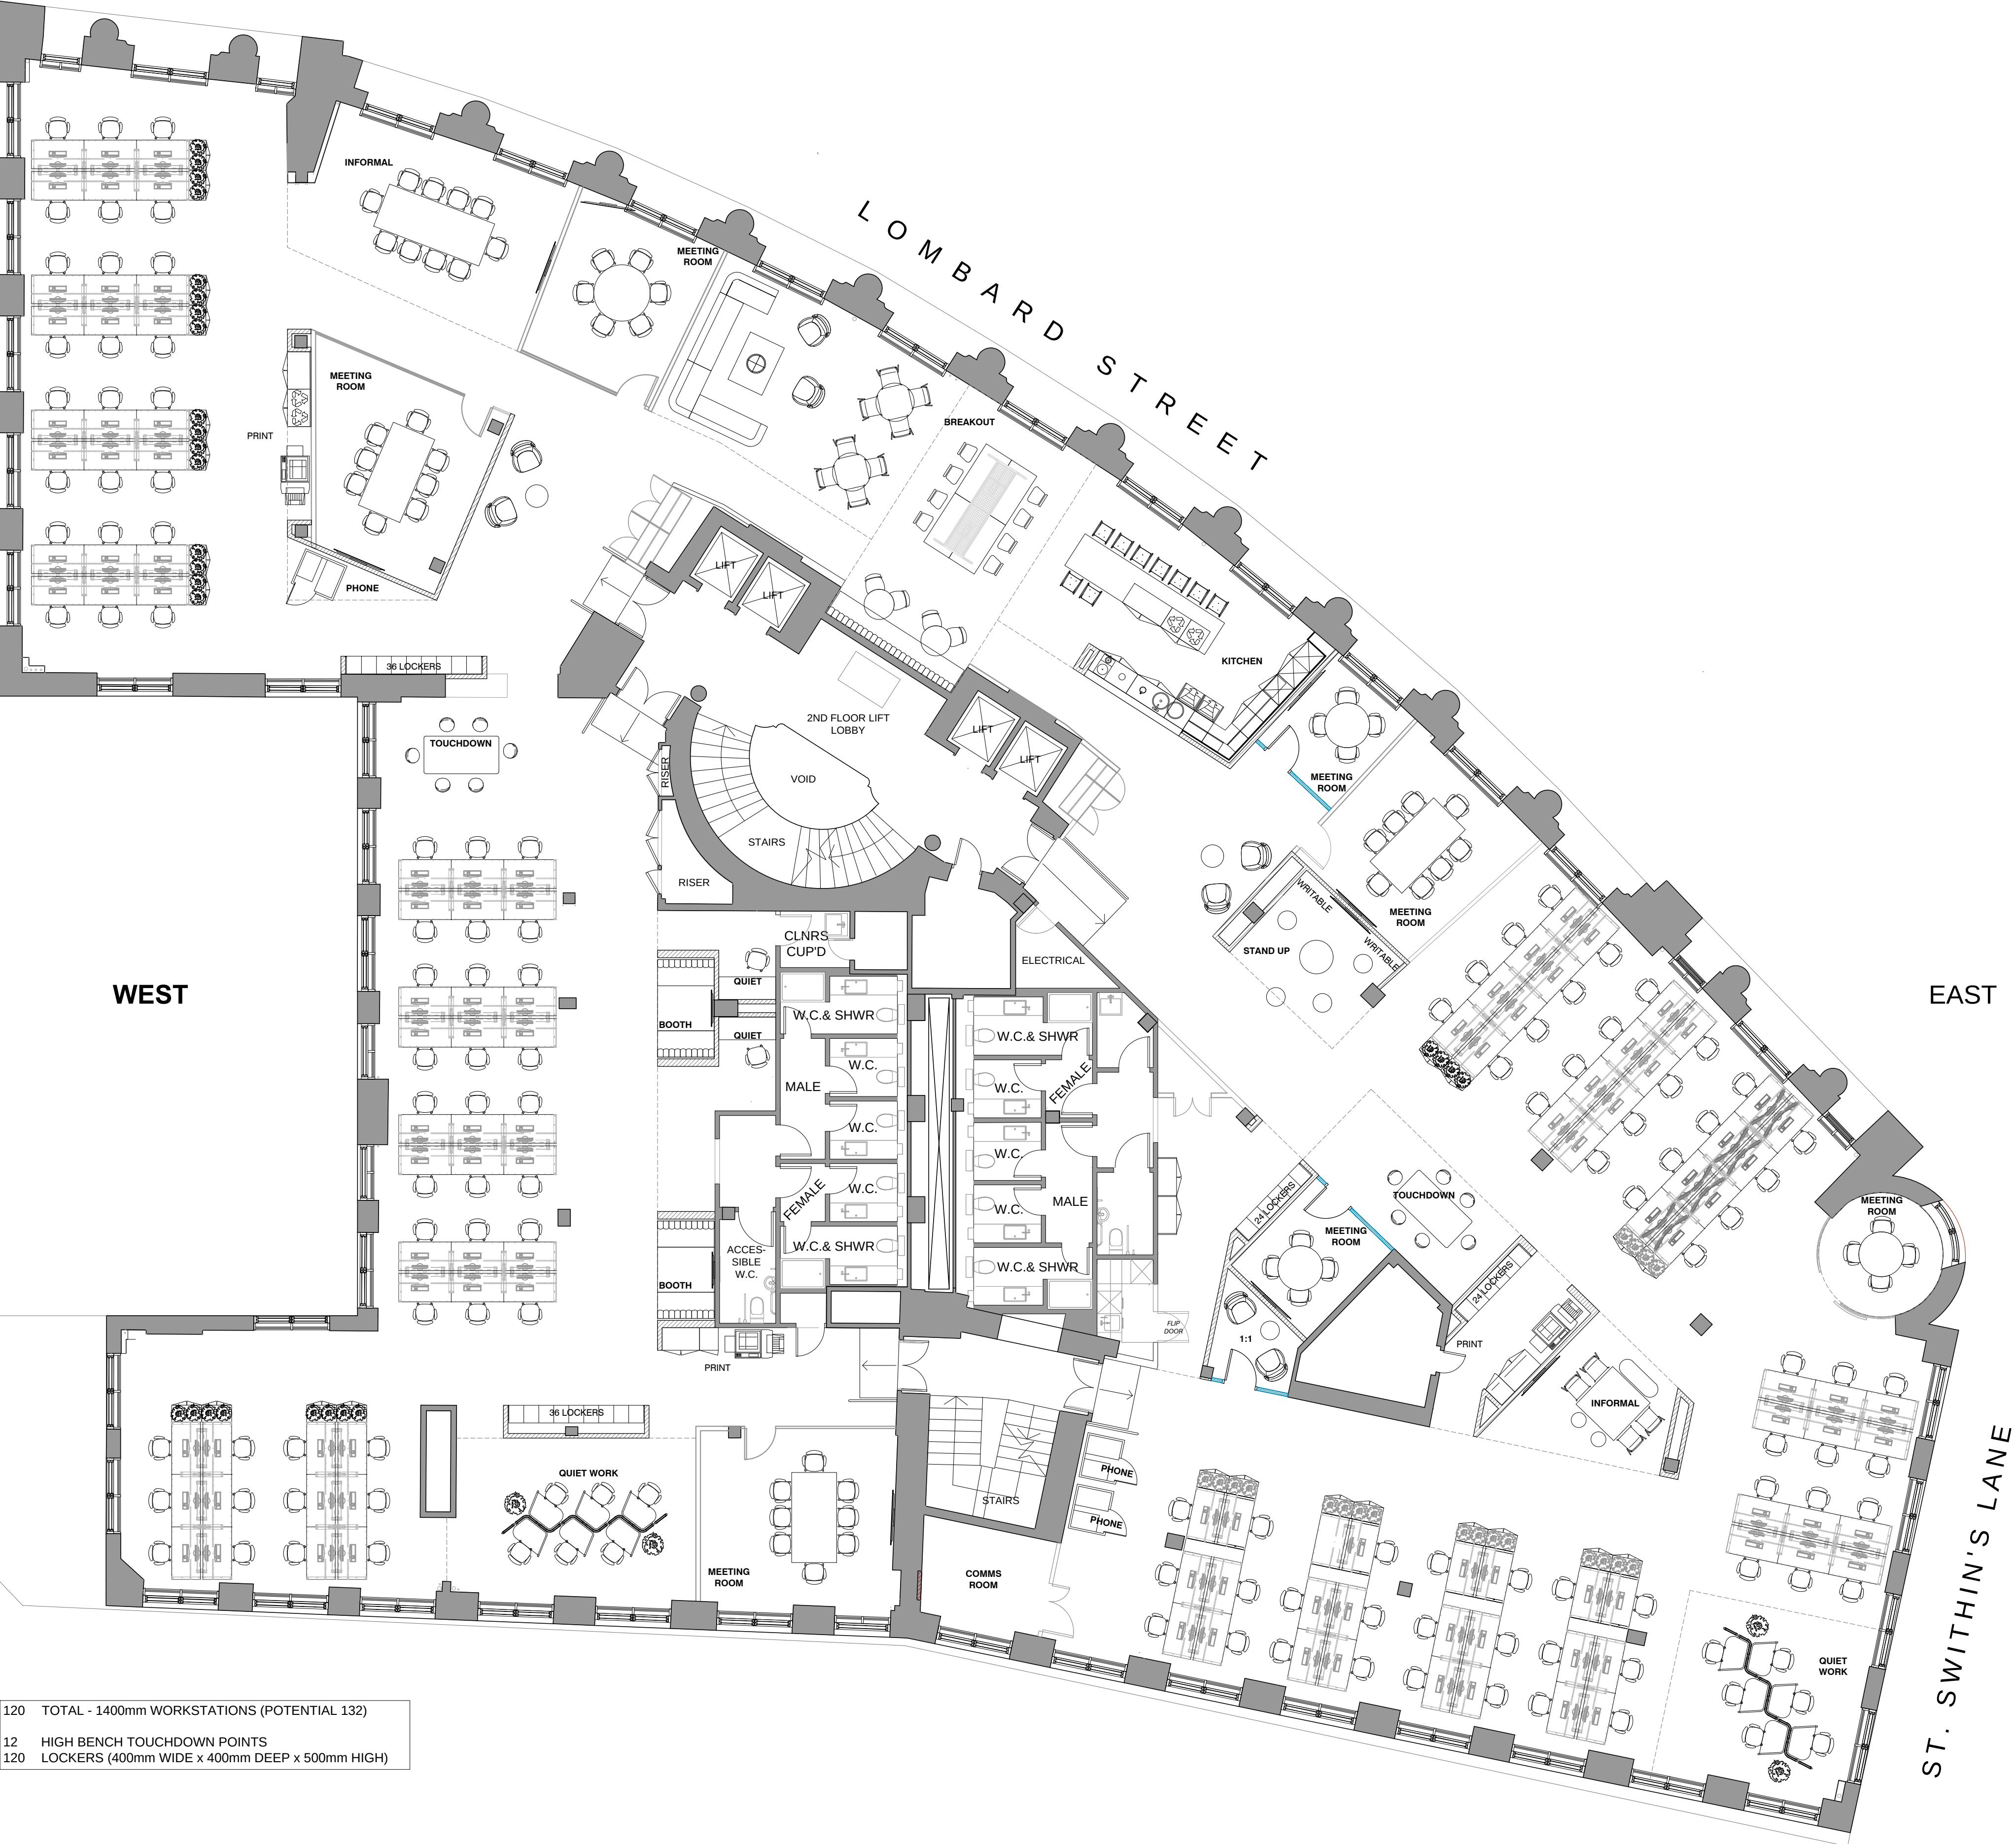

This drawing is protected under Copyright and at no time must any portion of this drawing be reproduced or copied in anyway without the permission of Morgan Lovell.

All dimensions must be checked on site and NOT scaled from this drawing.

SUBJECT TO SITE SURVEY
CHECK SURVEY UNDERTAKEN ONLY
BUILDING PARAMETERS TAKEN FROM DRAWINGS PROVIDED
BUILDING PARAMETERS TAKEN FROM AS BUILT DRAWINGS PROVIDED

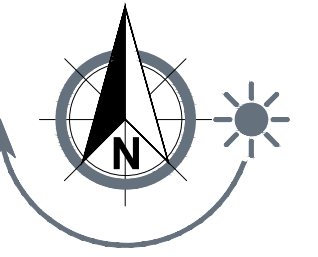

FLOOR SQUARE FOOT = XXXX (XXXsq m)

Square foot shown is based on supplied building shell and includes all columns - subject to site survey

GENERAL CEILING HEIGHT = XXXXmm
BEAM HEIGHT = XXXmm

FLOOR VOID = XXXmm incl floor tile
Clear floor void approx XXXmm

CEILING VOID = XXXXmm incl ceiling tile
Clear ceiling void approx XXXmm

BEAM HEIGHT = XXXXmm

FLOOR TO CILL HEIGHT = XXXXmm

WINDOW HEIGHT = XXXXmm

AB	AS BUILT - FINAL ISSUE	SI	TK	27.09.21
Rev/Revision		By	Ckd	Date

AS BUILT

Morgan Lovell

16 Noel Street London W1F 8DA
T: 0207 734 4466 F: 0207 734 2968 E: contact@morganlovell.com
W: http://www.morganlovell.com

Client:
CANADA LIFE

Project:
3RD FLOOR
1-6 LOMBARD STREET
LONDON
EC3V 9JU

Title:
2ND FLOOR
PROPOSED GENERAL ARRANGEMENT

Scale	Date	Technical Designer	Lead Designer
1:100 @ A1	FEB. 2021	TK	TP

Drawing Number	Project No.	Floor	Drawing No.	Rev
	ML4071	02	100	AB

2ND FLOOR - PROPOSED GENERAL ARRANGEMENT - OPTION 2

