


DO NOT SCALE THIS DRAWING

Contractors are to check all dimensions prior to commencement on site and notify the architect of any errors, omissions, or discrepancies.

TateHindle Limited retain copyright of this drawing. It may not be copied, altered or reproduced in any way without their written authority.

AS BUILT

THE TERM 'AS BUILT' MEANS AS INTENDED FOR CONSTRUCTION. THEY ARE THE LATEST DRAWINGS ISSUED FOR CONSTRUCTION. THE BUILDING HAS NOT BEEN RE-SURVEYED TO CONFIRM IT HAS BEEN CONSTRUCTED EXACTLY AS THE CONSTRUCTION DRAWINGS.

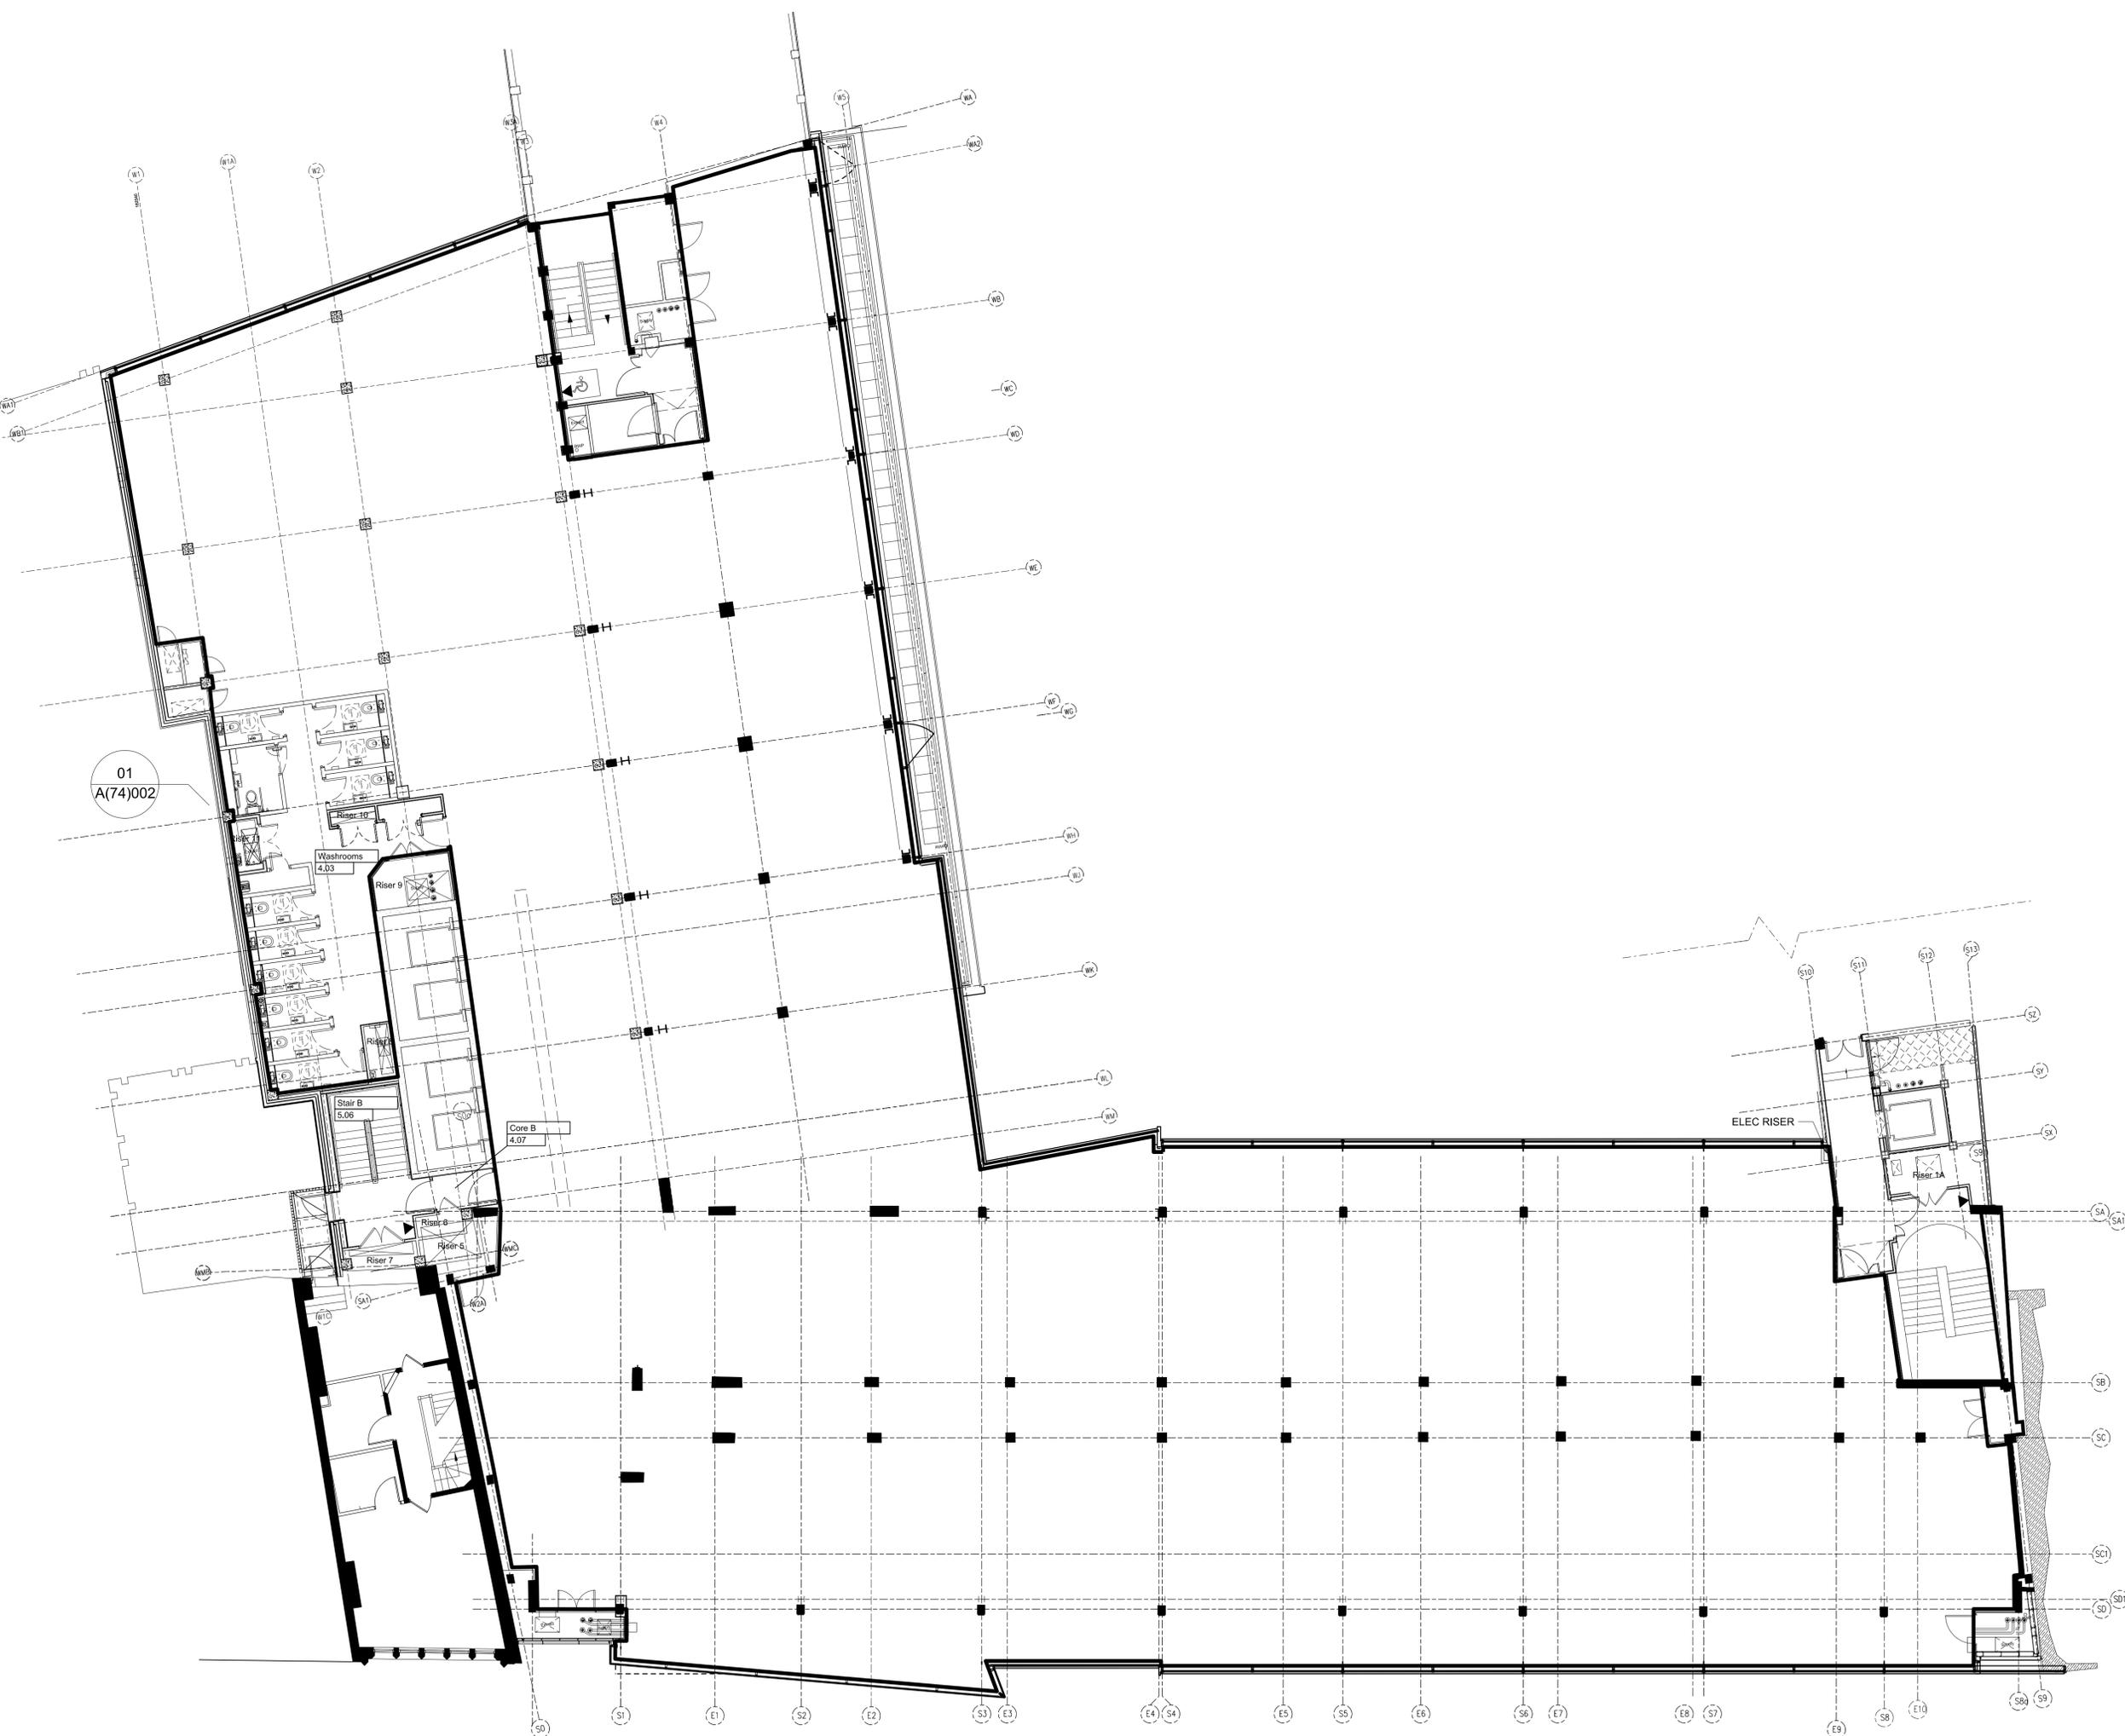

Status	As Built	16-10-19	HD	JP
Rev	Description	Date	Drawn	Checked

RECORD DRAWING

Client:
Success Venture Property Investments Ltd
c/o Helix Property Advisors Ltd

Project:
110 High Holborn

Drawing:
**FOURTH FLOOR PLAN
AS BUILT**

Scale	Drawn	Date	Checked
1:100@A1	HD	16-10-19	JP

Project no.	Dwg	Revision
15289	A-03-114	AB1

tatehindle

TateHindle Limited
1 Lindsey Street
Smithfield
London EC1A 9HP
T 020 7332 4850
mail@tatehindle.co.uk
www.tatehindle.co.uk