





No. 10

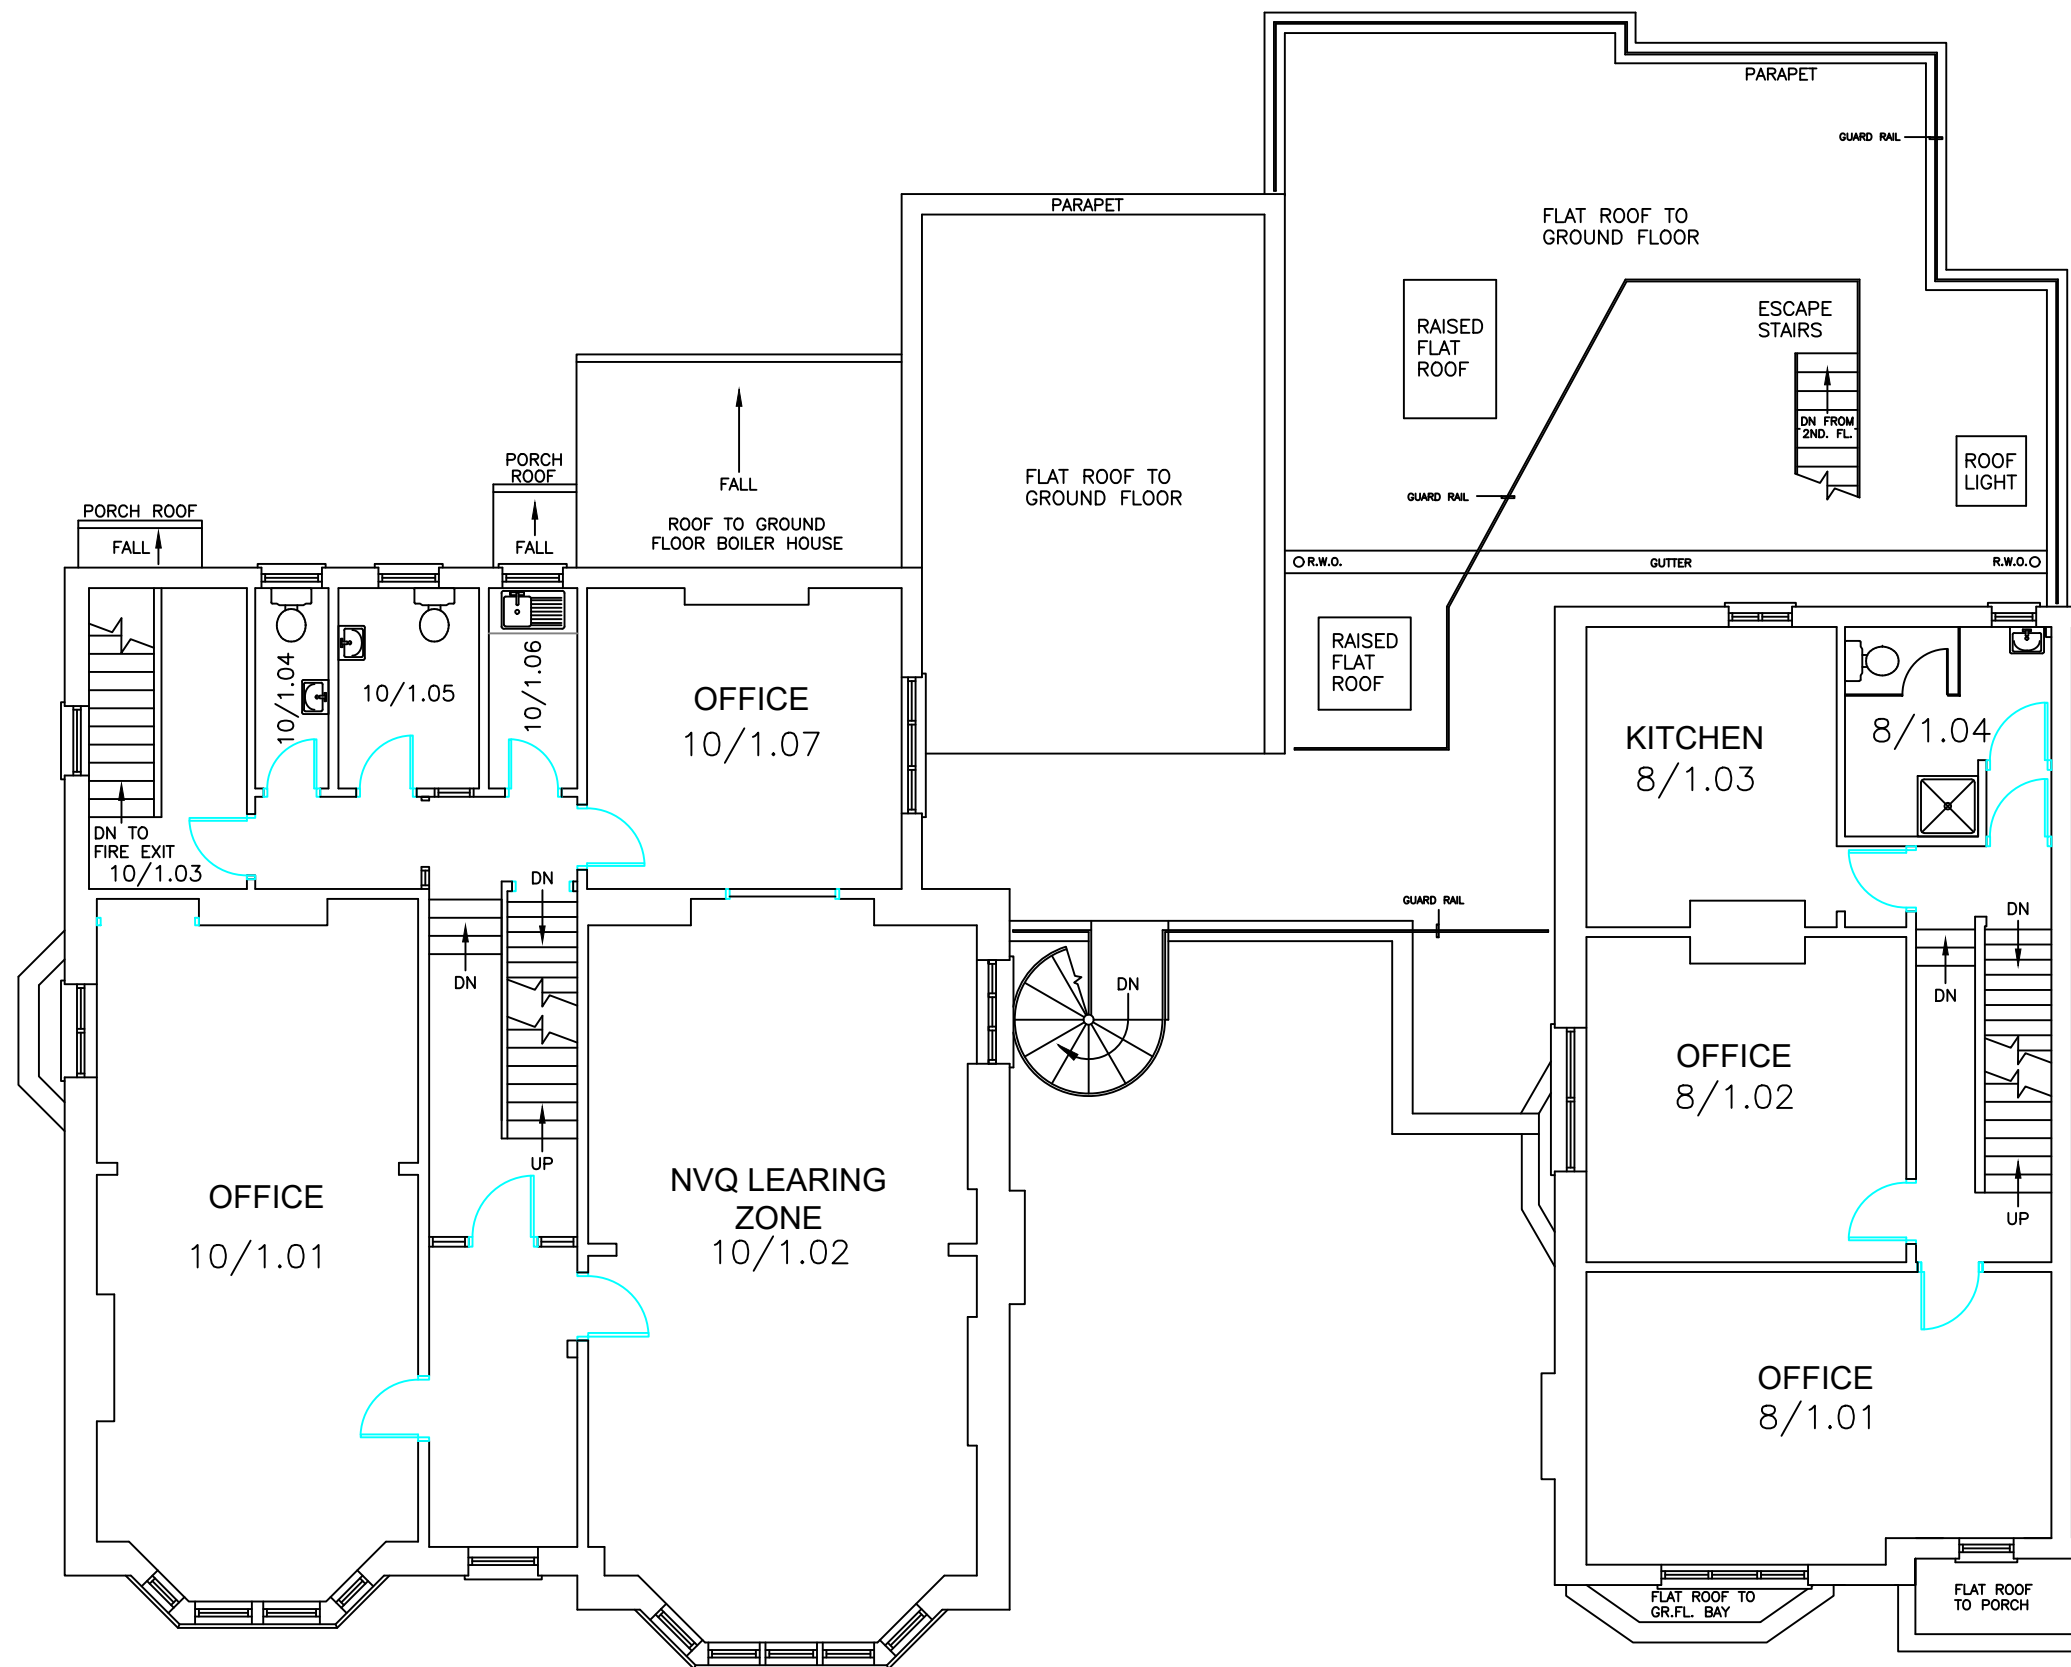

No. 8

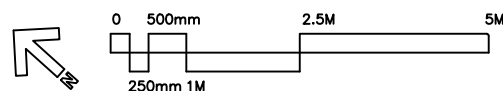

Estates

Title
**Nos. 8 & 10 NORTH ROAD.
FIRST FLOOR PLAN.**


Scale:
1:100\A3 SHEET

Original Layout Drawn:
GPI


Last Revised
Drawn/Date: AI - 29/07/2019

Rec. Drg. No.: AQ\AQ06-07\FP\01

Record Drawing

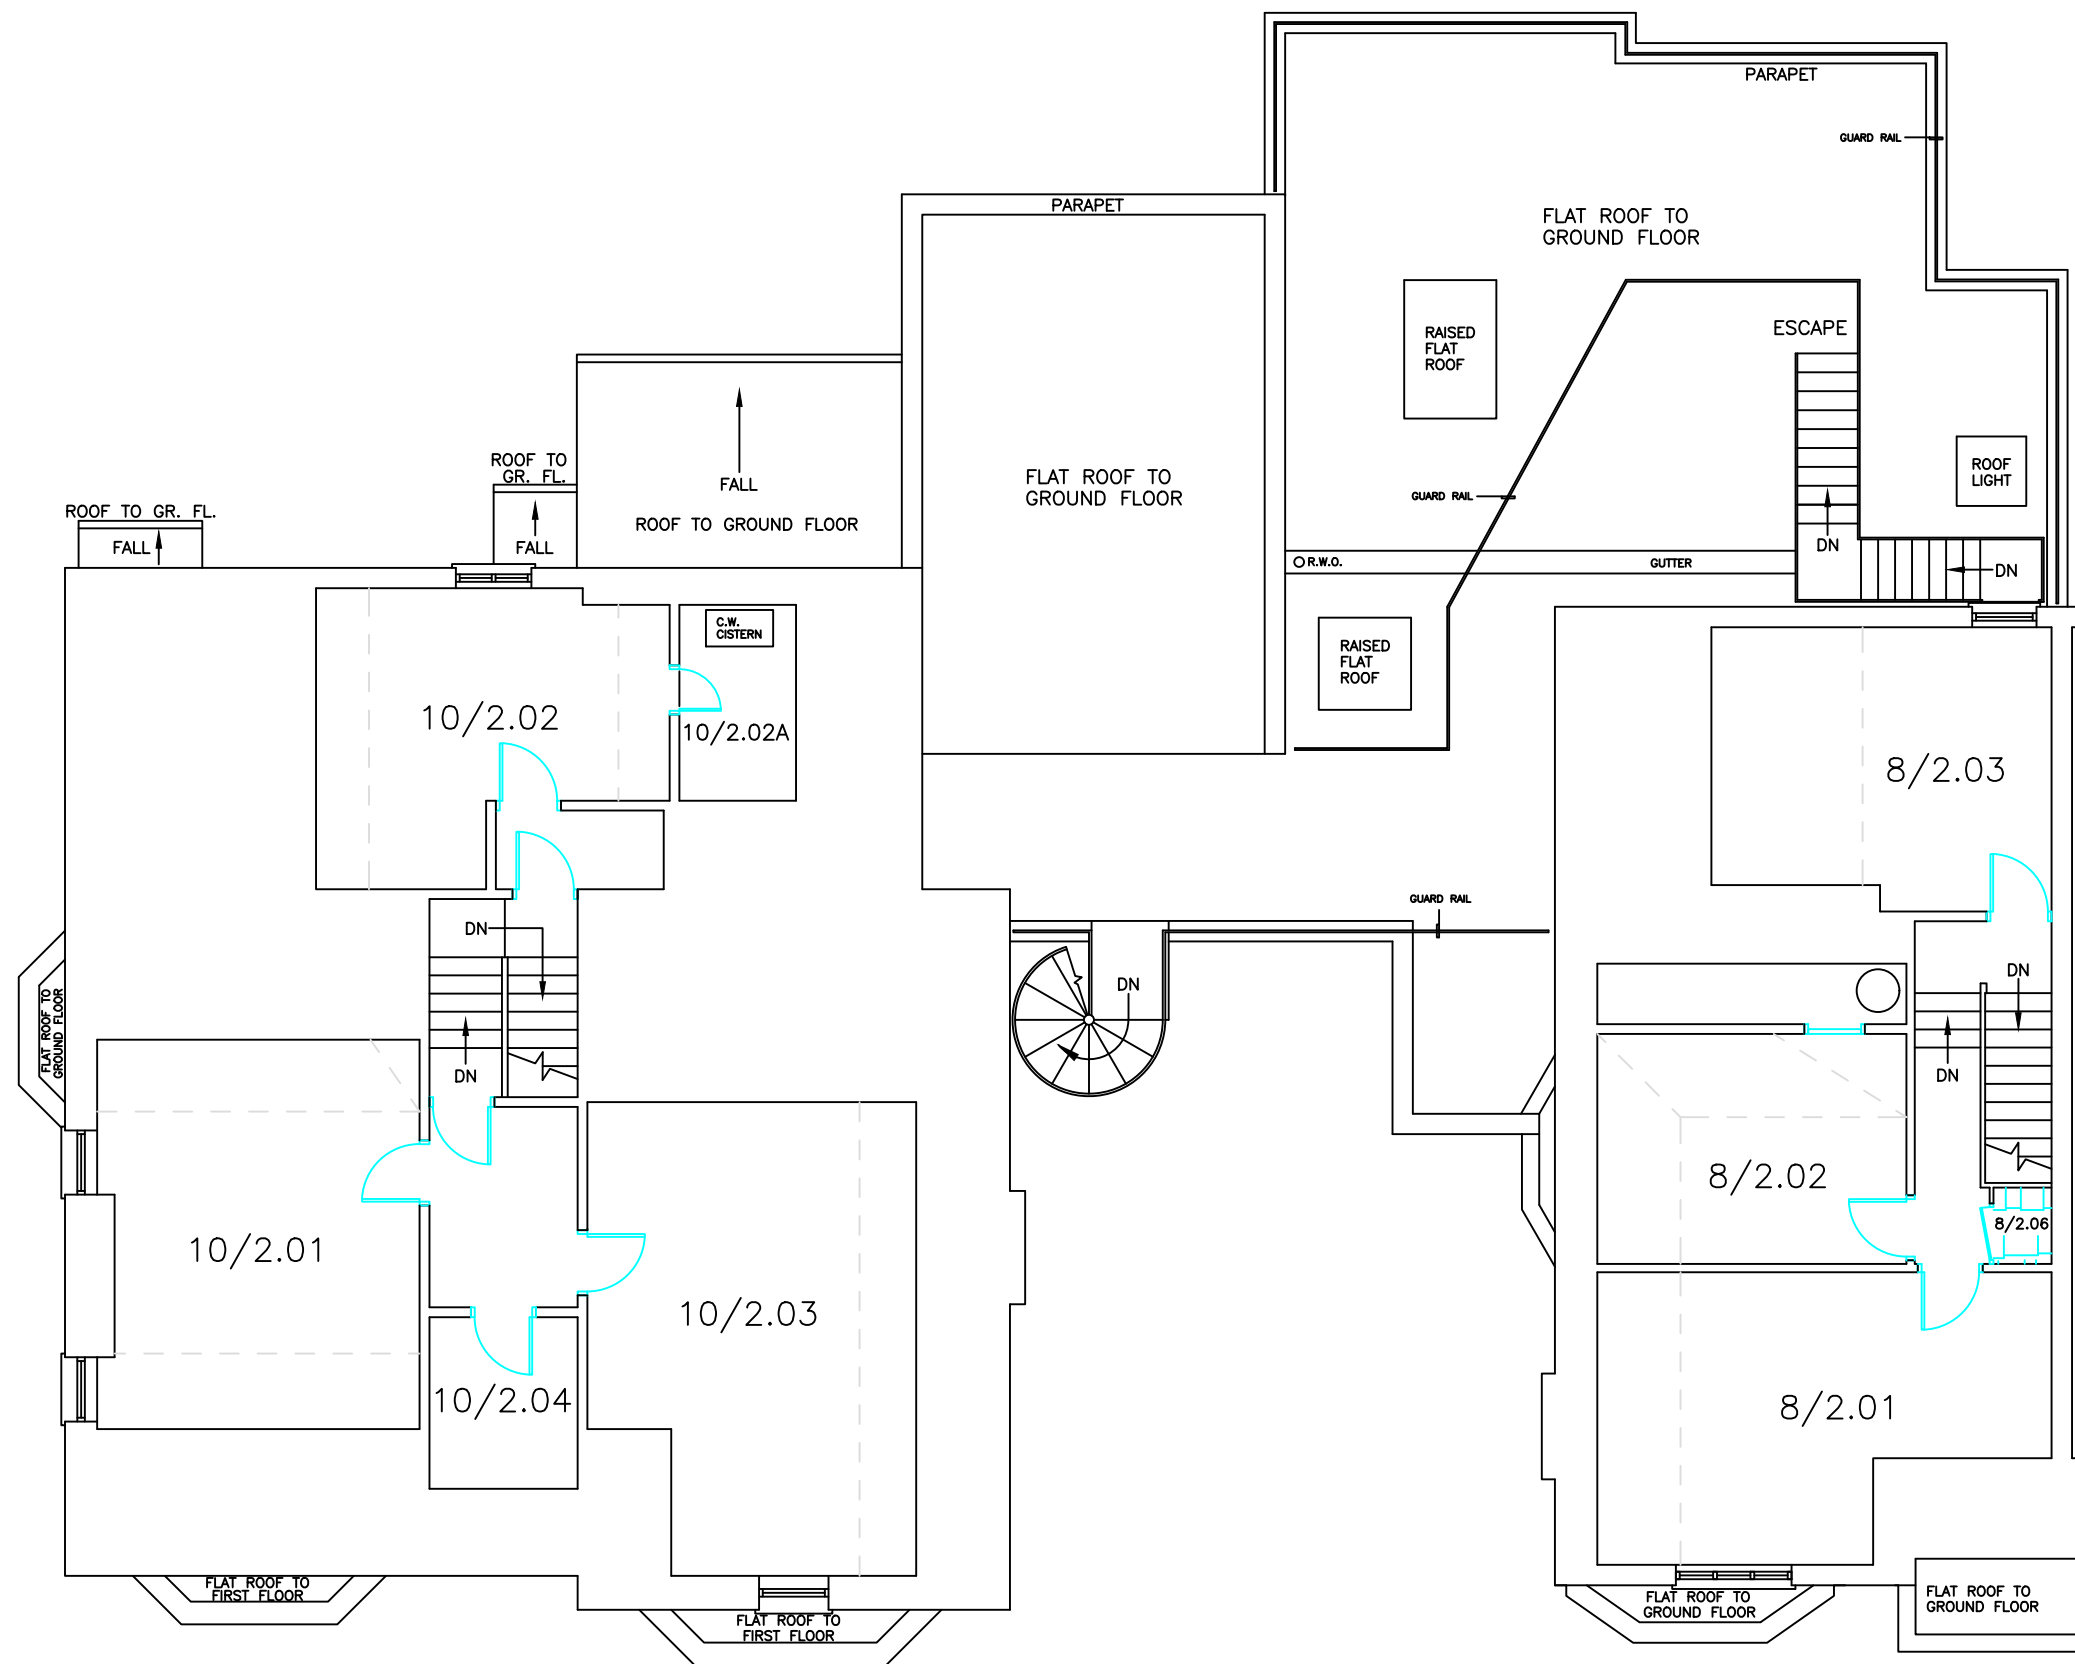

No. 10

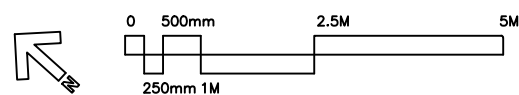

No. 8



Estates

Title
Nos. 8 & 10 NORTH ROAD.
SECOND FLOOR PLAN.


Scale:
1:100\A3 SHEET

Original Layout Drawn:
GPI

Last Revised
Drawn/Date: AI - 29/07/2019

Rec. Drg. No.: AQ\AQ06-07\FP\02



Record Drawing

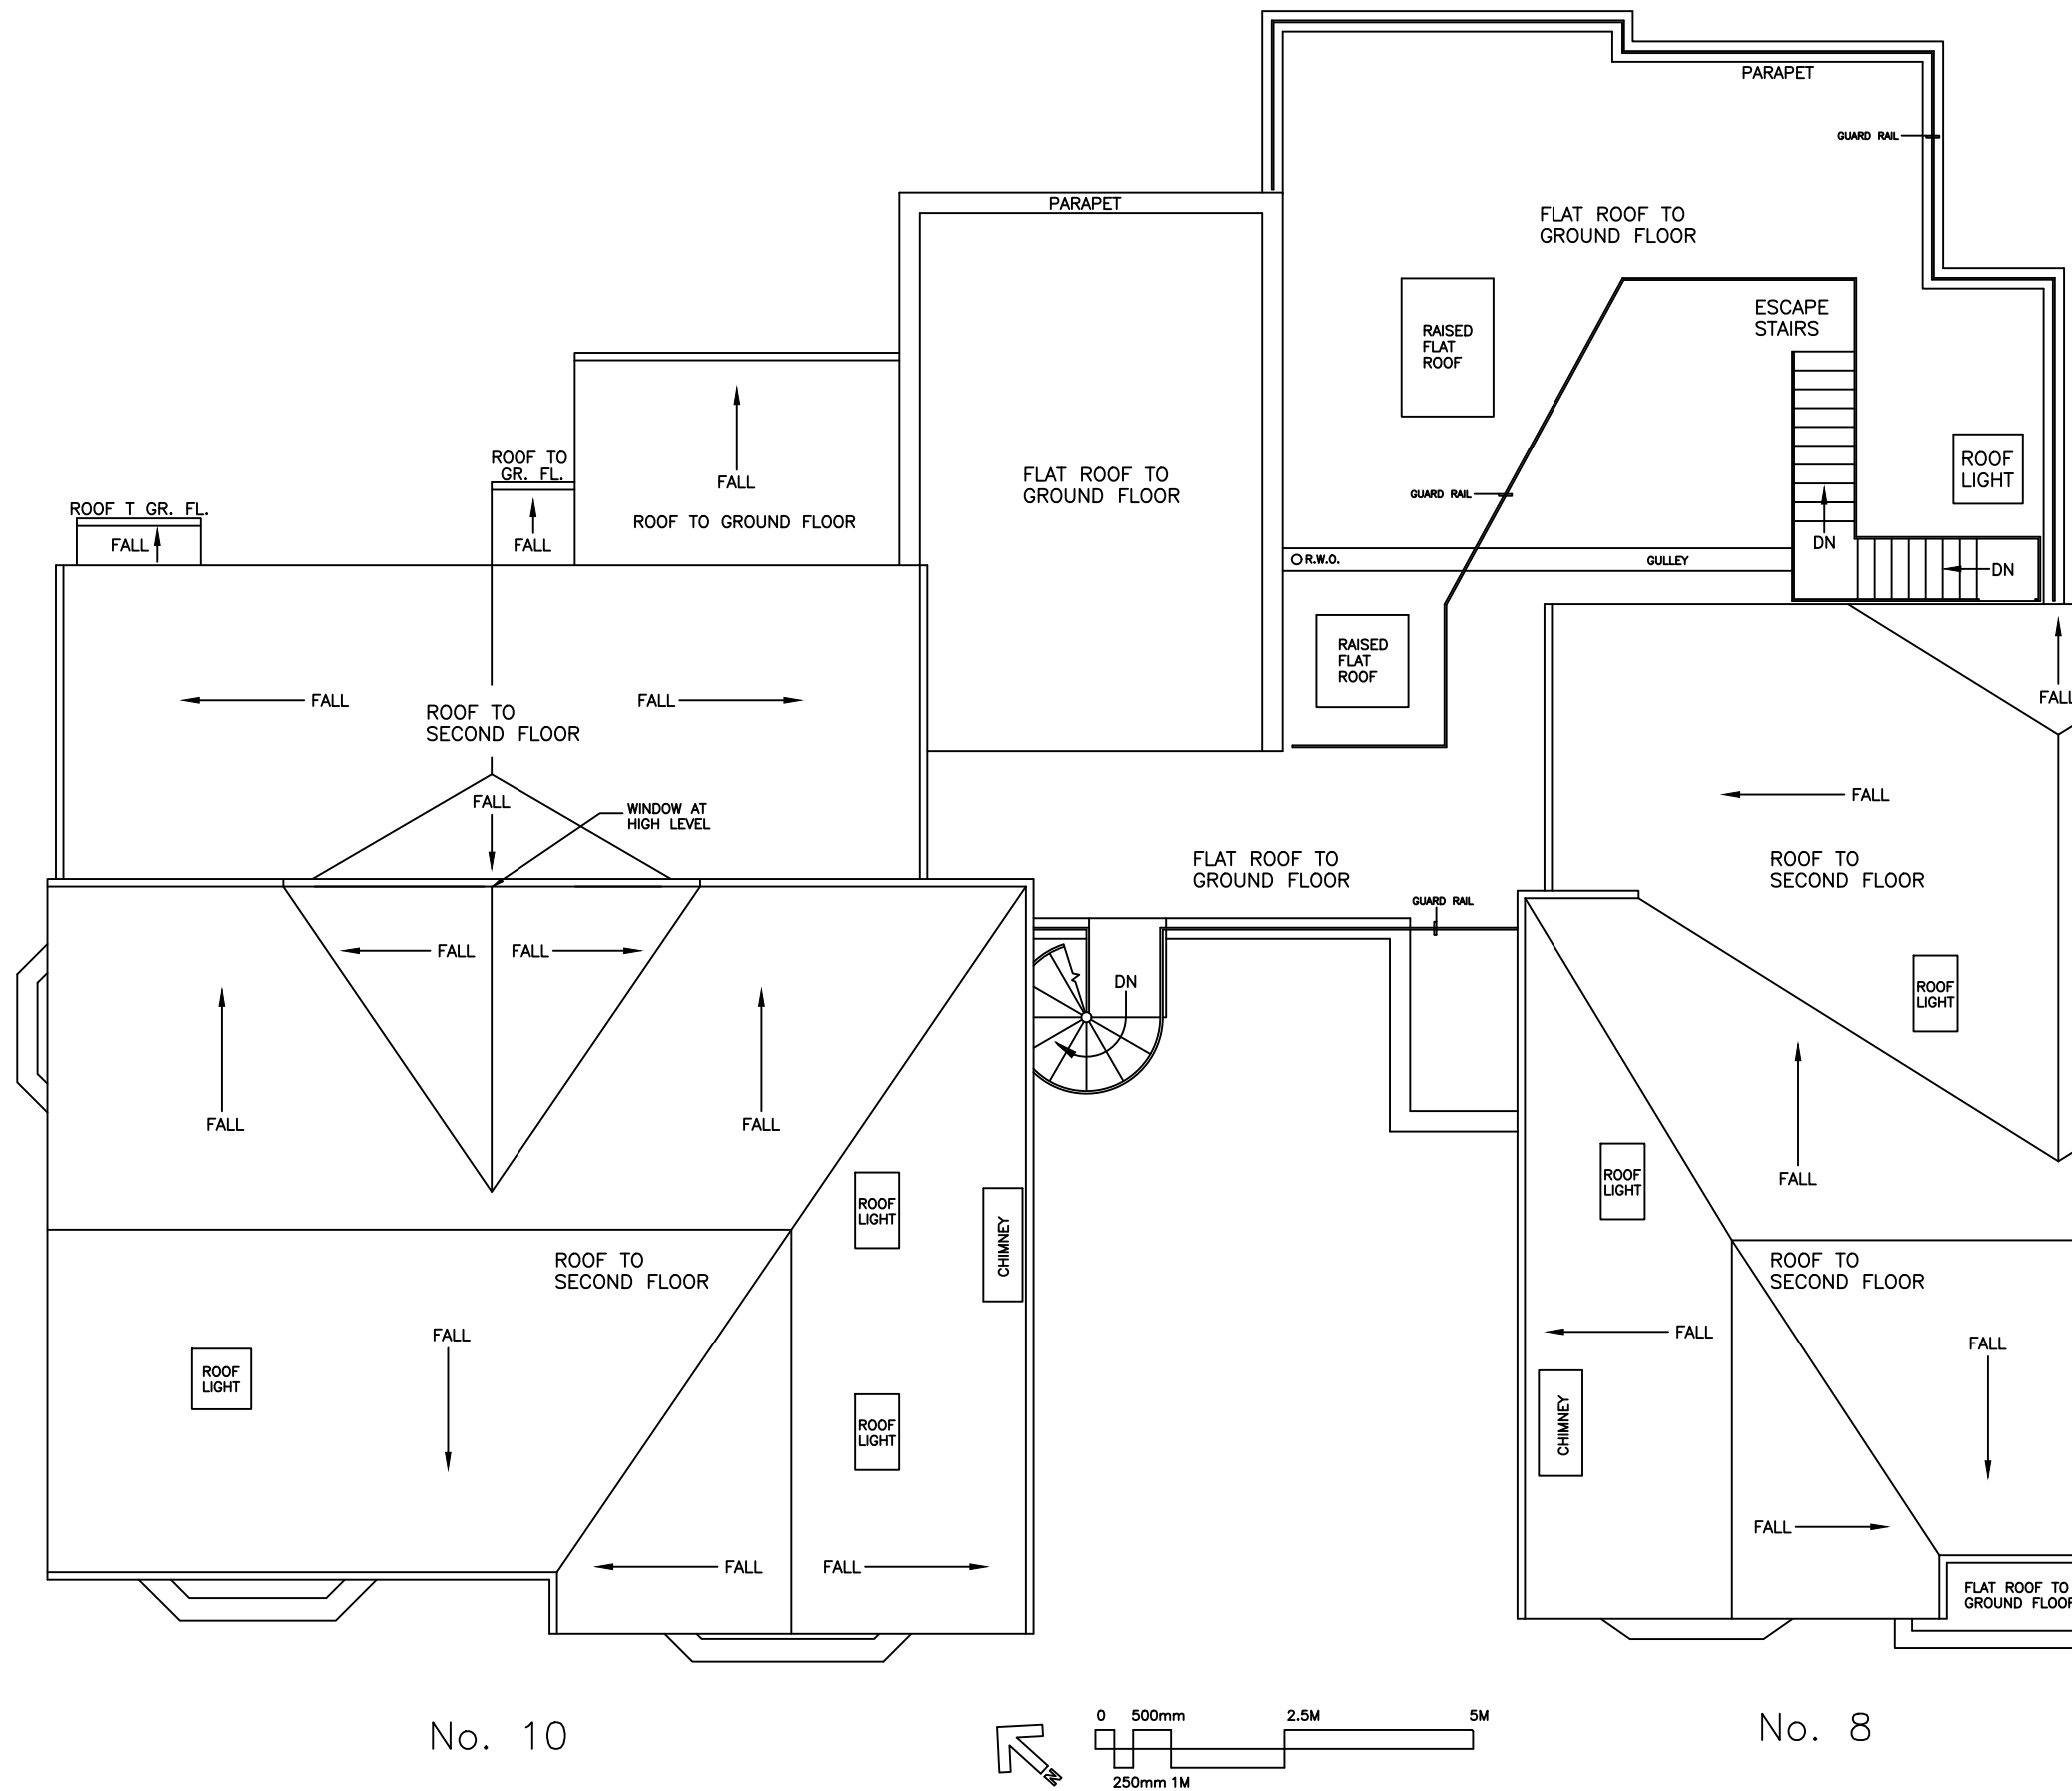


No. 10

No. 8

CARDIFF UNIVERSITY PRIFYSGOL CAERDYDD		Estates	
Title Nos. 8 & 10 NORTH ROAD. ROOF PLAN.			
Scale: 1:100\A3 SHEET		Original Layout Drawn: GPI	
Last Revised Drawn/Date:		AI - 29/07/2019	
Rec. Drg. No.:		AQ\AQ06-07\FP\03R	
Record Drawing			

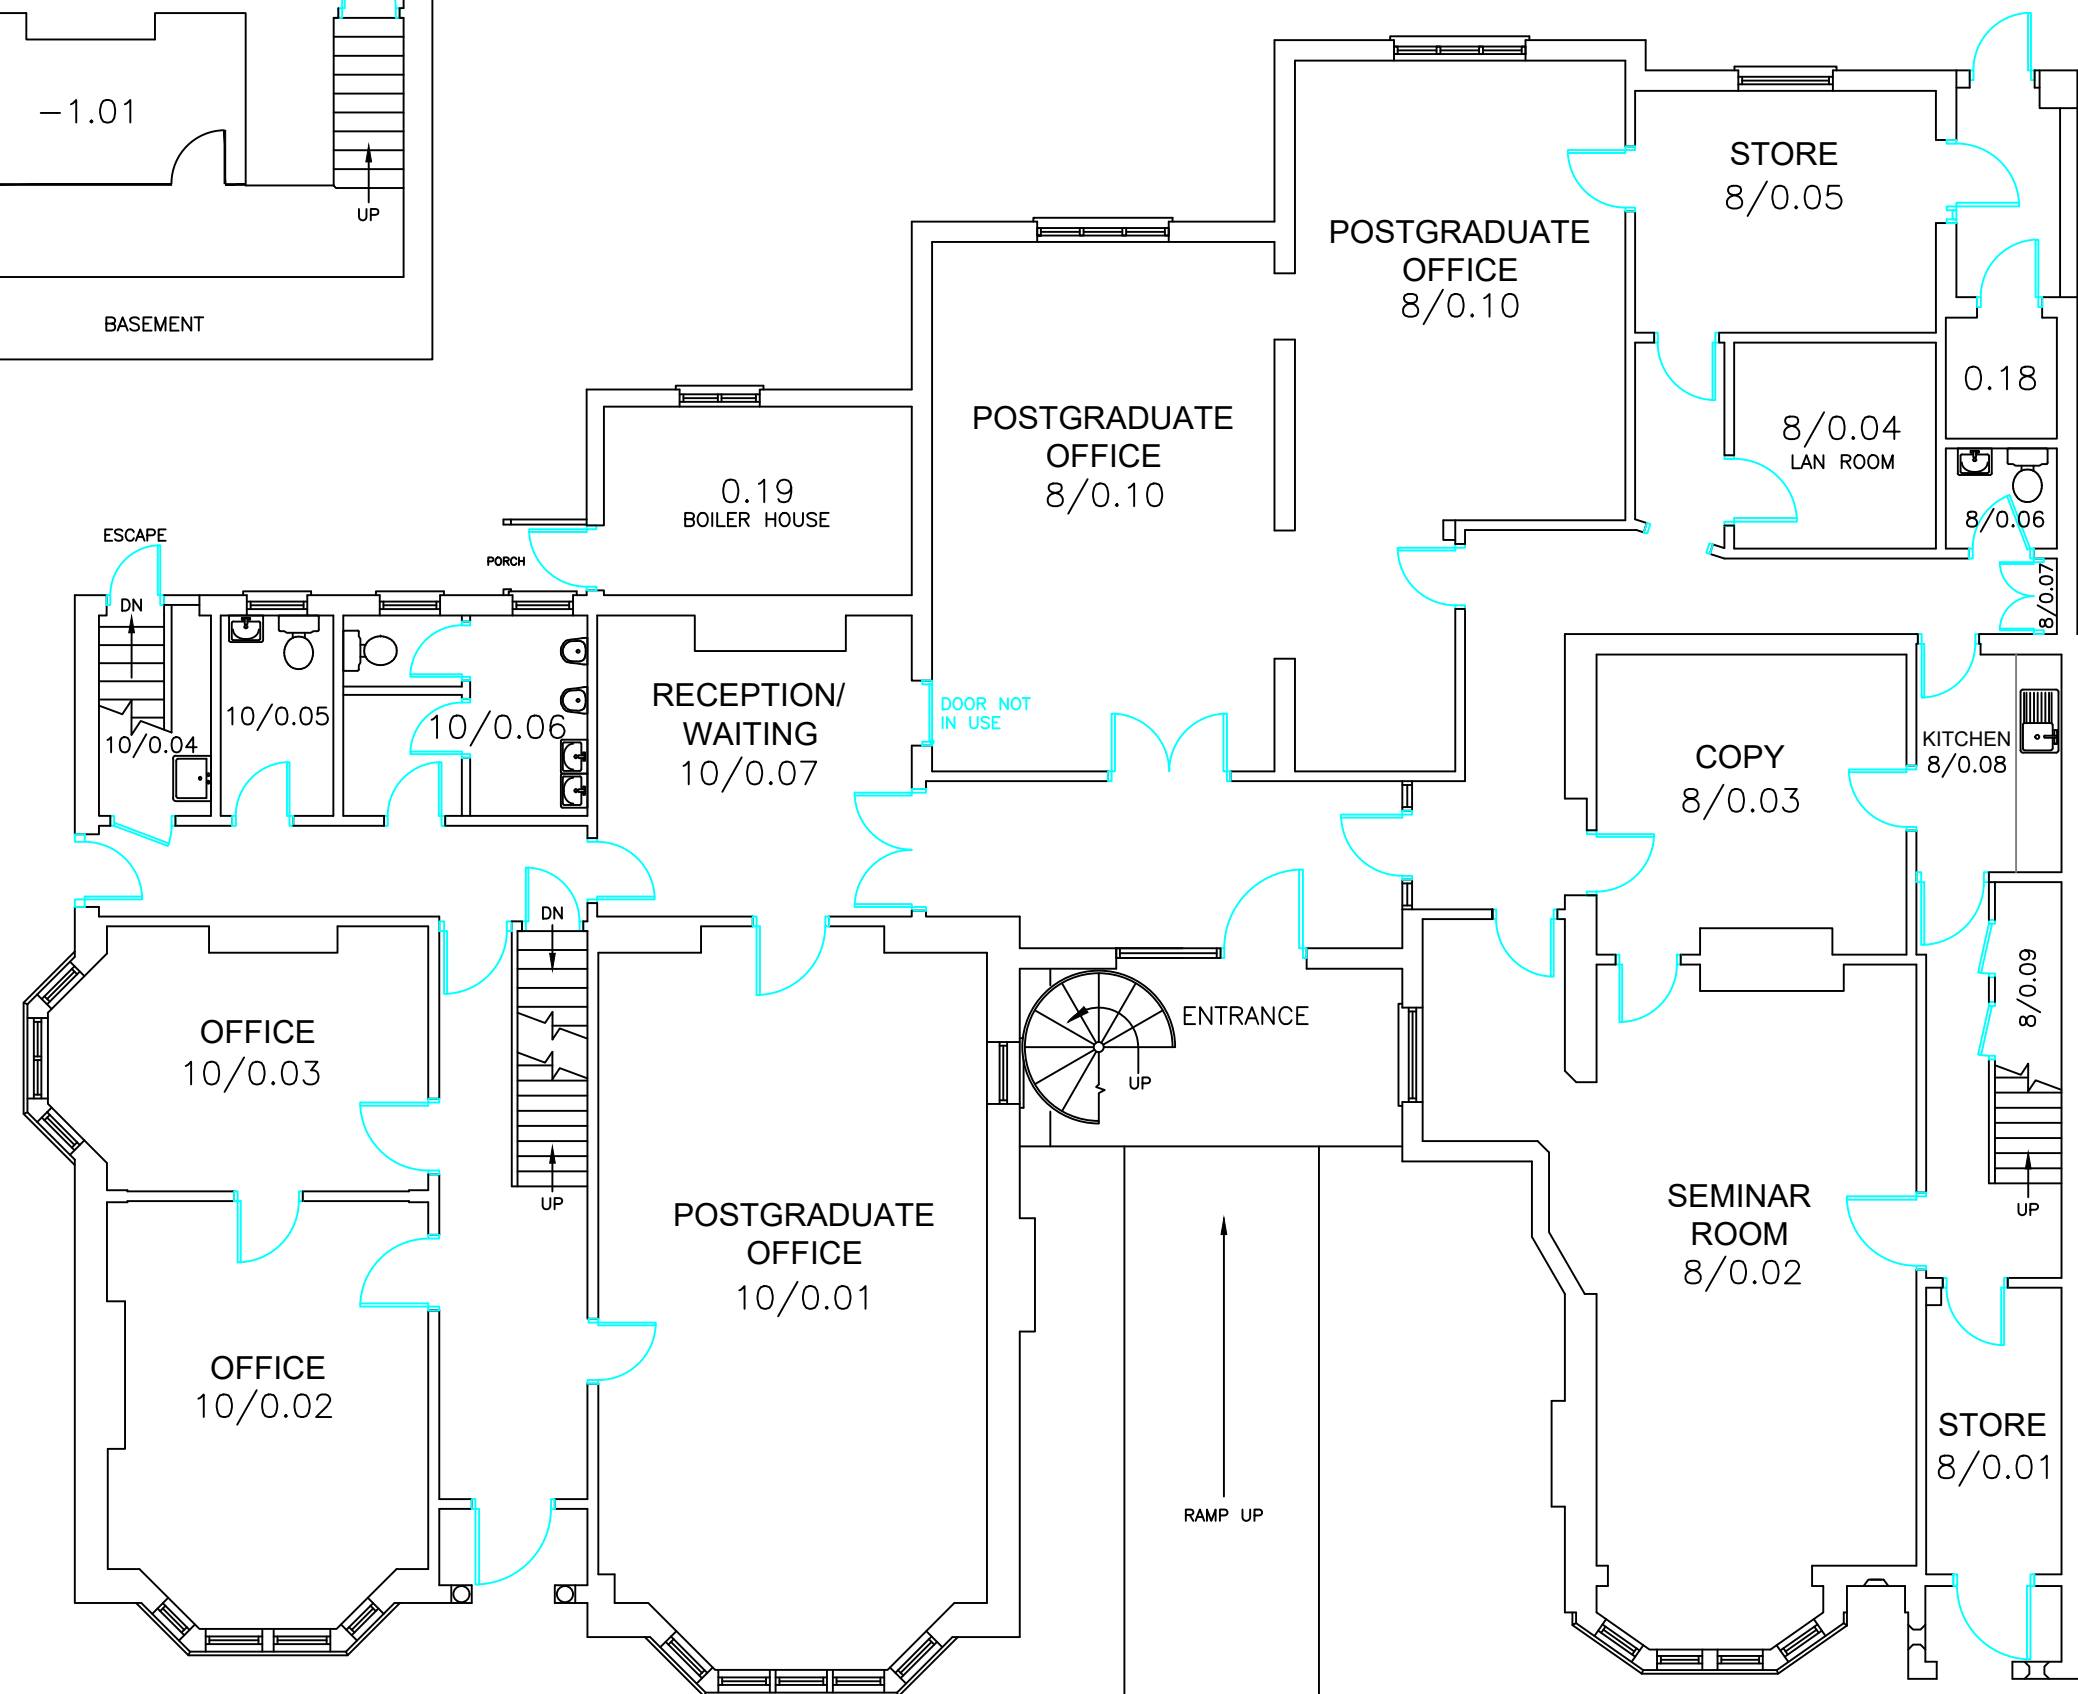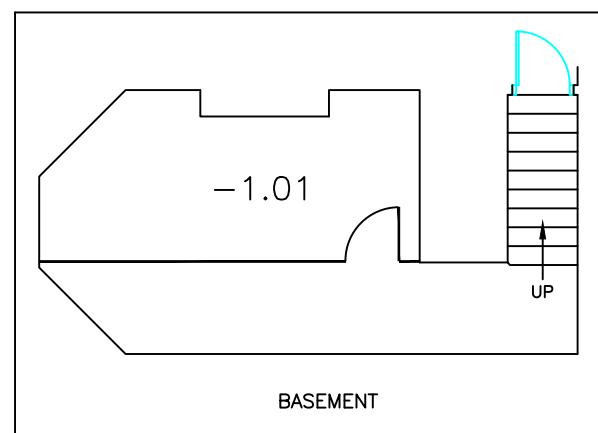

No. 10

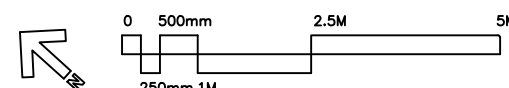

No. 8



Estates

Title
Nos. 8 & 10 NORTH ROAD.
BASEMENT AND GROUND
FLOOR PLAN.

Scale:
1:100\A3 SHEET

Original Layout Drawn:
GPI

Last Revised
Drawn/Date: AI - 29/07/2019

Rec. Drg. No.: AQ\AQ06-07\FP\ -1_00

Record Drawing