


CLIENT APPROVAL

Signature
 Print Name
 Date

PROPOSAL	
INFORMATION	
CONSTRUCTION	
AS BUILT	✓

REVISIONS

DESCRIPTION	DATE	DRN	SEC
As Issued	11/11/16		

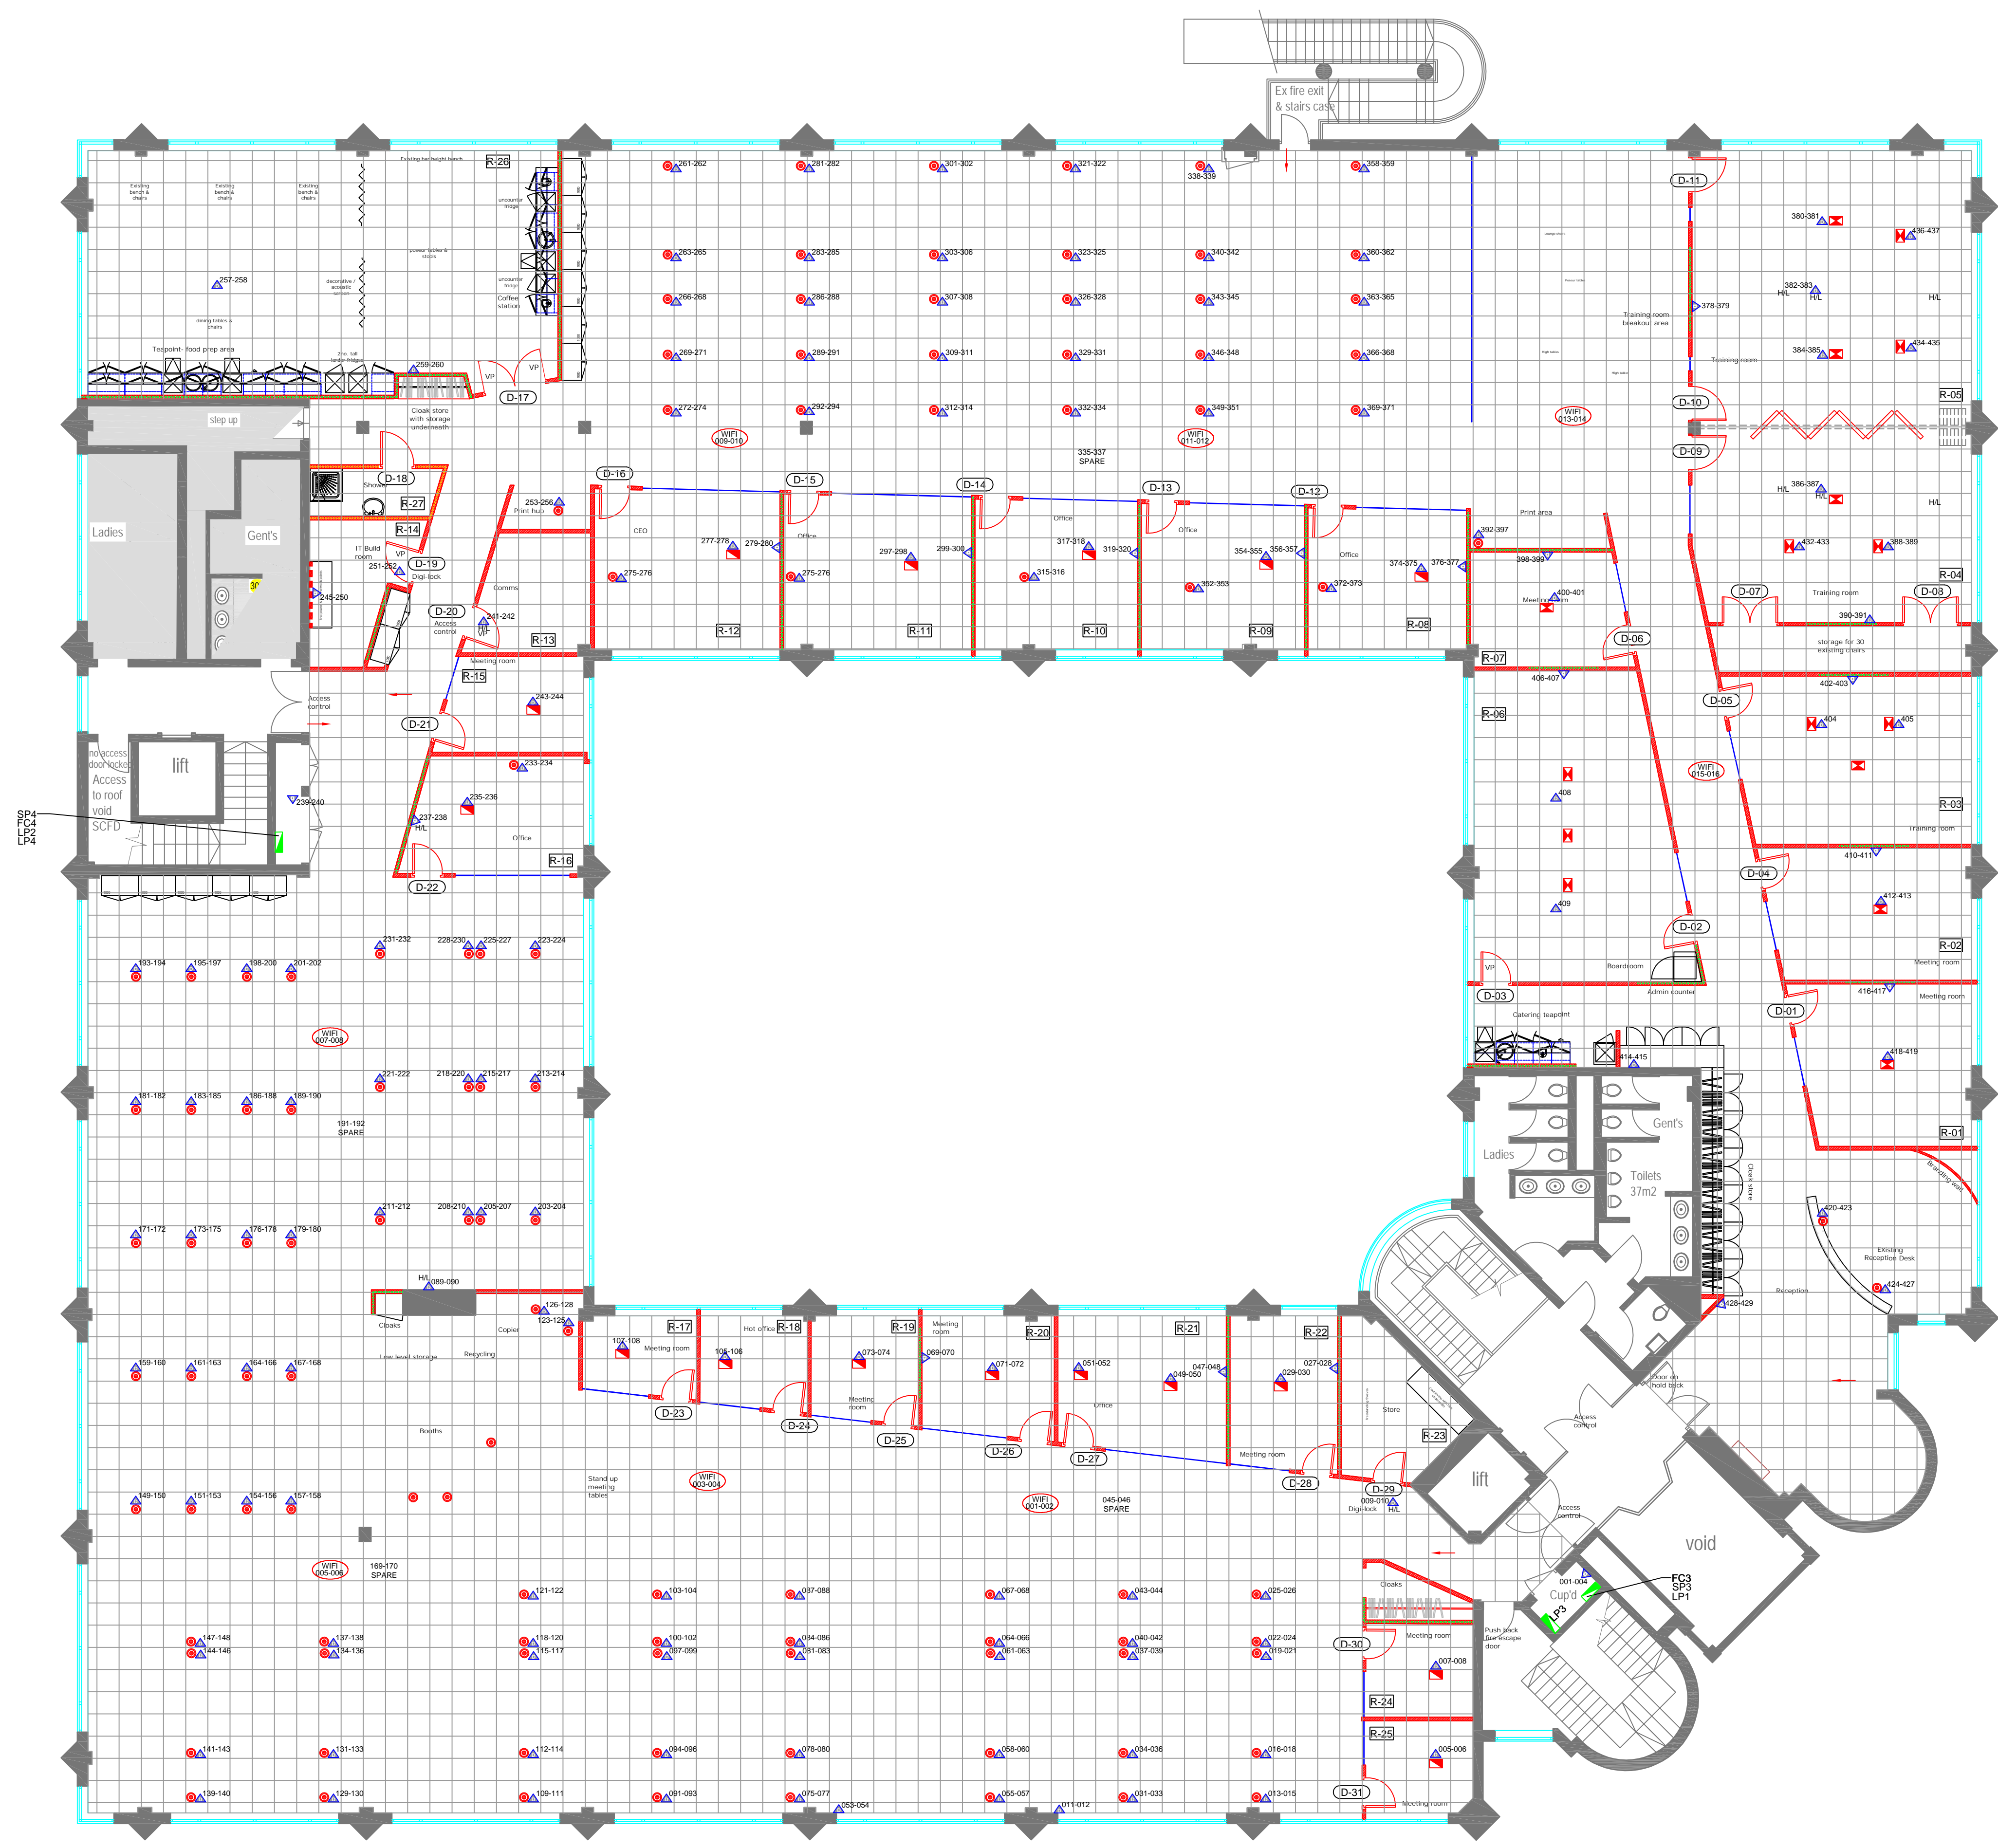

LEGEND

- DOUBLE SWITCHED SOCKET OUTLET
- CLEANERS DOUBLE SWITCHED SOCKET OUTLET
- SINGLE SWITCHED SOCKET OUTLET
- SWITCHED FUSED SPUR
- 16amp COMMANDO SOCKET
- CAR CHARGER
- UNDER FLOOR BUS BAR
- DADO TRUNKING
- WALL MOUNTED DATA OUTLETS. 'N' DENOTES QUANTITY OF POINTS
- WIFI POINT
- FLOOR GROMMET
- 4 COMPARTMENT FLOOR BOX COMPRISING OF 2 x DOUBLE SWITCHED SOCKET OUTLETS & 2 x DATA OUTLETS & 2 x AV
- 3 COMPARTMENT FLOOR BOX COMPRISING OF 2 x DOUBLE SWITCHED SOCKET OUTLETS & 1 x DATA OUTLETS

SCALE
 100
 100
 FLOOR BOXES TO BE CUT INTO FLOOR TILES



CLIENT: Bibby
 Pembroke House
 PROJECT: First Floor
 DRAWING: Data Outlet Locations
 DATE: 04/11/16 SCALE: 1:100@A1
 DRG No: SEC-7726-DA-03
 Revision: As Built

SECURE SYSTEMS (UK) LTD
 Unit F
 Castle Industrial Park
 Newbury
 Berkshire, RG14 2EZ
 Tel. 01635 32211

All dimensions to be verified on site. This design and the drawings together with the information contained herein are copyright and may not be reproduced in part nor in whole without the prior written permission of SECURE SYSTEMS (UK) LTD.